


RE: Tahoma Engineered Solutions  
Report  
Lead Mapping  
Drinking Water Program  
Ashland County  
PWS ID: OH0337412

RECEIVED

APR 16 2019

DDAGW - NWDO

Tohoma Engineered Solutions  
532 County Road 1600 Ashland, Ohio 44805  
Phone 419-496-0964  
Water Distribution sampling points lead and Copper

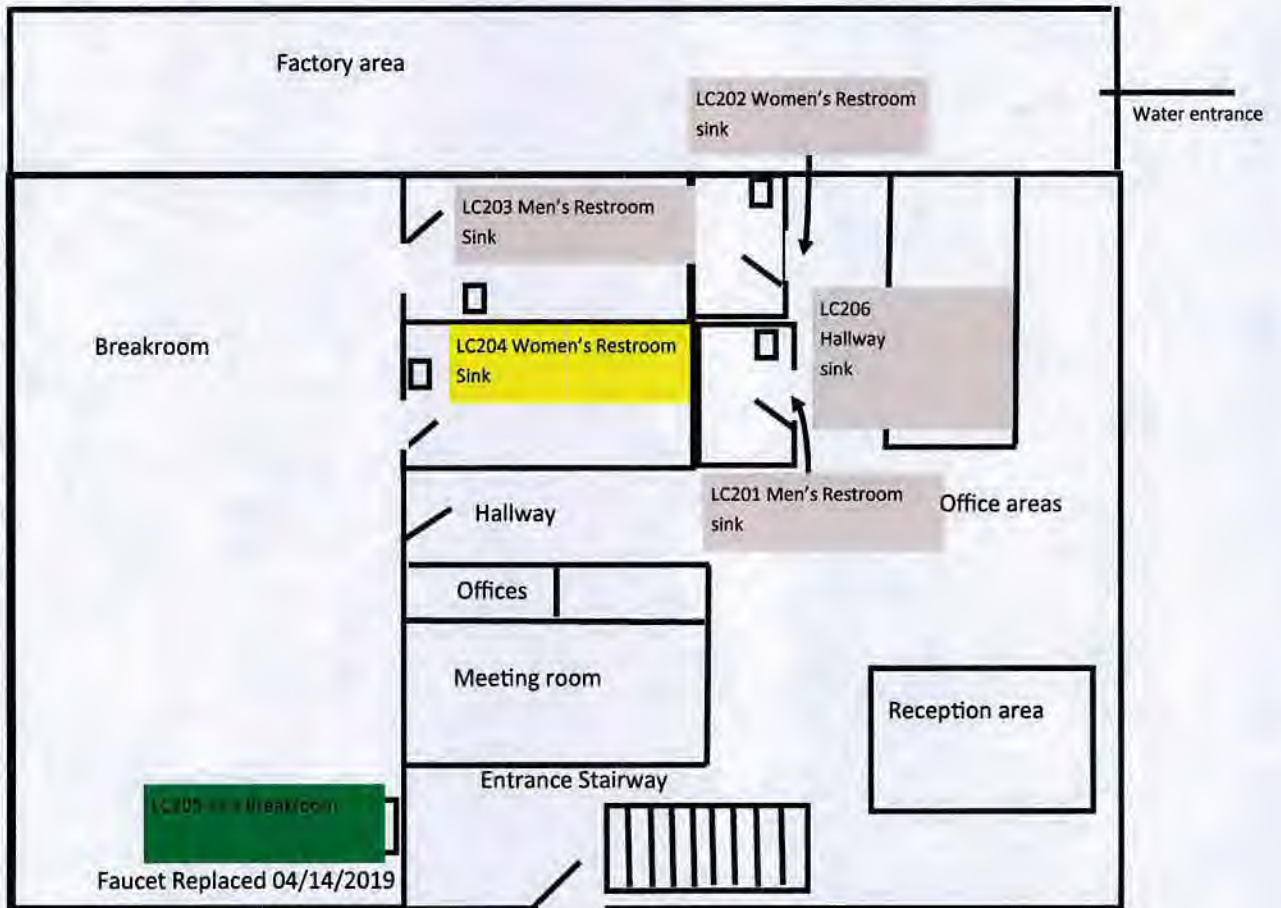

County Road 1600

- LC201 Men's restroom 1
- LC202 Women's restroom 1
- LC203 Men's restroom 2
- LC204 Women's restroom 2
- LC205 Sink Break room
- LC206 Sink hallway off offices

**Colors**

- Lead =
- Non-Lead =
- No Information =

Parks Water Services LLC  
Tohoma Engineered Solutions