

Well Well Casing size 5 inch 30 gpm


MPW Corporate Building

PWS OH4564512

9711 Lancaster Road SE, Hebron, OH 43025

800-827-8790


PWS OH4564512 consist of an individual building on the MPW Industrial Services campus- the Corporate Building (2 stories).

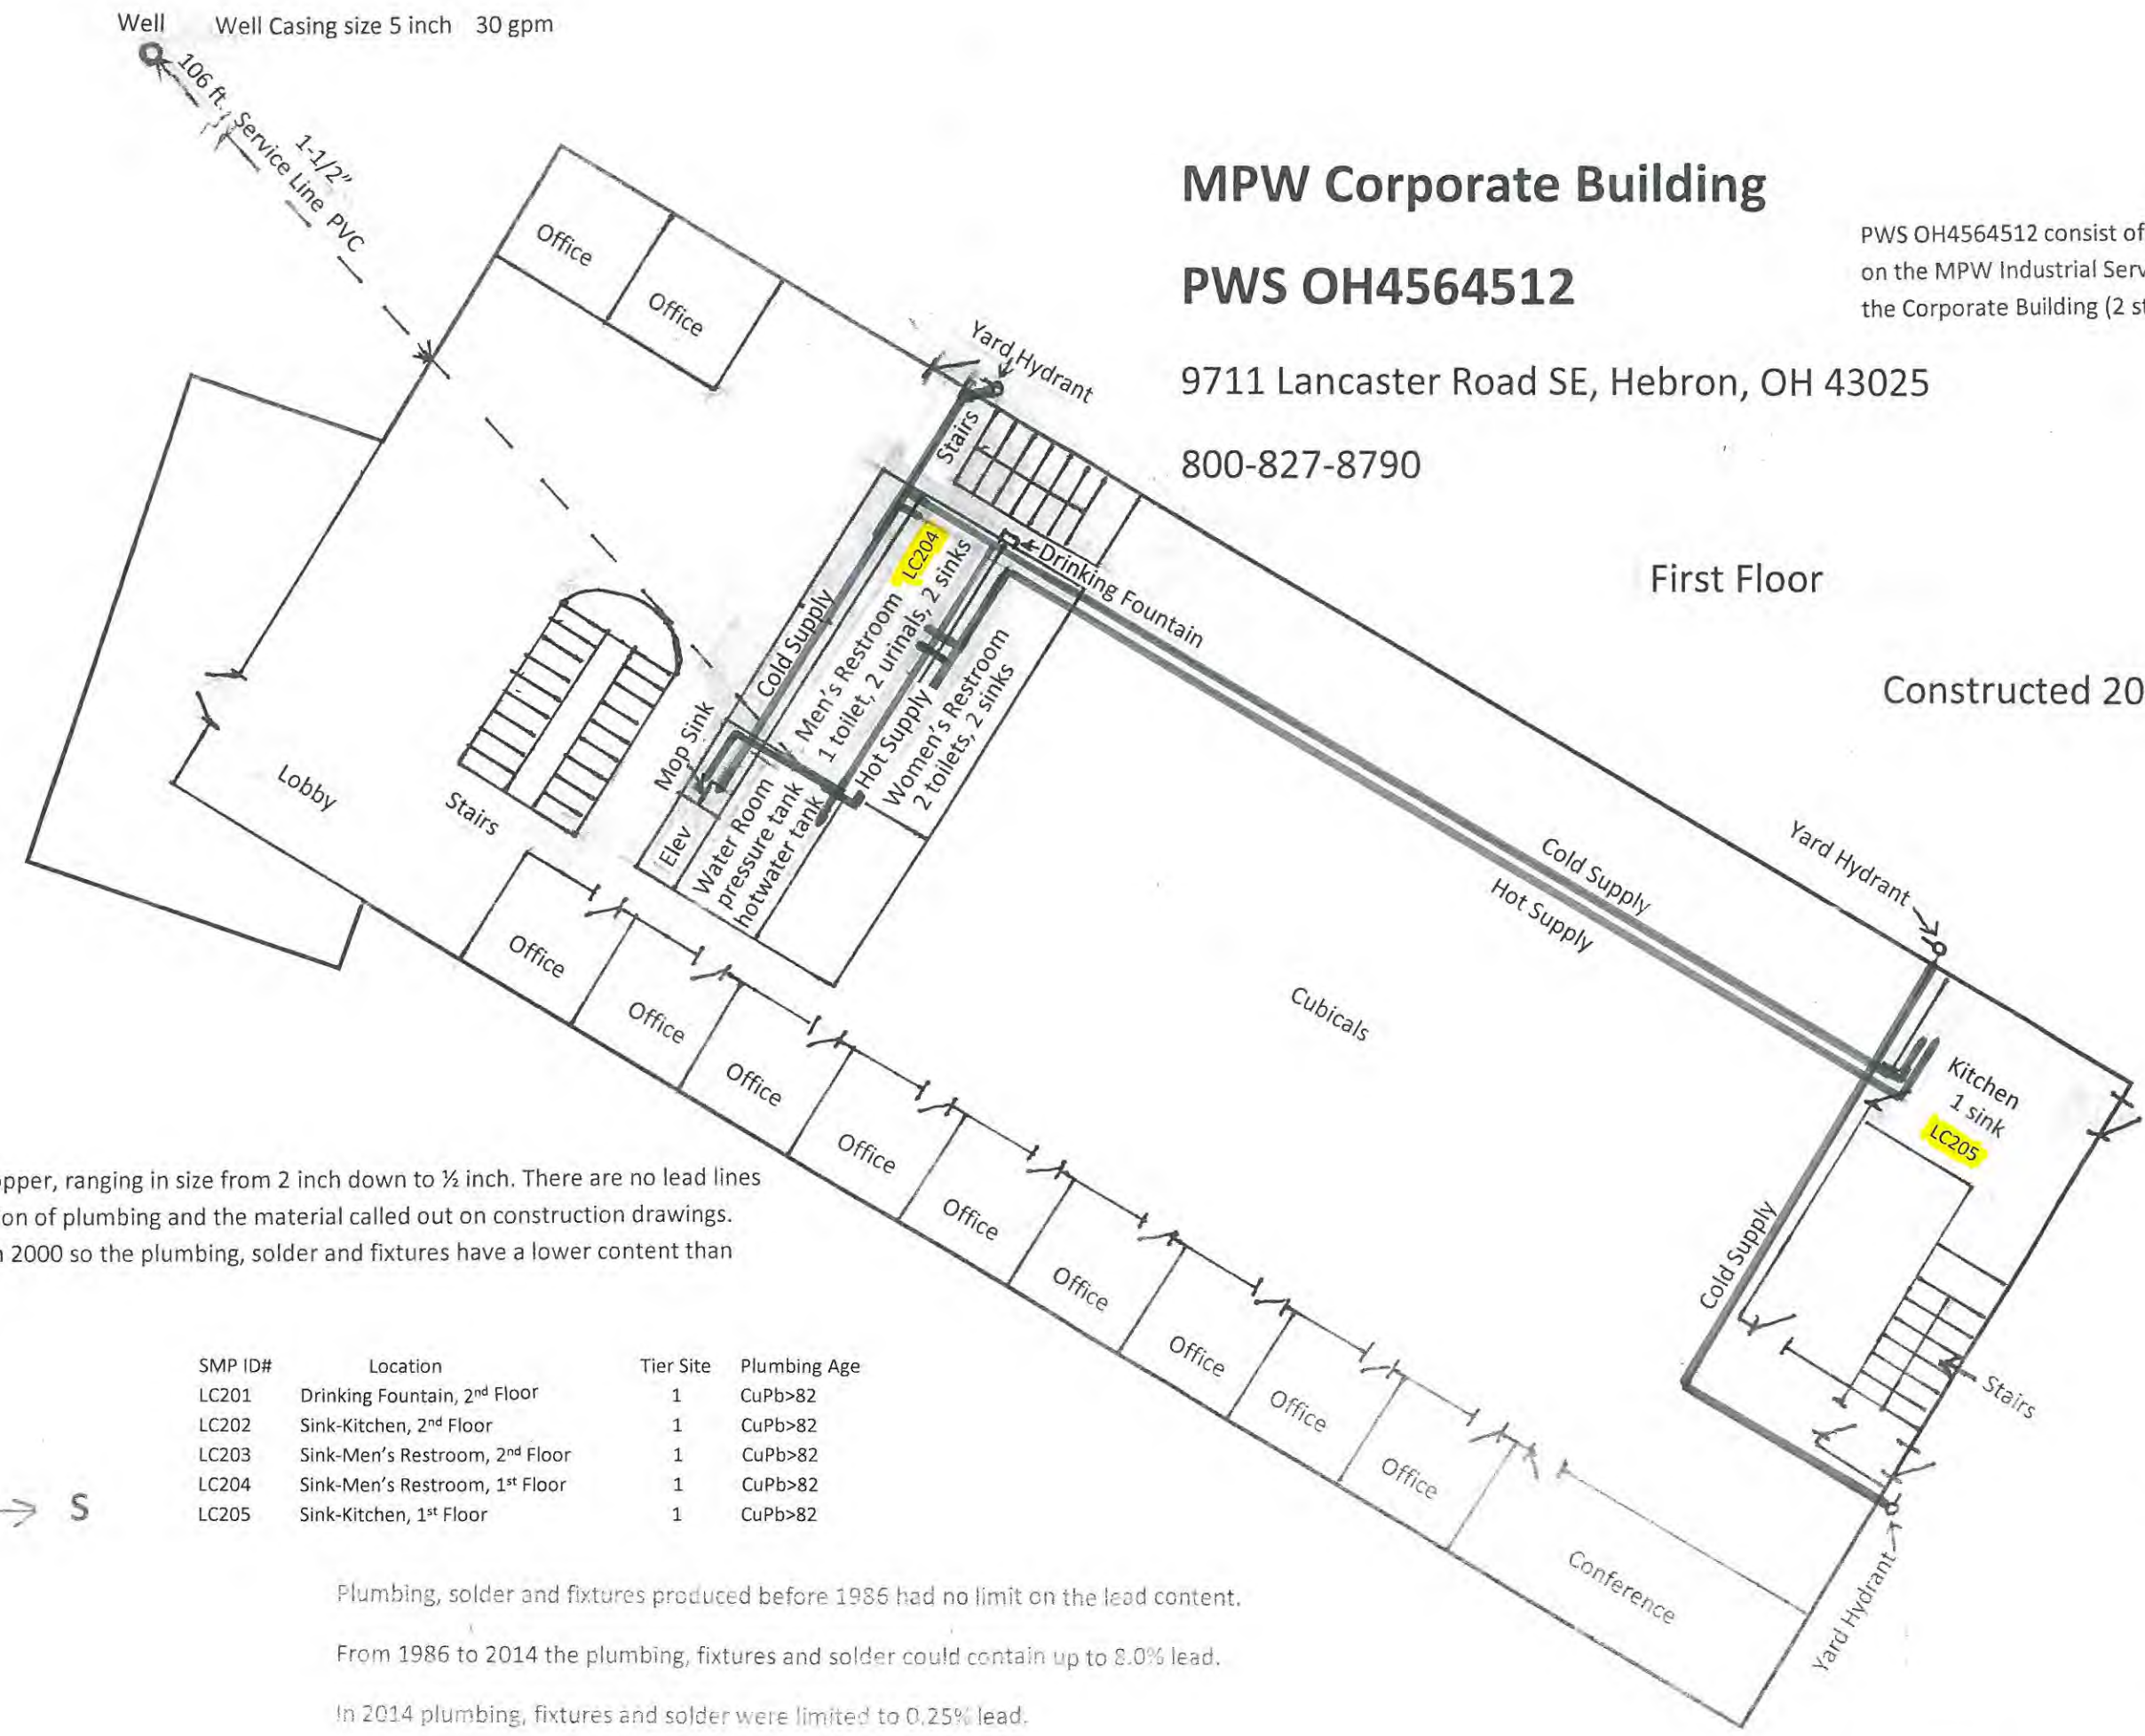

First Floor

Constructed 2000

All plumbing supply lines are copper, ranging in size from 2 inch down to 1/2 inch. There are no lead lines in the system based on inspection of plumbing and the material called out on construction drawings. The building was constructed in 2000 so the plumbing, solder and fixtures have a lower content than those produced before 1986.

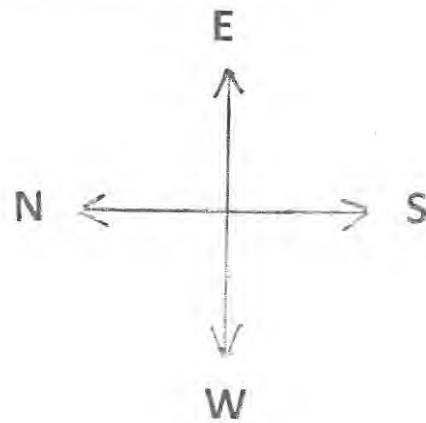


SMP ID#	Location	Tier Site	Plumbing Age
LC201	Drinking Fountain, 2 nd Floor	1	CuPb>82
LC202	Sink-Kitchen, 2 nd Floor	1	CuPb>82
LC203	Sink-Men's Restroom, 2 nd Floor	1	CuPb>82
LC204	Sink-Men's Restroom, 1 st Floor	1	CuPb>82
LC205	Sink-Kitchen, 1 st Floor	1	CuPb>82

Plumbing, solder and fixtures produced before 1986 had no limit on the lead content.
 From 1986 to 2014 the plumbing, fixtures and solder could contain up to 8.0% lead.
 In 2014 plumbing, fixtures and solder were limited to 0.25% lead.

Plumbing Lines Color Scheme

- Lead █
- No Lead █
- No Information █

Scale

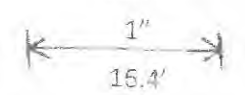

Map Current for 2019

MPW Corporate Building

PWS OH4564512


PWS OH4564512 consist of an individual building on the MPW Industrial Services campus- the Corporate Building (2 stories).

9711 Lancaster Road SE, Hebron, OH 43025

800-827-8790

2nd Floor

Constructed 2000

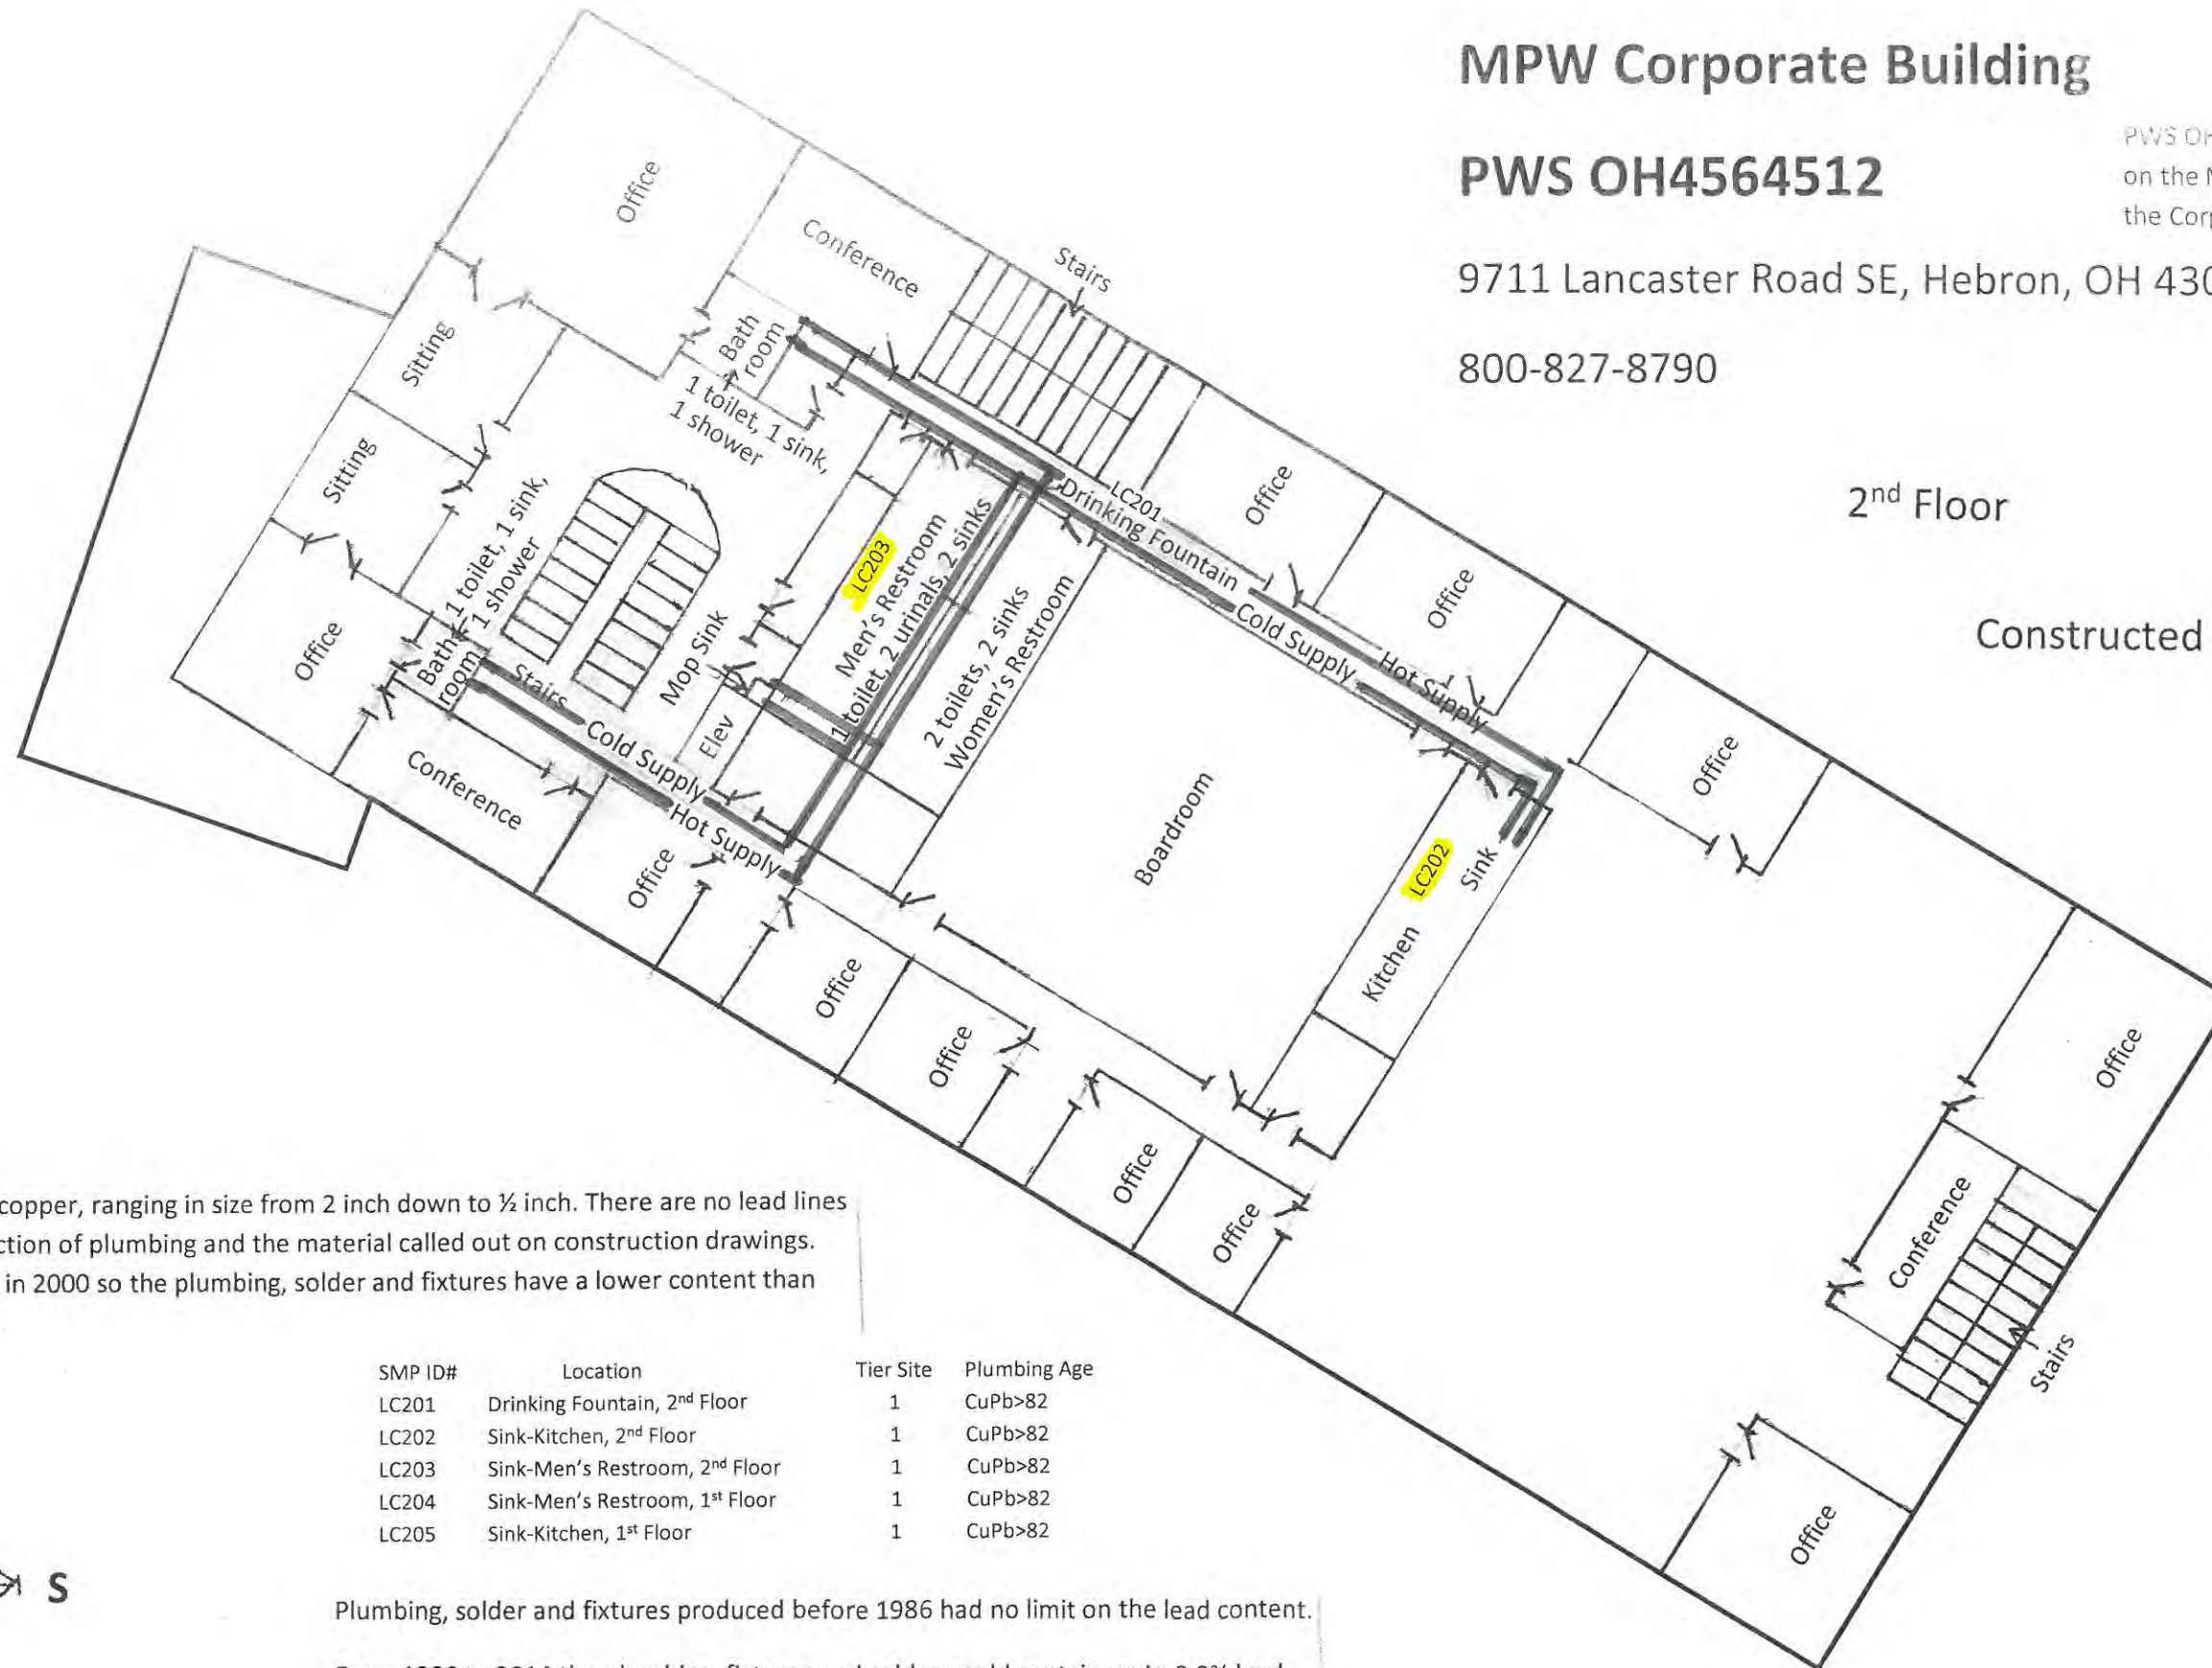

All plumbing supply lines are copper, ranging in size from 2 inch down to 1/2 inch. There are no lead lines in the system based on inspection of plumbing and the material called out on construction drawings. The building was constructed in 2000 so the plumbing, solder and fixtures have a lower content than those produced before 1986.

SMP ID#	Location	Tier Site	Plumbing Age
LC201	Drinking Fountain, 2 nd Floor	1	CuPb>82
LC202	Sink-Kitchen, 2 nd Floor	1	CuPb>82
LC203	Sink-Men's Restroom, 2 nd Floor	1	CuPb>82
LC204	Sink-Men's Restroom, 1 st Floor	1	CuPb>82
LC205	Sink-Kitchen, 1 st Floor	1	CuPb>82


Plumbing, solder and fixtures produced before 1986 had no limit on the lead content.

From 1986 to 2014 the plumbing, fixtures and solder could contain up to 8.0% lead.

In 2014 plumbing, fixtures and solder were limited to 0.25% lead.

Plumbing Lines Color Scheme

- Lead █
- No Lead █
- No Information █

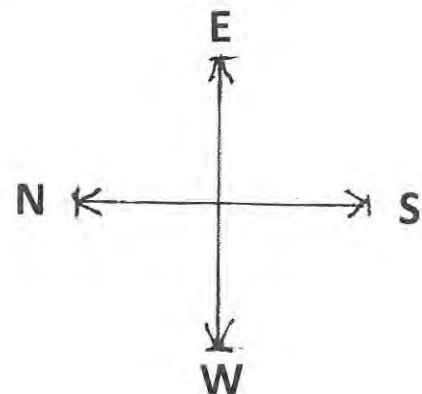

Map Current for 2019

