

DH 7937912

5 11

12-29-16

2017 JAN -3 AM 8:54

Ragersville Elementary is a nontransient noncommunity public water system and is a part of the Garaway Local School district. The main section of the building was constructed in 1928 with additions being added in 1955, 1960 and 1990. The water system contains plumbing materials consisting of galvanized steel, copper and plastic (PVC). The fixtures throughout the building have been replaced since 1988. Buildings built prior to 1988 or that use plumbing material or solder manufactured before 1988 may have materials with greater than 8% lead and are at a higher risk of contributing lead to the drinking water than materials manufactured after 1988. In addition, buildings built and plumbing materials manufactured after 2014 were required to have less than 0.2% lead by weight and have the lowest risk for contributing lead to the drinking water. It should be noted however that, although prohibited, some use of leaded solder or leaded components may have occurred after the prohibitions became effective.



Let it be known that some of the water lines in the building have been routed in walls and under floors and their locations are estimated as closely as possible.

David Finzer

Custodian and Operator of Record

Core ID 1104813

Ragersville Elementary Floor Plans

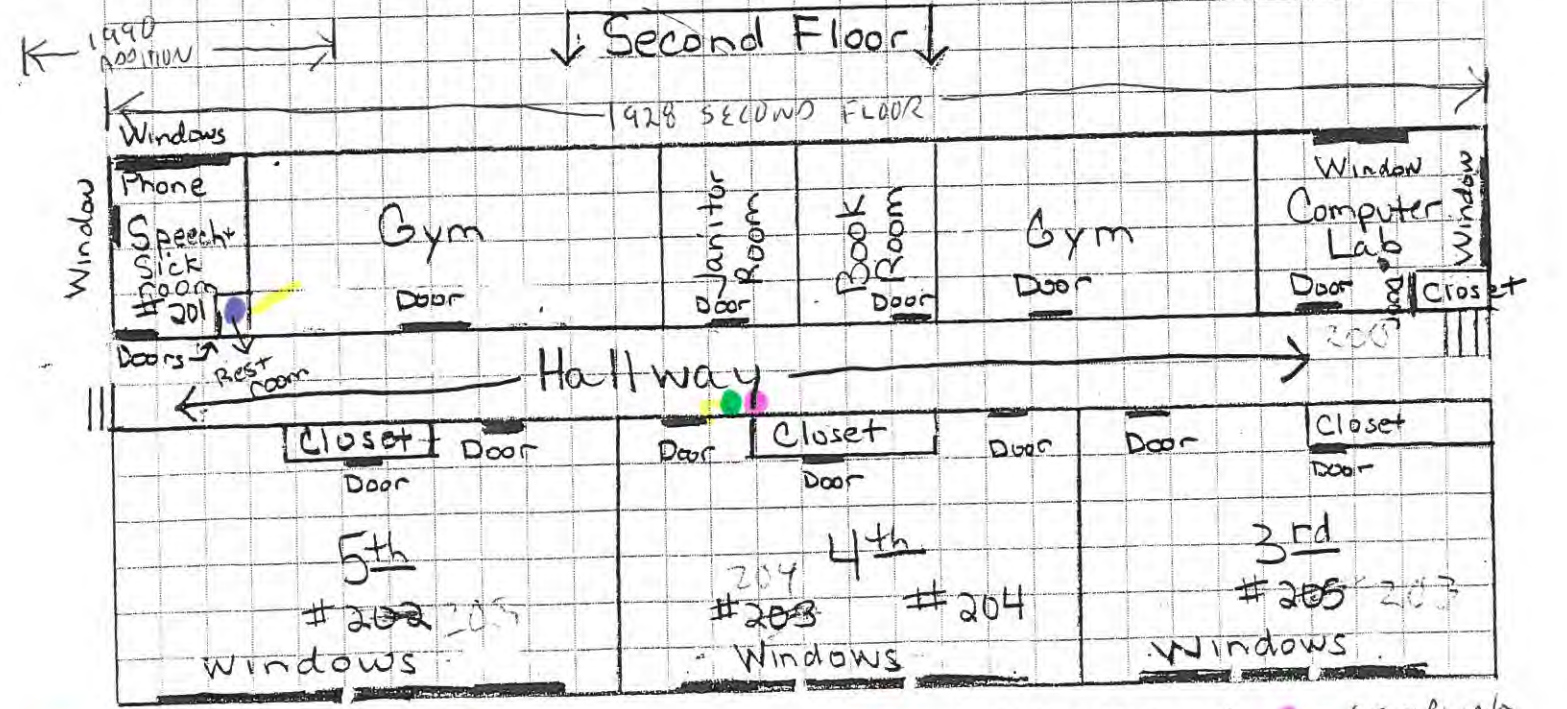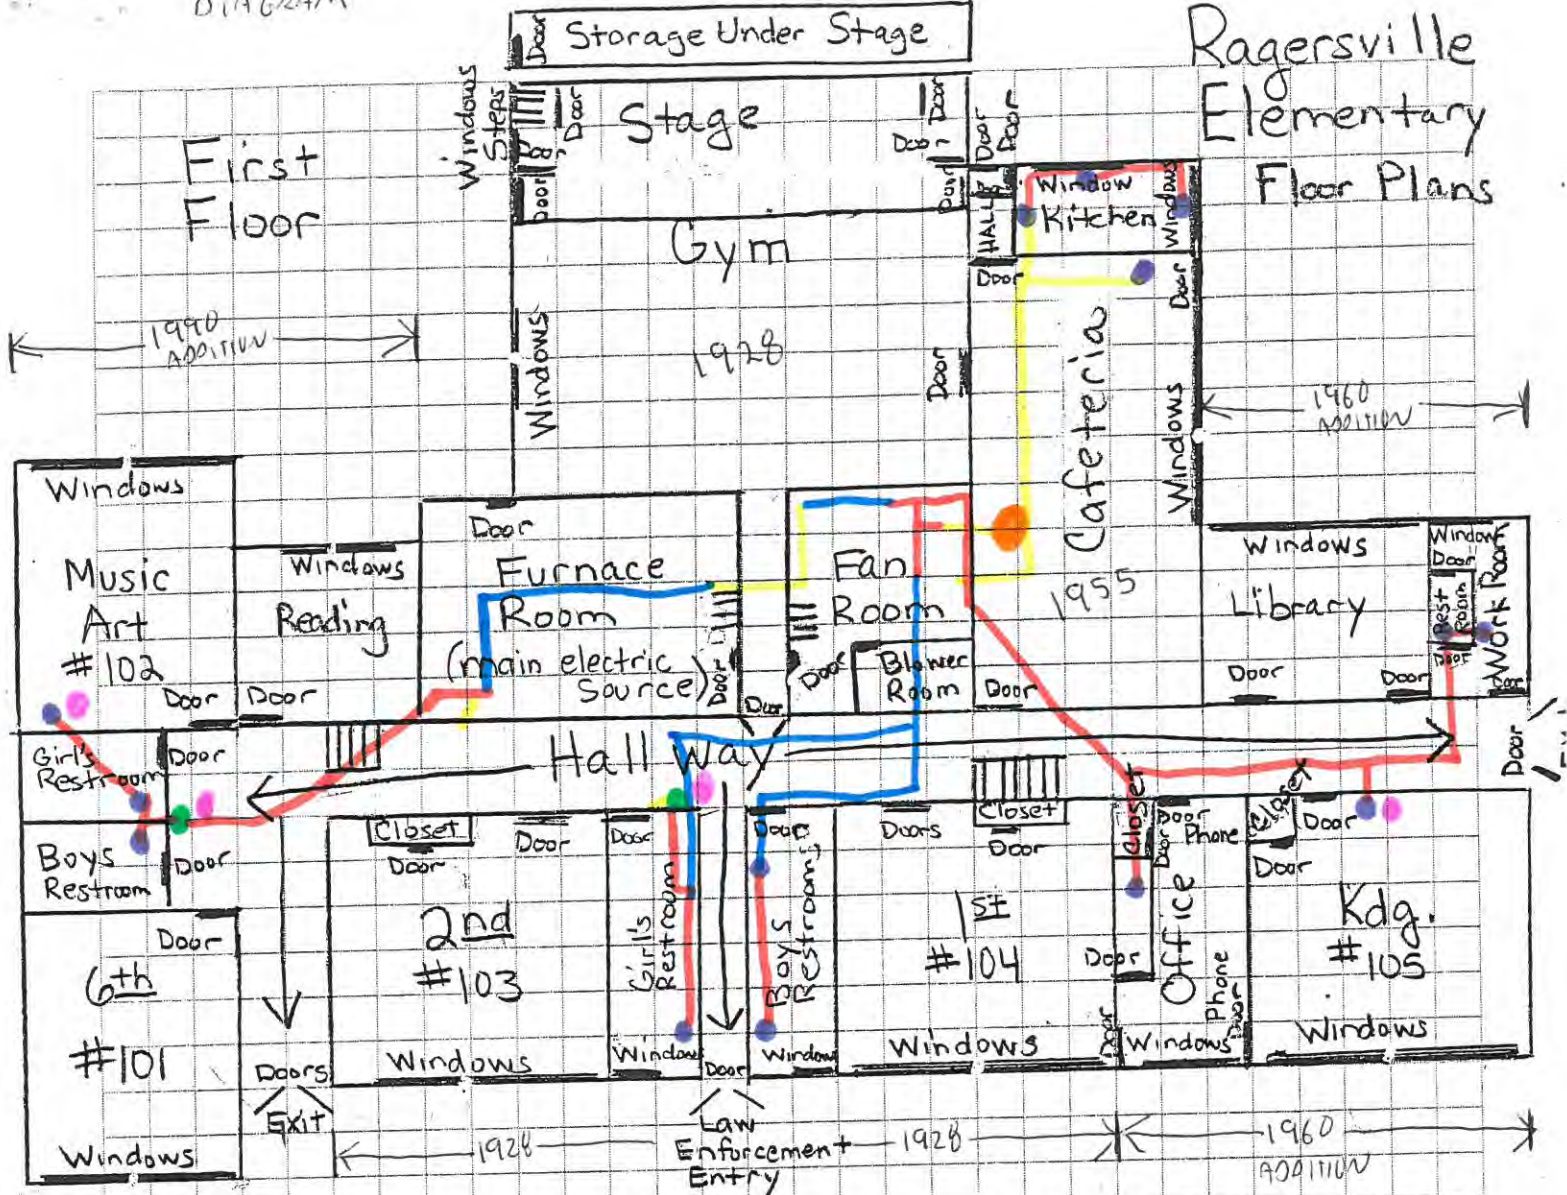

- - WELL SITE
- - SINK
- - COPPER WATER LINE
- - SAMPLING SITE
- - DRINKING FOUNTAIN
- - GALVANIZED WATER LINE
- - PLASTIC WATER LINE