


RE: West Unity Village
Report
Drinking Water Program
Williams County
PWS ID: OH8601812

South Section of West Unity

RECEIVED

JAN 31 2017

DDAGW - NWDO

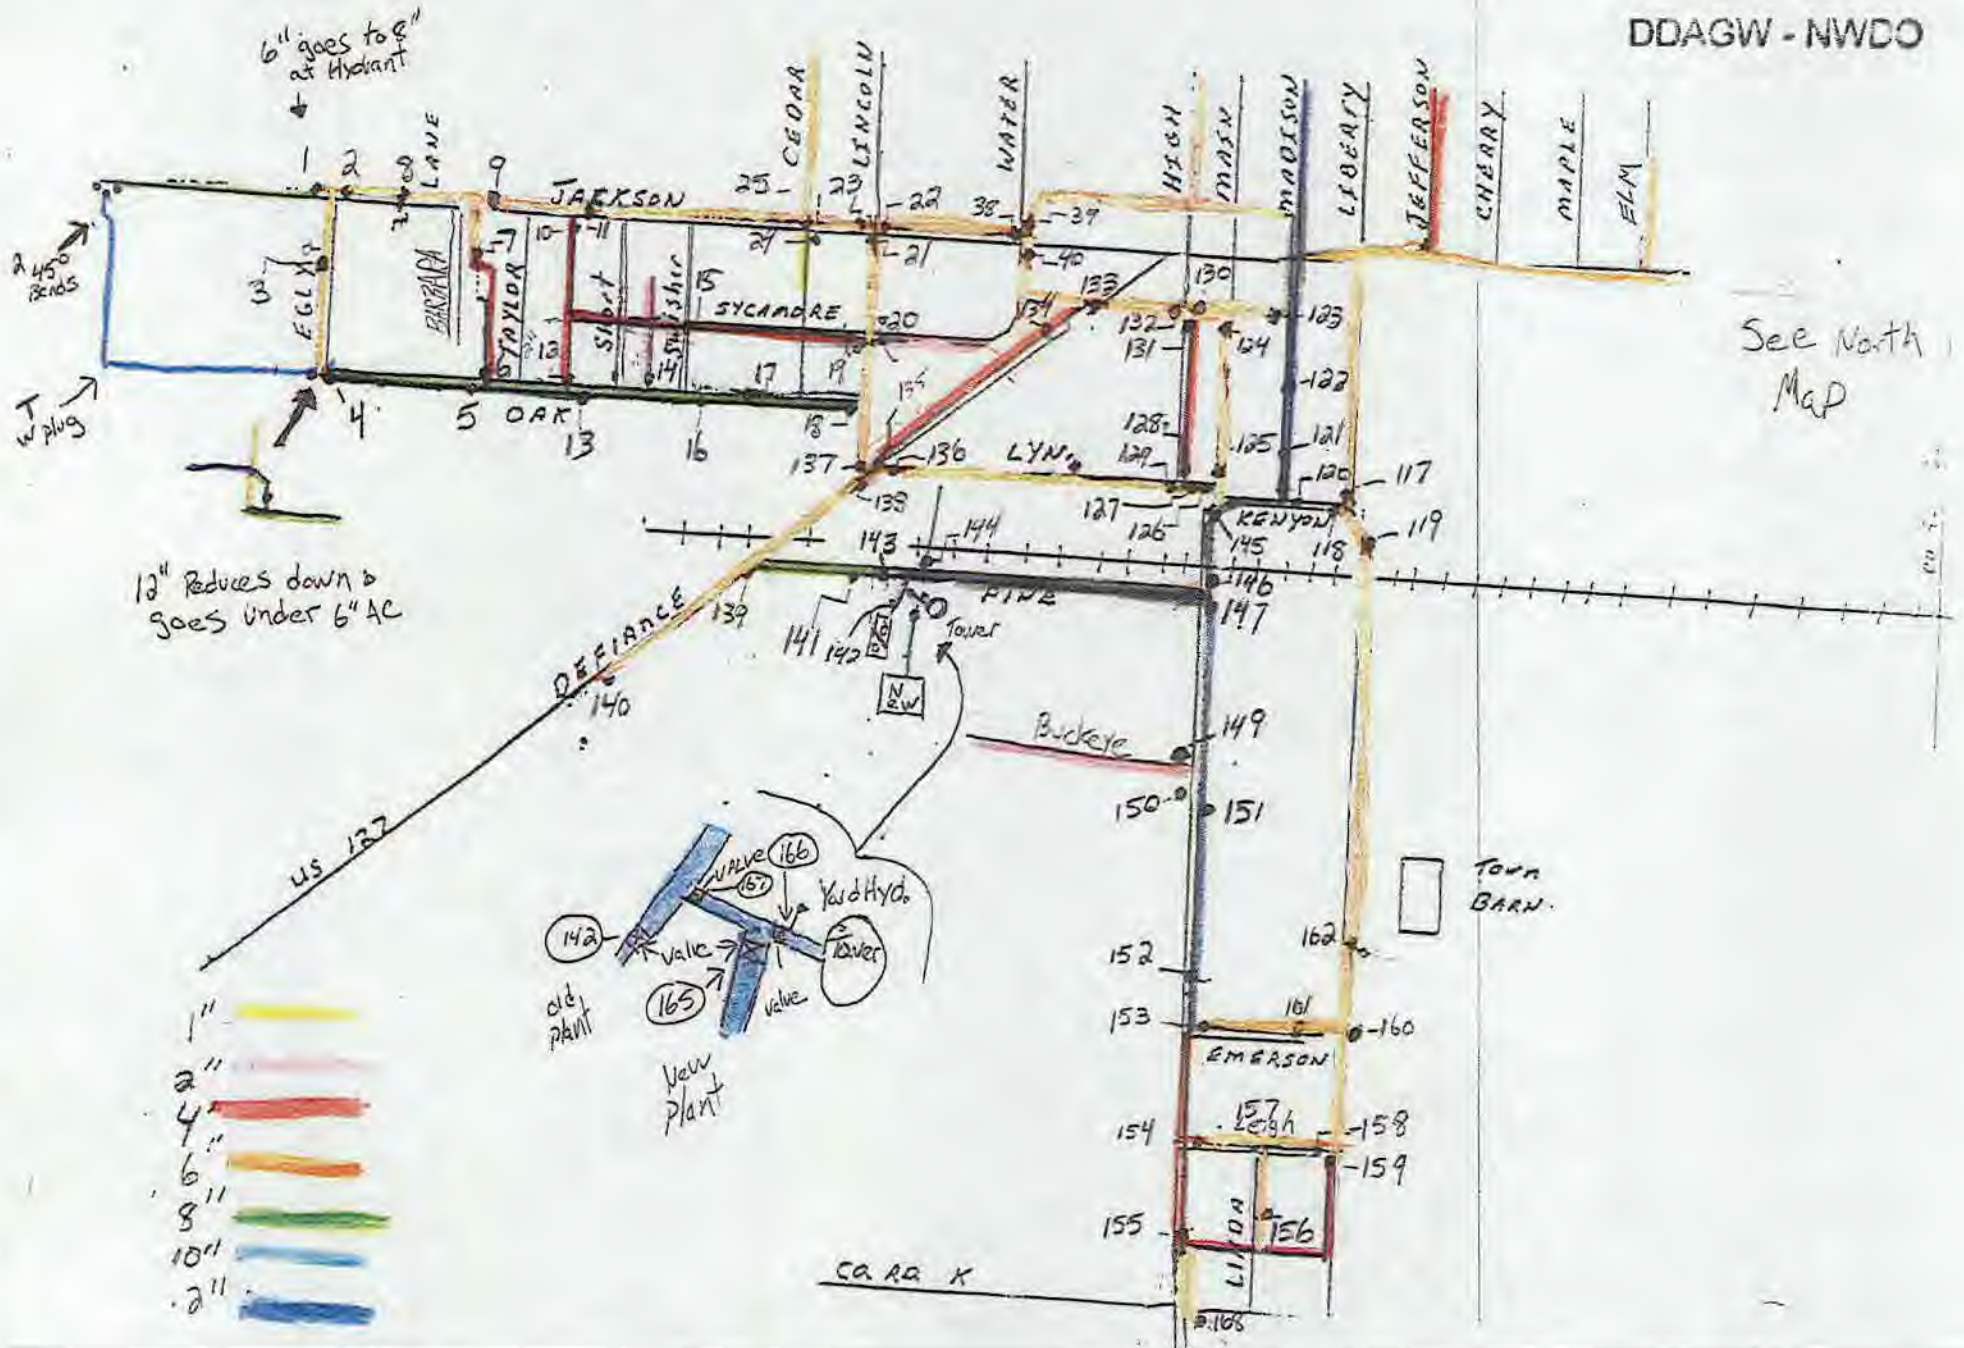

See North Map

12" Reduces down to goes under 6" AC

6" goes to 8" at hydrant

- 1"
- 2"
- 4"
- 6"
- 8"
- 10"
- 24"

Town BARN

CA. RD. X

100'

North Section of West Unity

RECEIVED

JAN 31 2017

DDAGW - NWDO

