

RE: Old Fort High School
Report
Drinking Water Program
Seneca County
PWS ID: OH7445212

Pb/Cu Locations

X well

RECEIVED


FEB - 2 2017

DDAGW - NWDO

Old Fort High School

First Floor

OH 744 5212

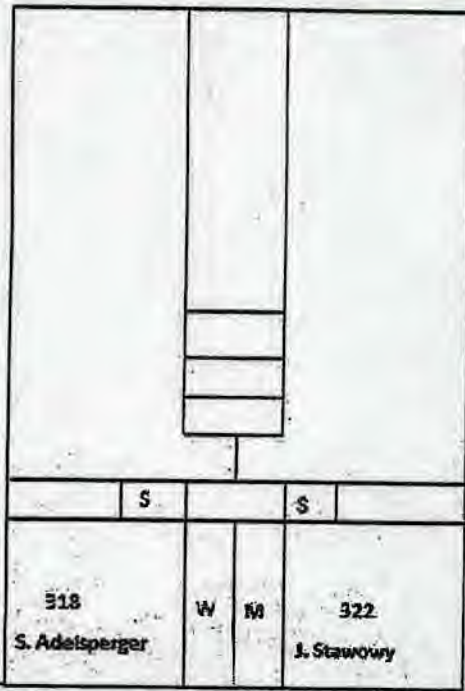

E. Wise - Transportation

Service Line
Steak

J. Bilger - Maintenance

LC201



Key

Bold Letter = Exit


S stairway

L elevator

M men's restroom

W women's restroom

School Built 1978
Inside Plumbing - copper

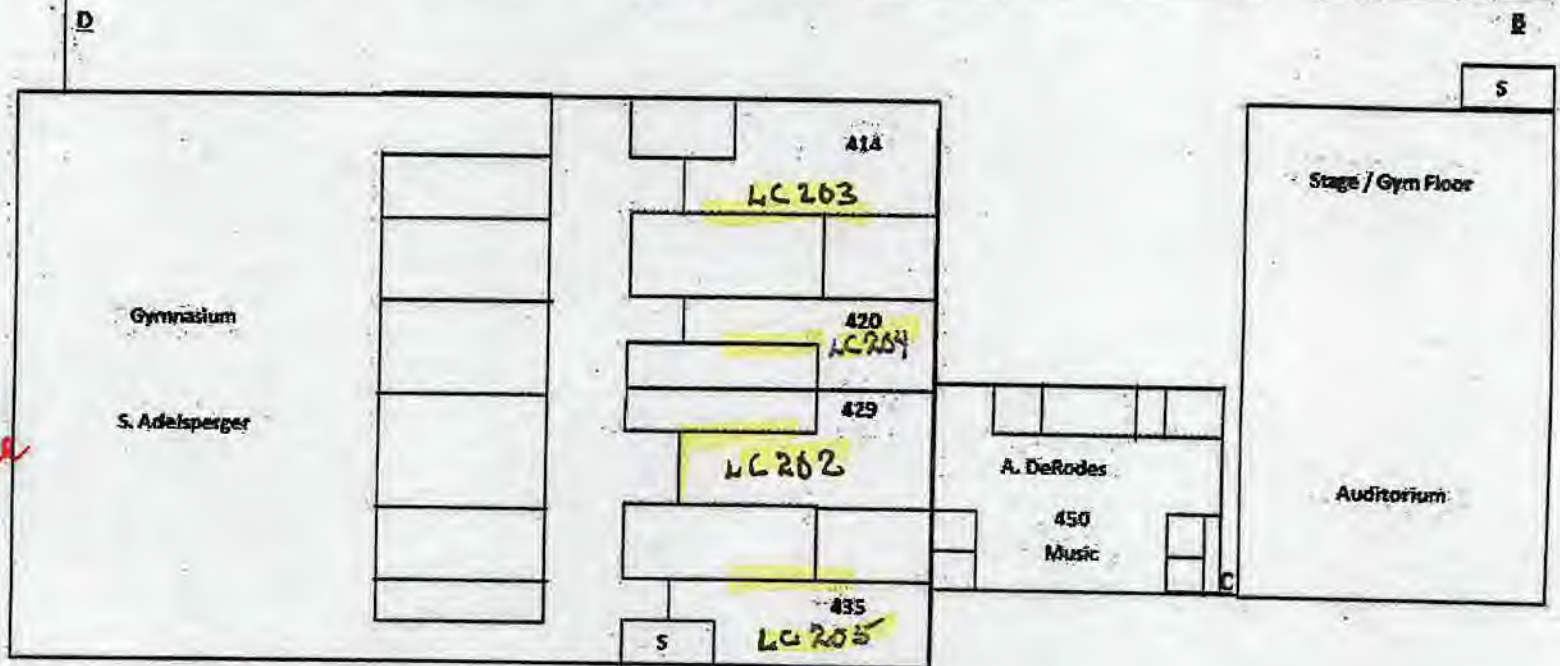


RECEIVED

FEB - 2 2017

DDAGW - NWDO

Old Fort High School

Second Floor

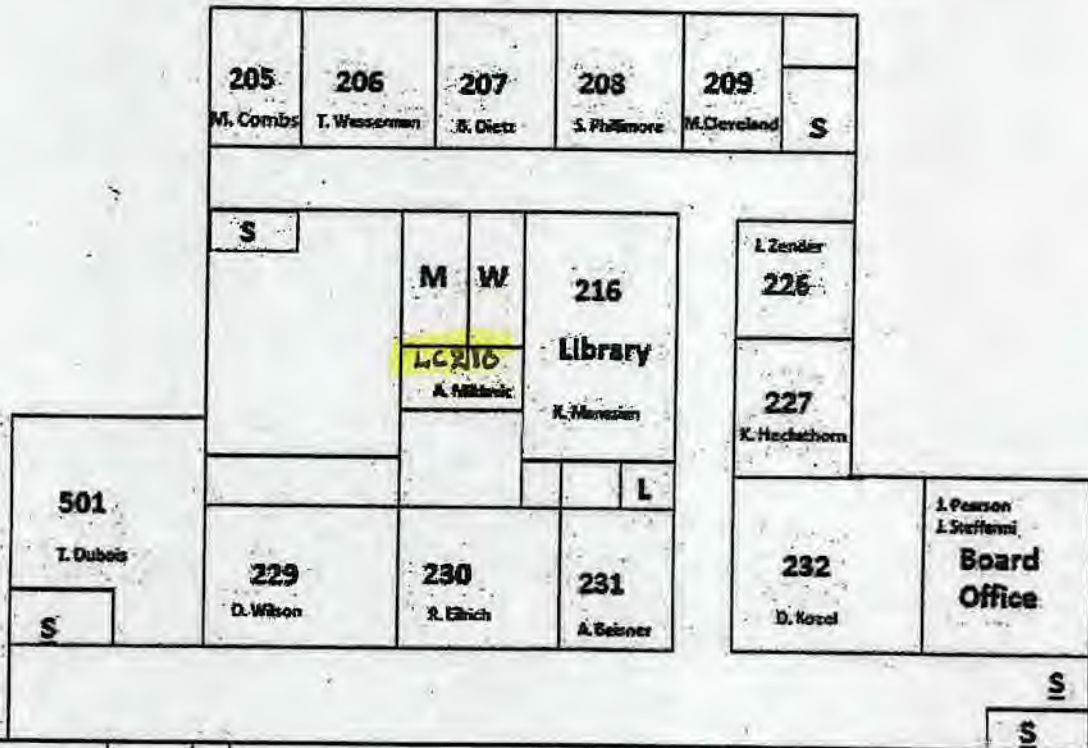

Key

Bold Letter = Exit

S stairway

L elevator

M men's restroom

W women's restroom

