

RE: ECI Inc Corporate Office  
Report  
Drinking Water Program  
Seneca County  
PWS ID: OH7432012

RECEIVED


FEB - 2 2017

DDAGW - NWDO

ECI Inc

OA 7432012

Plco Locations

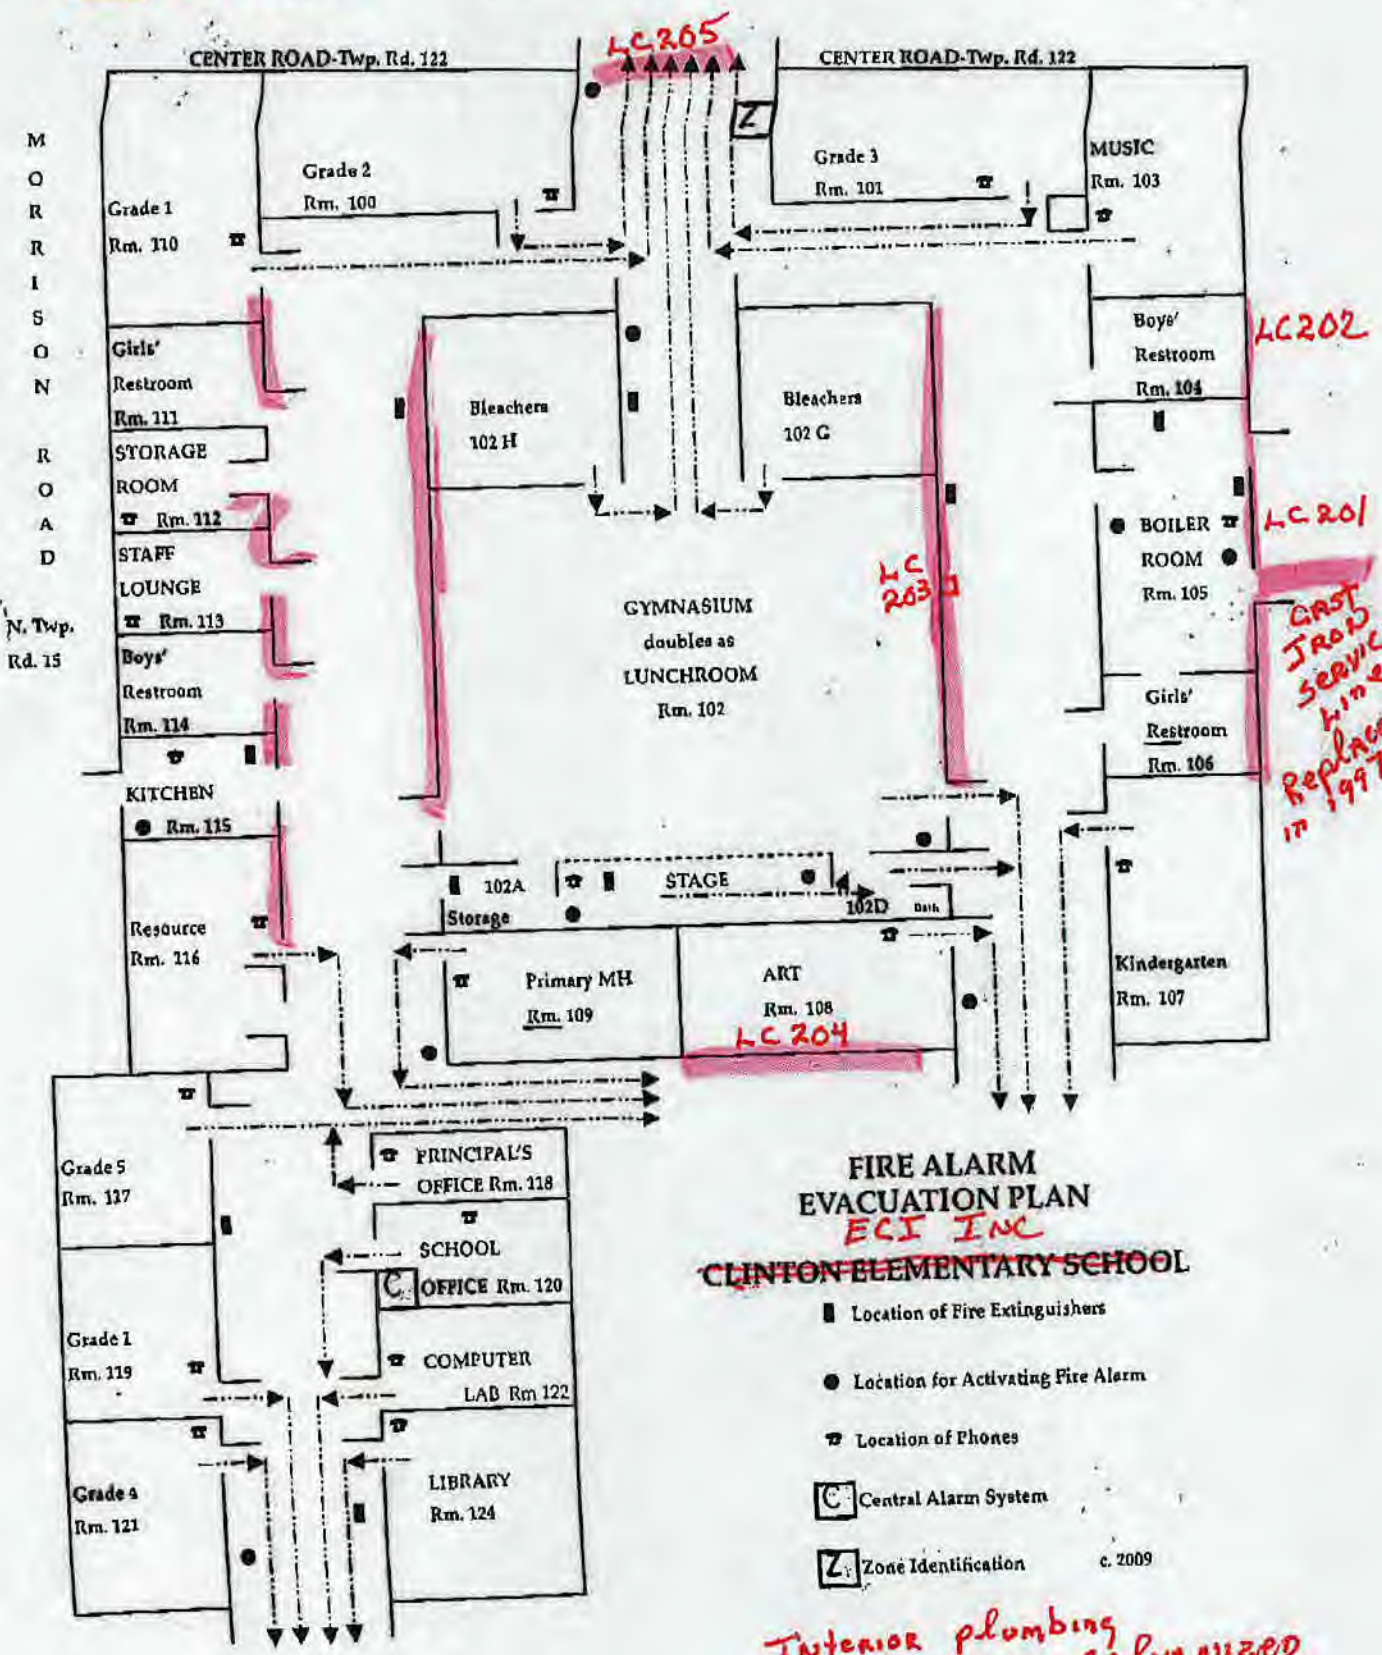

CAST IRON SERVICE LINE REPLACED 11/1997

FIRE ALARM EVACUATION PLAN  
ECI INC  
CLINTON ELEMENTARY SCHOOL

- Location of Fire Extinguishers
- Location for Activating Fire Alarm
- ☎ Location of Phones
- Ⓢ Central Alarm System
- Ⓩ Zone Identification

Interior plumbing  
CAST IRON & GALVANIZED  
School Built IN 1940's