

RE: Hopewell Loudon School
Report
Drinking Water Program
Seneca County
PWS ID: OH7449612

Hopewell Loudon School

0H7449612


1st floor

New School - NO LEAD

Built 2012
Service Line - Plastic
Plumbing - Plastic

Wells X

Plastic service line

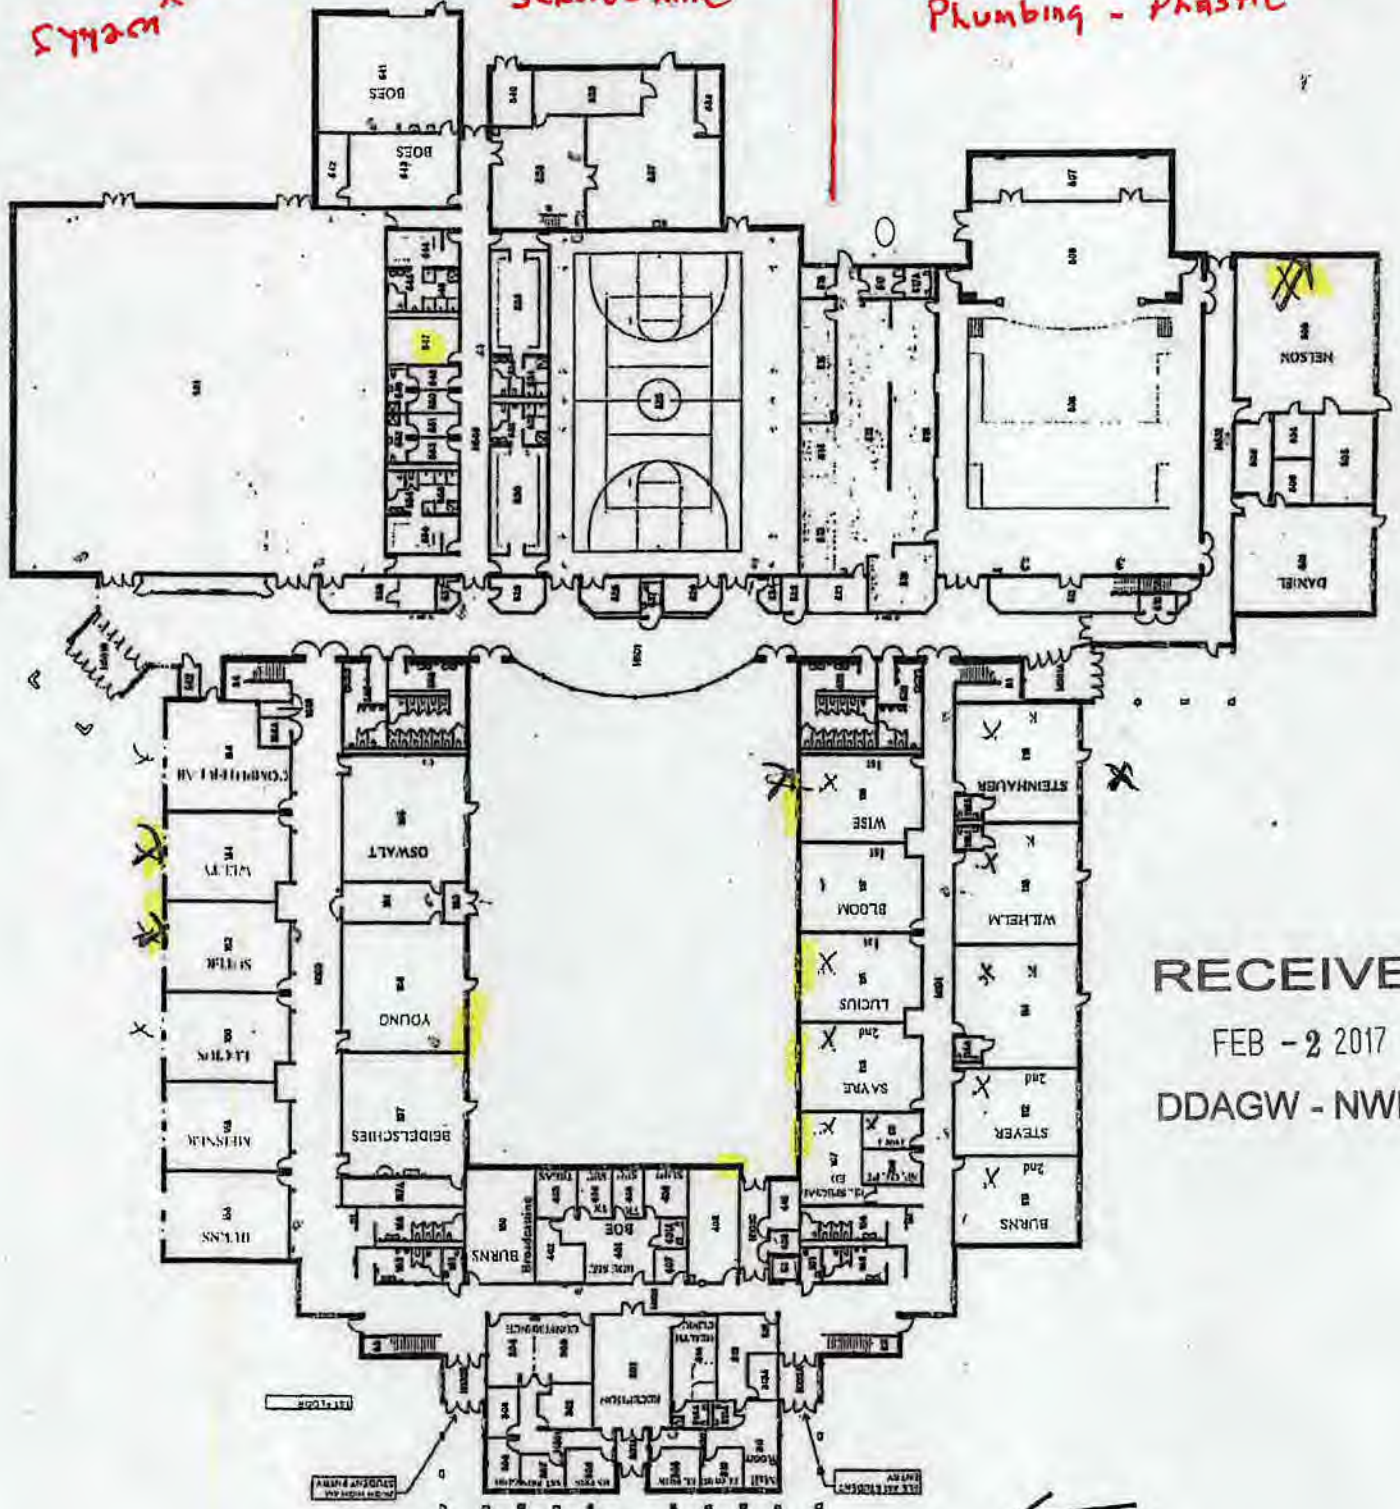


RECEIVED

FEB - 2 2017

DDAGW - NWDO

4

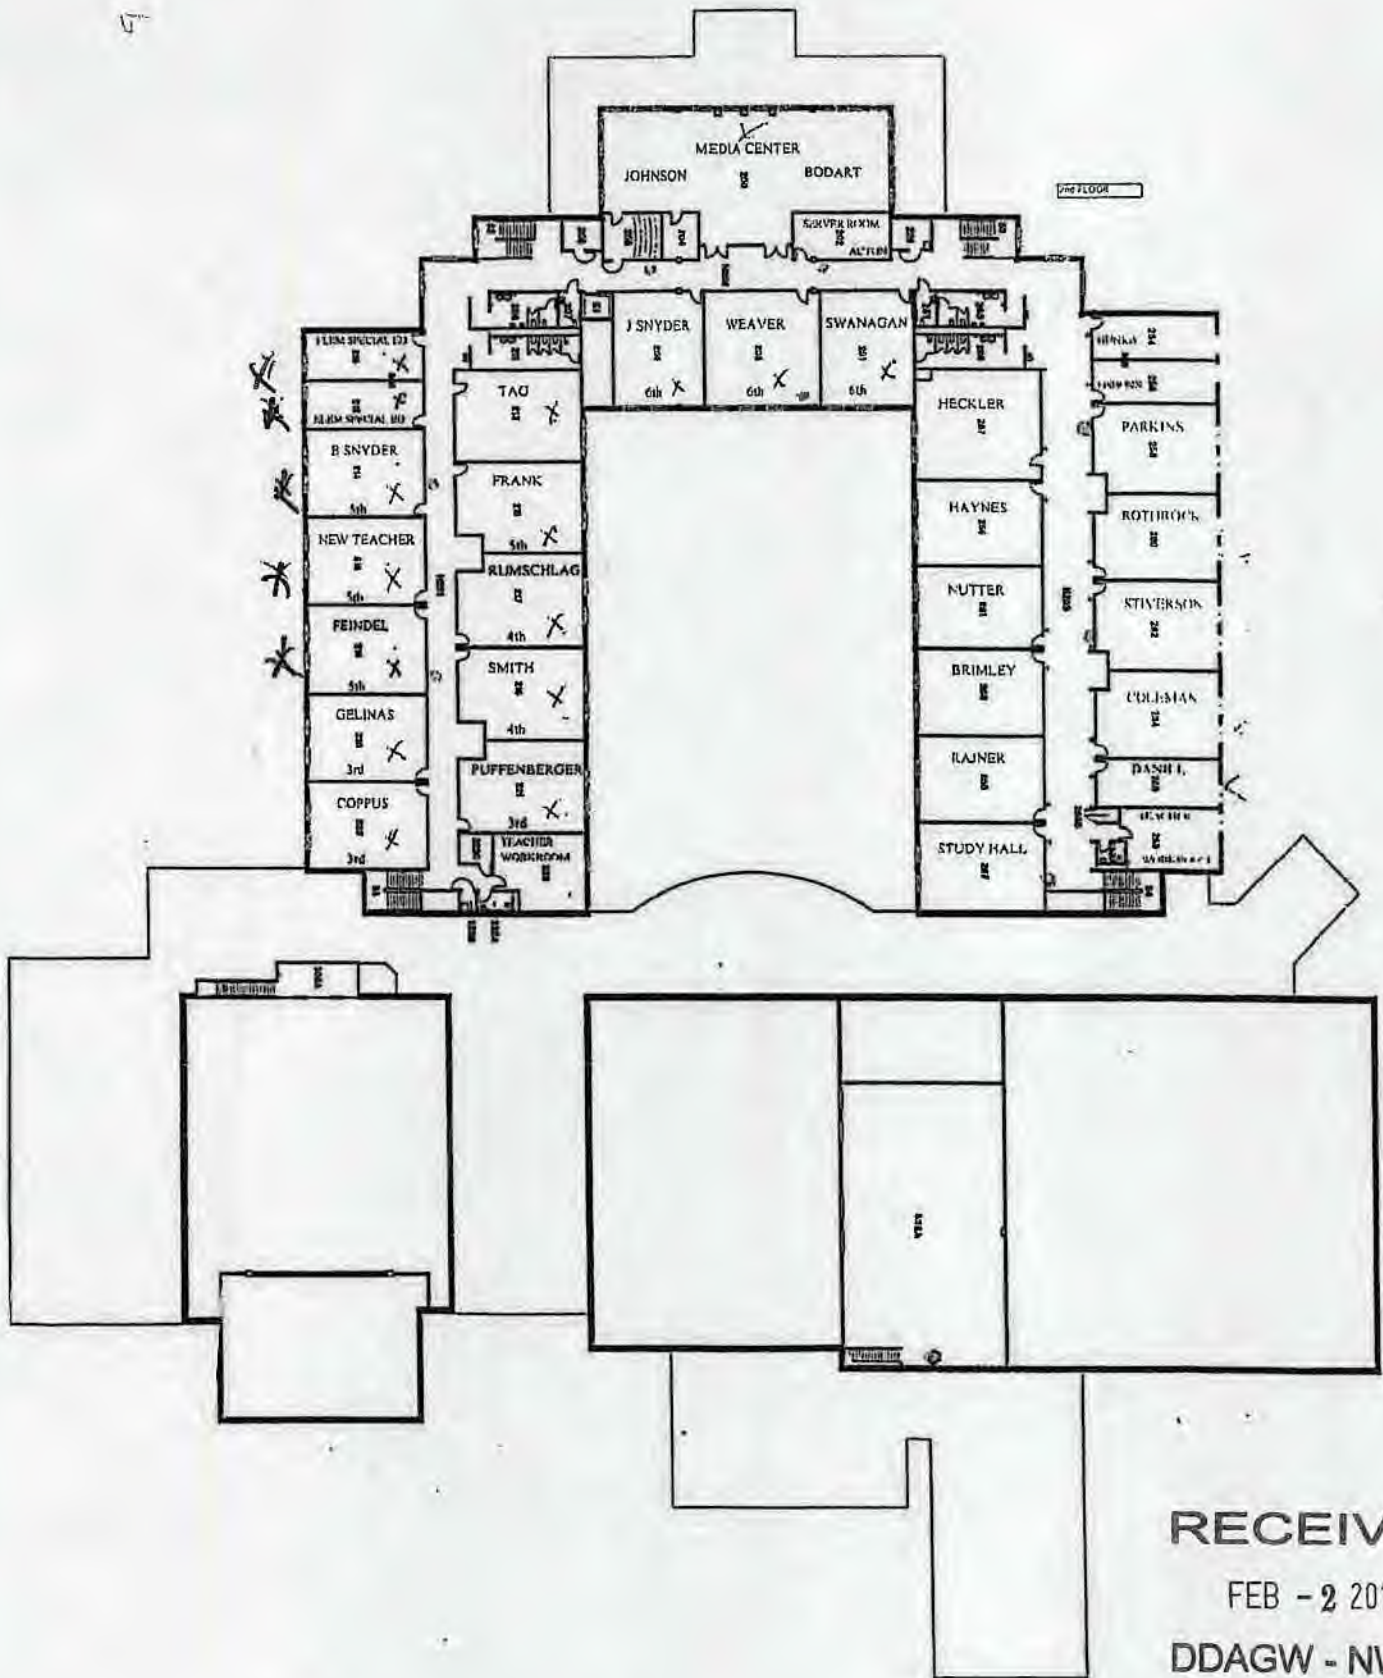

2nd Floor