


Date original water installed 1950
 Plastic Line / Plastic Service
 AC Main / Copper Service
 SMP ID
 No Actual Lead lines in system

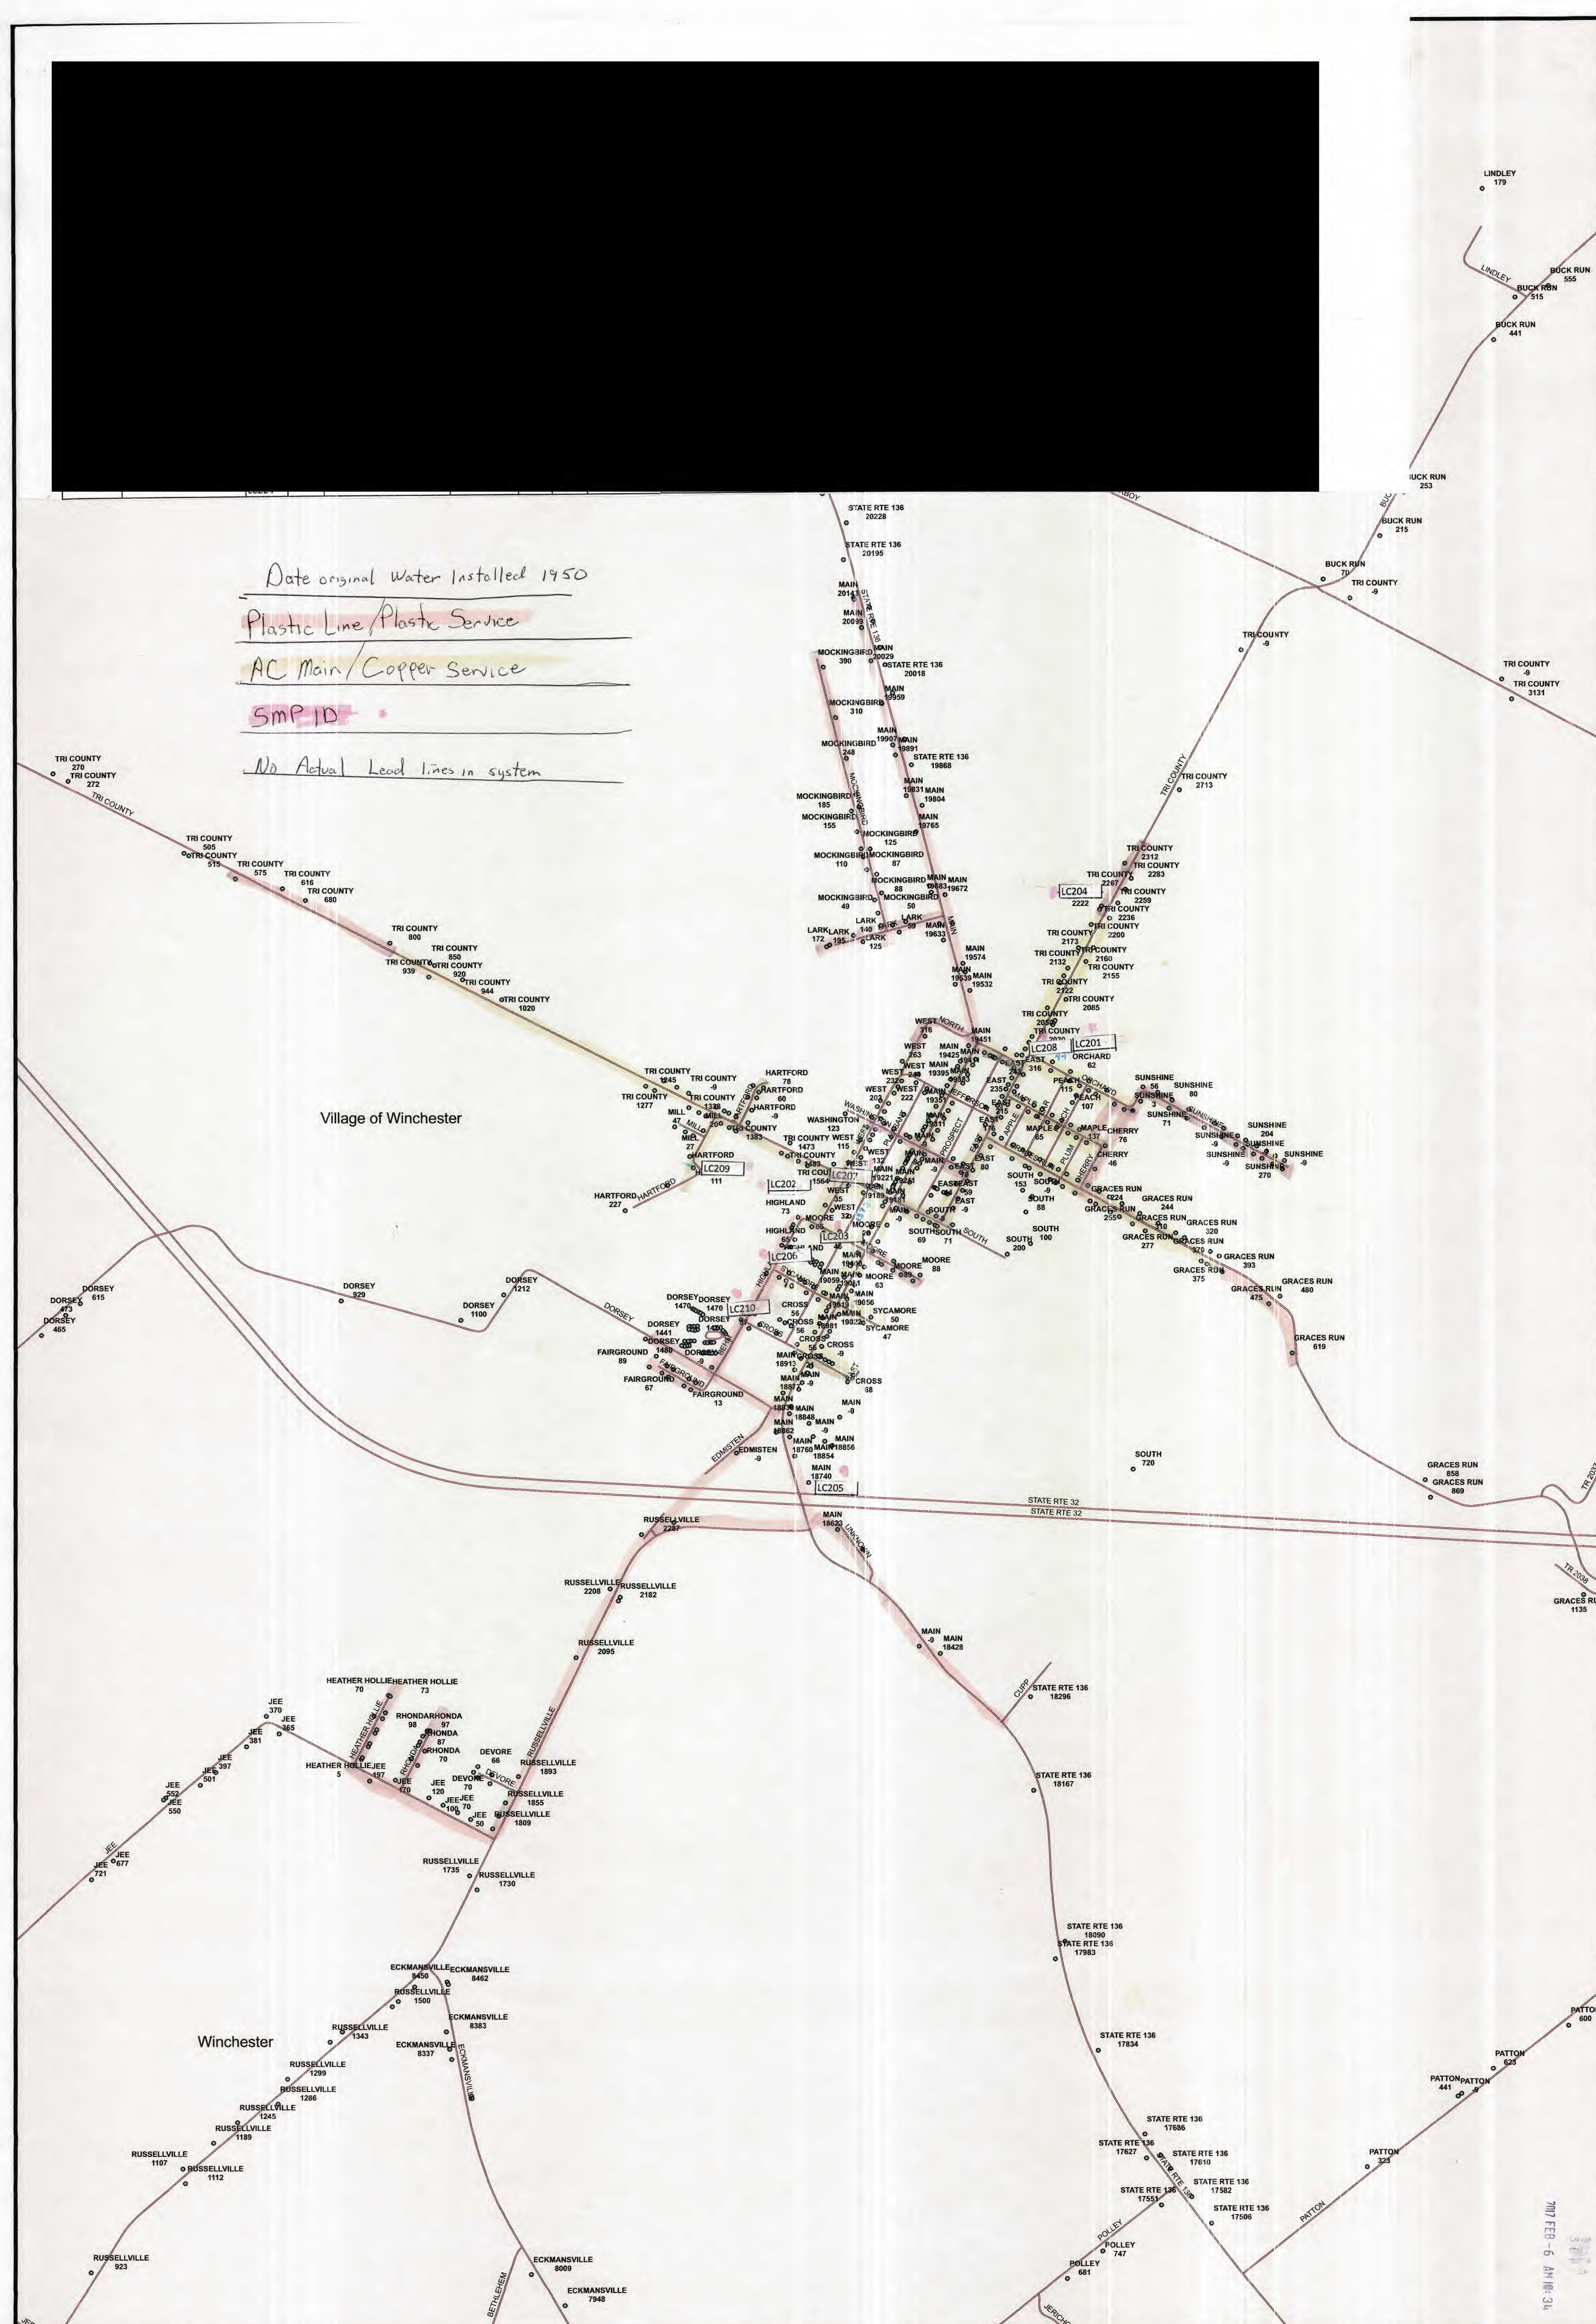

<p>Legend</p> <p>● Address</p>	<p>NOTE: THIS APPRAISAL MAP IS FOR TAX PURPOSES ONLY. IT IS NOT INTENDED FOR CONVEYANCES, NOR IS IT A LEGAL SURVEY.</p>	<p>PREPARED FOR: COUNTY AUDITOR'S OFFICE DAVID GIFFORD ADAMS COUNTY AUDITOR</p>	<p>MAINTAINED BY: COUNTY ENGINEER'S OFFICE DAVID HOOK ADAMS COUNTY ENGINEER</p>	
--------------------------------	---	---	---	--

7/17/17 FEB - 6 AM 11:34