

RE: Ashland County Service Center  
Report  
Drinking Water Program  
Ashland County  
PWS ID: OH0300212

Ashland County Office Bldg  
110 Cottage Street  
Ashland, Ohio 44805

.....

# Ashland County

February 1, 2017

**RECEIVED**

FEB 06 2017

OHIO E.P.A.  
N.W.D.O.

Ohio EPA  
North West District Office  
347 North Dunbridge Road  
Bowling Green, Ohio 43402

Dear Sir or Madam:

*Per the new lead regulations, I have enclosed the required paper work necessary. This information is for the Ashland County Service Center, 1763 State Route 60 Ashland Ohio 44805 PWS ID # OH 0300212.*

*Please be advised that all copper piping was originally installed in this building in 1975 and is currently still in use today.*

*If you have any Questions, please feel free to call me anytime at 419-282-4222. Fax 419-281-6939.*

*Sincerely,*


*Dennis Harris*

Dennis Harris  
Ashland County Building Maintenance Superintendent

.....

EAST

WELL#3

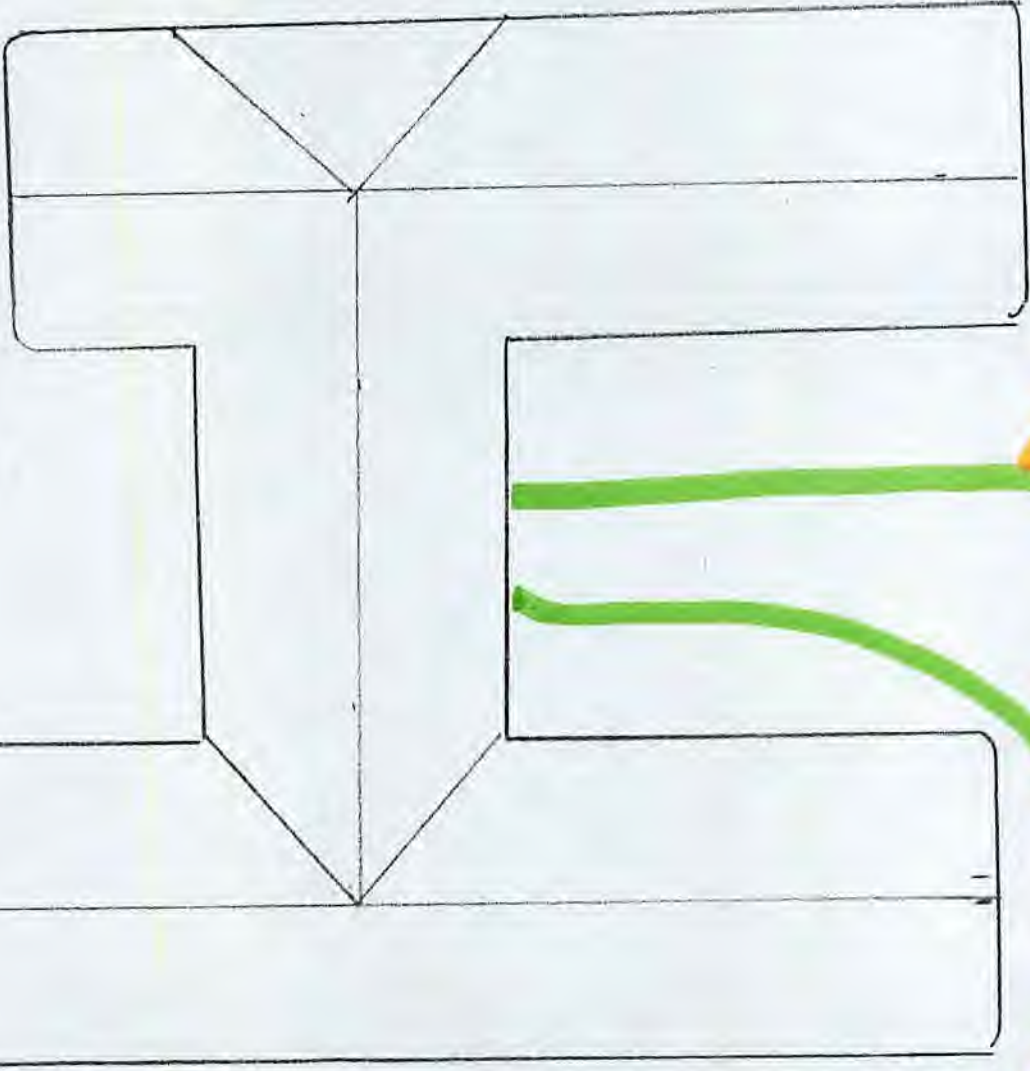


NORTH

WELL#2

SOUTH

WELL#1


Galvanized 

WEST

Copper 

STATE ROUT 60



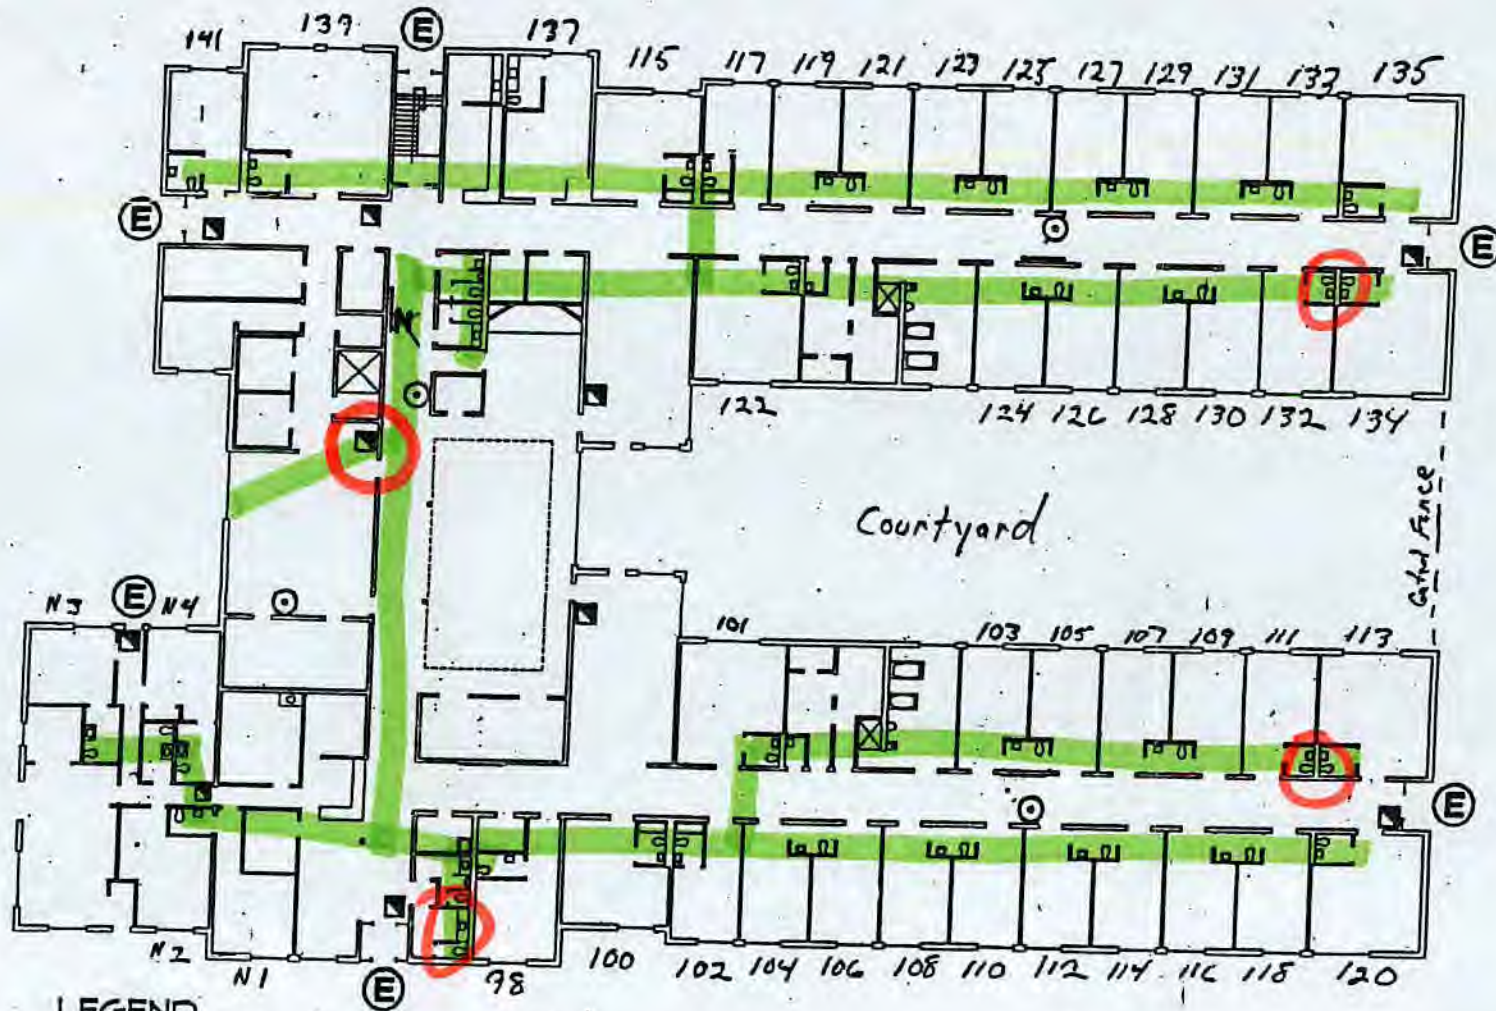


- LEGEND**
- (E) EXITS
  - YOU ARE HERE
  - FIRE EXTINGUISHERS
  - FIRE ALARM PULL STATIONS

## UPPER FLOOR PLAN

TORNADO SHELTER (LOWER LEVEL) ○ Lead Sample Location Copper █



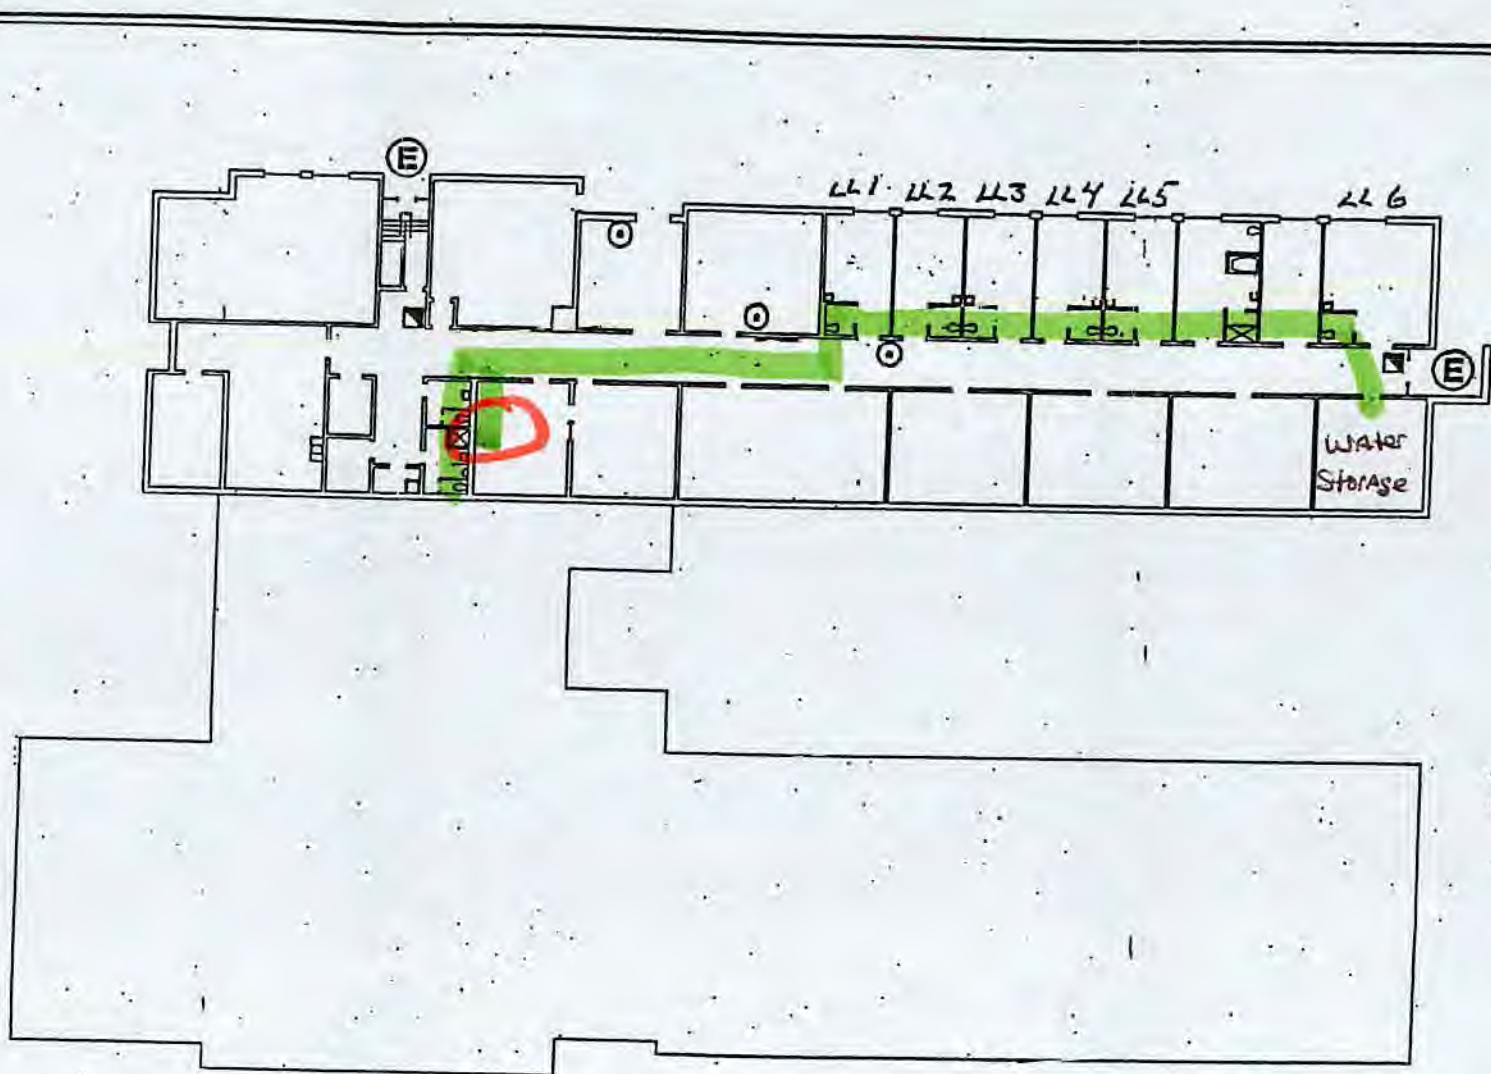

LEGEND

- ⓔ EXITS
- YOU ARE HERE
- Ⓞ FIRE EXTINGUISHERS
- FIRE ALARM PULL STATIONS

○ Lead Sample Location

Copper

LOWER FLOOR PLAN