


RE: PAX Machine Works  
Report  
Drinking Water Program  
Mercer County  
PWS ID: OH5438212

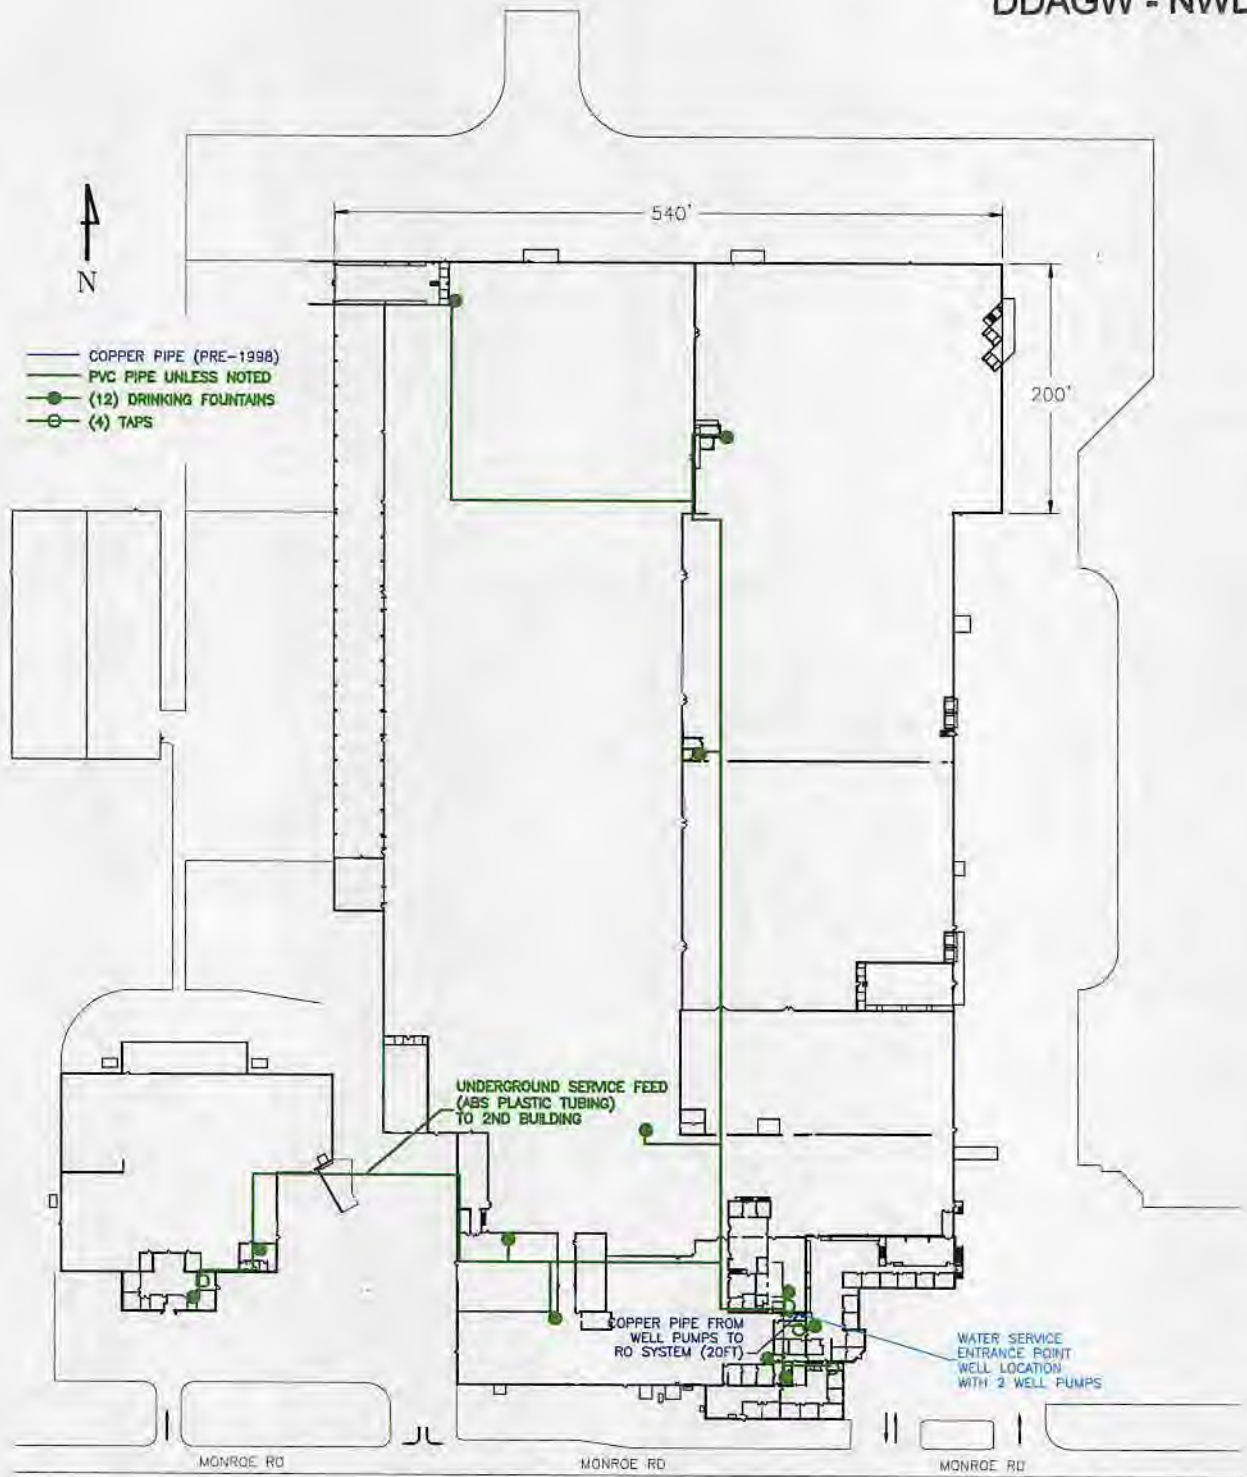

PWS ID: OH5438212  
PAX MACHINE WORKS, INC  
5139 MONROE RD  
CELINA, OH 45822  
PHONE: 419-586-2337  
CERTIFIED OPERATOR:  
JOSEPH H. HAMBERG  
WS1-1104948-16