


040701703

2017 FEB 15 AM 10:24

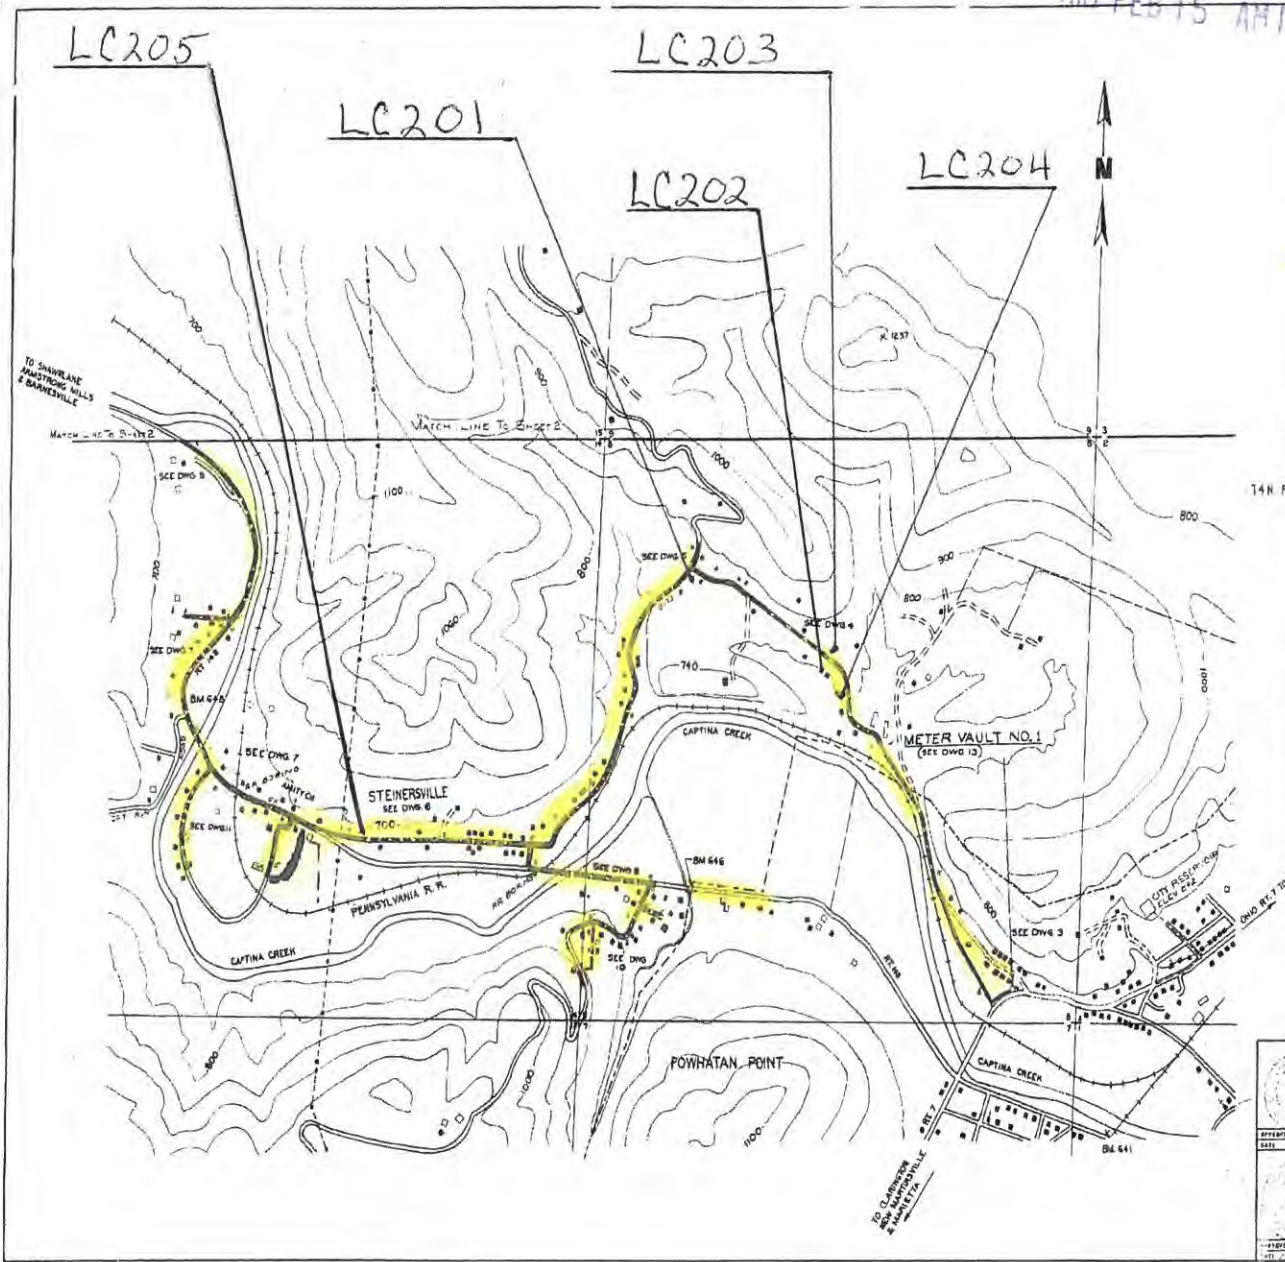

York Township Water Authority
 P.O. Box 133
 Powhatan Point, Oh 43942
 York Township Water Authority, established in 1968, serves members in a small section of York Township in and around Steinersville in Belmont County.


York Township Water Engineered Drawing and Technical Specifications indicated specific couplings for PVC pipe and PVC pipe installation in all customer service meter pits. At this time the Authority is in the process of installing new radio read meters and replacing leaking service lines. PVC pipe has been found in 100% of all replacements indicating the system was installed to specifications indicated on the Technical Drawings and contained no lead lines.

Buildings in Ohio build prior to 1998 or that use plumbing material of solder manufactured before 1998 may have materials with greater than 8% lead and are at a higher risk of contributing lead to the drinking water than materials manufactured after 1998. In addition buildings built and plumbing materials manufactured after 2014 were required to have less than 0.25% lead by weight and have the lowest risk for contributing lead to the drinking water. It should be noted however that although prohibited, some use of leaded solder or leaded components may have occurred after the prohibitions became effective.

Areas with houses and/or buildings built before 1998 and may have a higher risk of contributing lead to the drinking water.

	CORINNE & WALSH, INC. ENGINEERS WHEELING, W.VA.
	YORK TOWNSHIP WATER AUTHORITY STEINERSVILLE, OHIO WATER SYSTEM
SCALE: 1" = 500' DRAWN BY: C.M.E. DATE: 6/25/06	CHECKED BY: [Blank] DATE: [Blank]

2017 FEB 15 AM 10:24

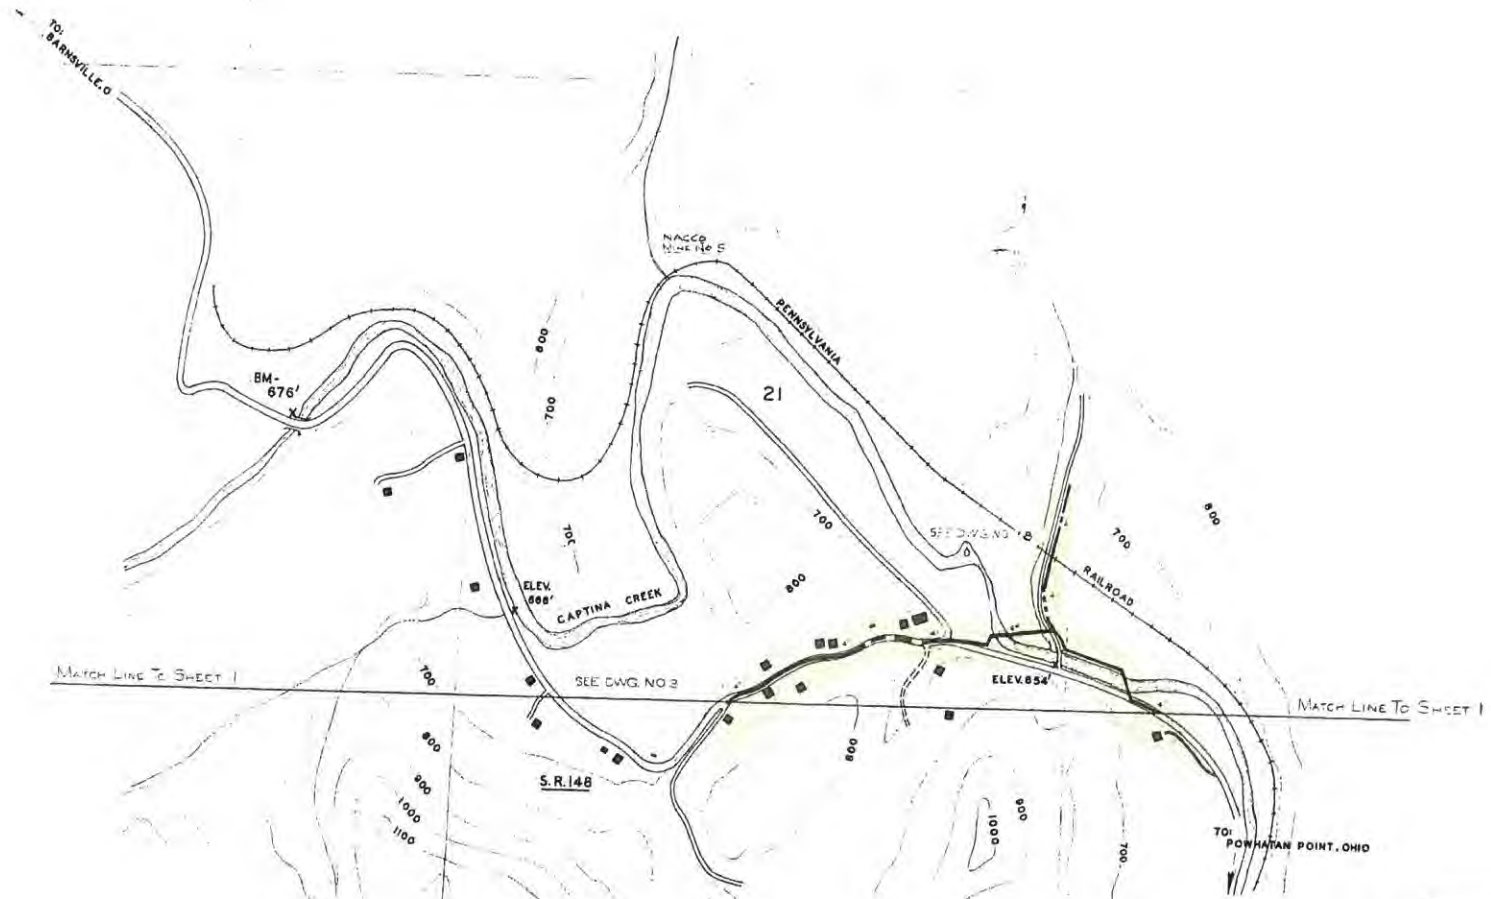

	NO. _____ REGION _____
	APPROVED _____ DATE _____
	CERRONE & VAUGHN, INC., ENGINEERS WHEELING, W. VA.
	YORK TOWNSHIP WATER AUTHORITY STEINERSVILLE, OHIO WATER SYSTEM
APPROVED _____ DATE _____	SCALE: 1"=500' DRAWN BY: R.J.T. DATE: 11/16/16
CHECKED BY: _____ DATE: _____	SHEET NO. 2 OF 12