

PWS ID OH1030212  
Augusta Elementary School  
3117 Aurora Rd. N.E.  
Augusta, Ohio 44615

1/18/2017

### Lead Service Line and Fixture Mapping Project

Augusta School was built in 1928, 1945 garage addition, 2000 bathrooms remodeled. At this time no lead service lines detected. Black plastic well pipe from the well to the building basement. Copper manifold to the bladder holding tanks and sand filter. The pipe from the tanks to the building is ridged plastic. 15 feet it hooks to galvanized pipe again to distribute cold water to the first and second floor bathrooms and old shower rooms. Galvanized pipe continues thru the crawl space to the basement café kitchen. The hot water tank near the kitchen has some copper hook ups. (Buildings built prior to 1988 or that use plumbing material or solder manufactured before 1988 may have materials with greater than 8% lead and are at a higher risk of contributing lead to the drinking water than materials manufactured after 1988. In addition , buildings built and plumbing materials after 2014 were required to have less than 0.2% lead by weight and have the lowest risk for contributing lead to the drinking water. It should be noted however that, although prohibited, some use of lead solder leaded components may have occurred after the prohibitions became effective.)

#### MAP COLOR KEY:

Blue – Galvanized Pipes

Red - Copper Soldered Pipes

Green – Plastic Pipes

Purple Circles – Sample Locations For EPA Lead & Copper

LC201 – 1<sup>st</sup> floor boys RR

LC202 – 1<sup>st</sup> floor girls RR

LC203 – 2<sup>nd</sup> floor girls RR

LC204 – 2<sup>nd</sup> floor boys RR

LC205 – Kitchen pot & pan sink

LC206 – WC 1<sup>st</sup> floor east


Carrollton Exempted Village Schools (Carroll County Ohio) Owns and operate this school.

252 3<sup>rd</sup> Street N.E.


Carrollton, Ohio 44615


330-627-2181 (Board Office)

Contact: [terry.moore@carrolltonschools.org](mailto:terry.moore@carrolltonschools.org)

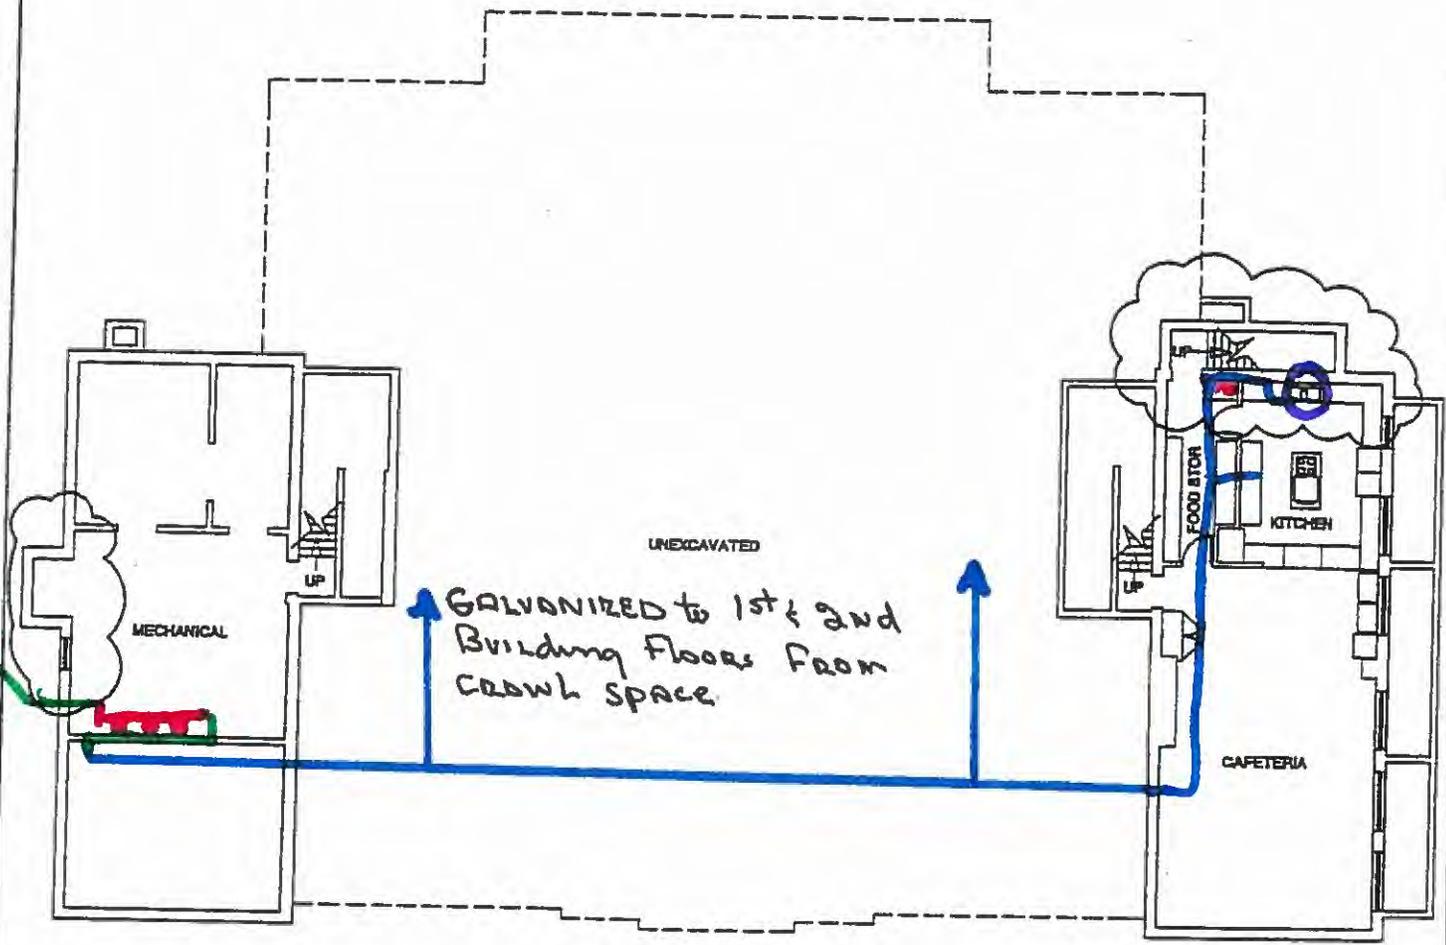

**BASEMENT FLOOR PLAN**

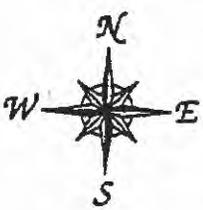

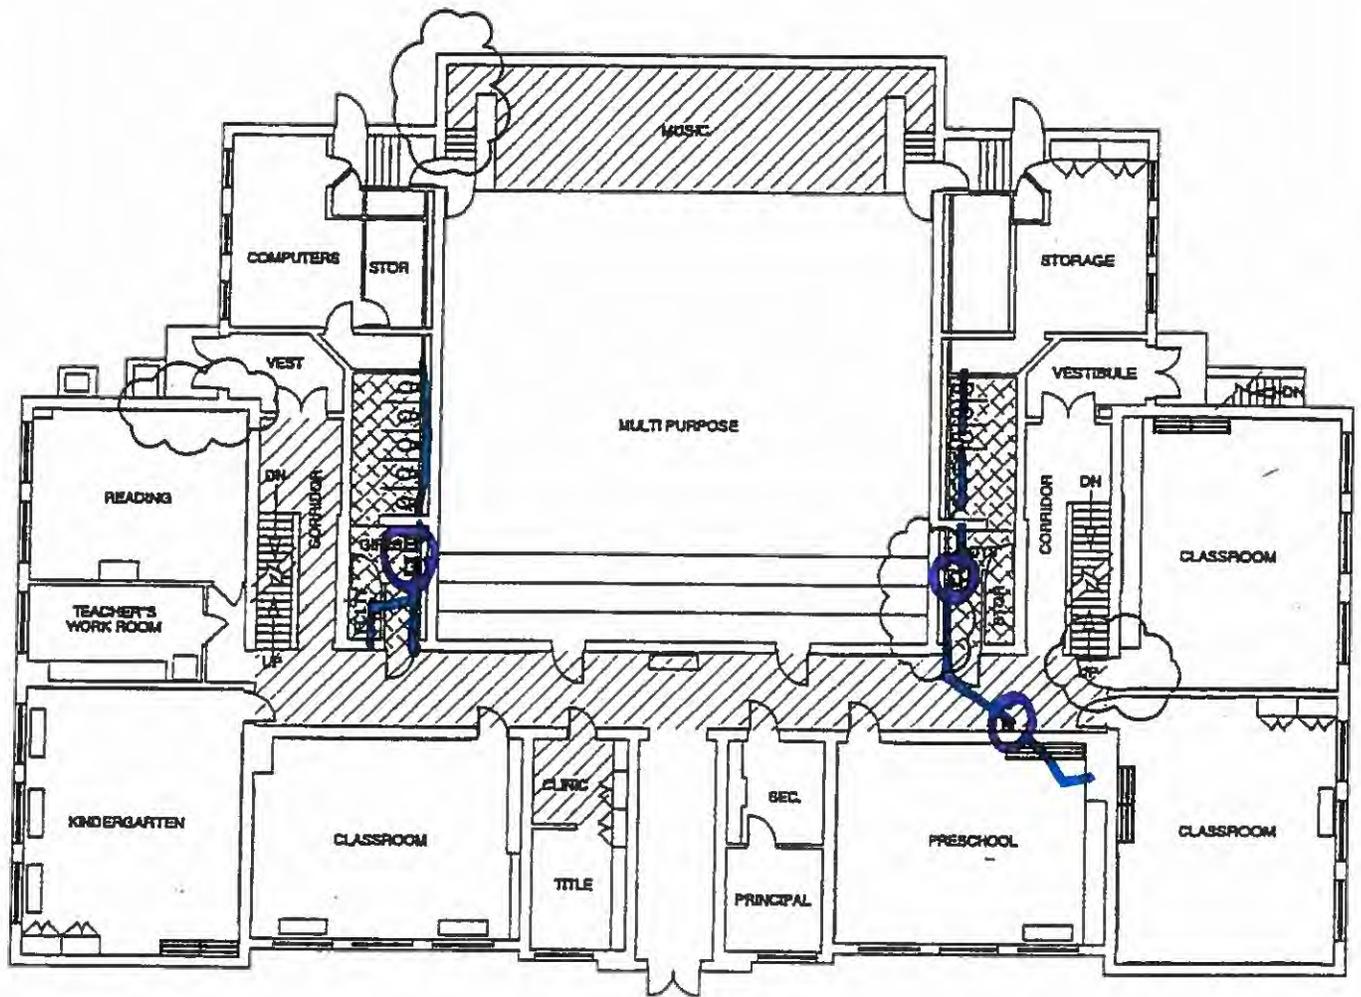

**FIRST FLOOR PLAN**





**SECOND FLOOR PLAN**

