

RE: Graf Kids Campus
Report
Drinking Water Program
Fulton County
PWS ID: OH2637312



Kids' Campus

25070 Cty. Rd. L • Fayette, Ohio 43521 • 419-237-1004

Graf Kids' Campus LLC
25070 Co. Rd L
Fayette, OH 43521
PWS ID :OH2637312

RECEIVED

FEB 21 2017

OHIO E.P.A.
N.W.D.O.

These drawing were taken from the original blueprints of the building. Plumbing was installed in 1999. There have been no changes or additions since the initial installation. There were no lead pipes used and only lead free solder was used.

Contact person:

Gene Graf

25018 Co Rd.L

Fayette, Ohio 43521

Phone: 419=237-~~3636~~
2626

6" ϕ PVC SAN. SEWER
TO SEPTIC TANK

62 GAL. PRESSURE TANK

HOSE BIB


1" ϕ C.W.

3/4" ϕ H.W.

C.O.

INV. OF SEWER @ 14"
BELOW FINISH FLOOR

THE WATER
IS FROM
TOWN

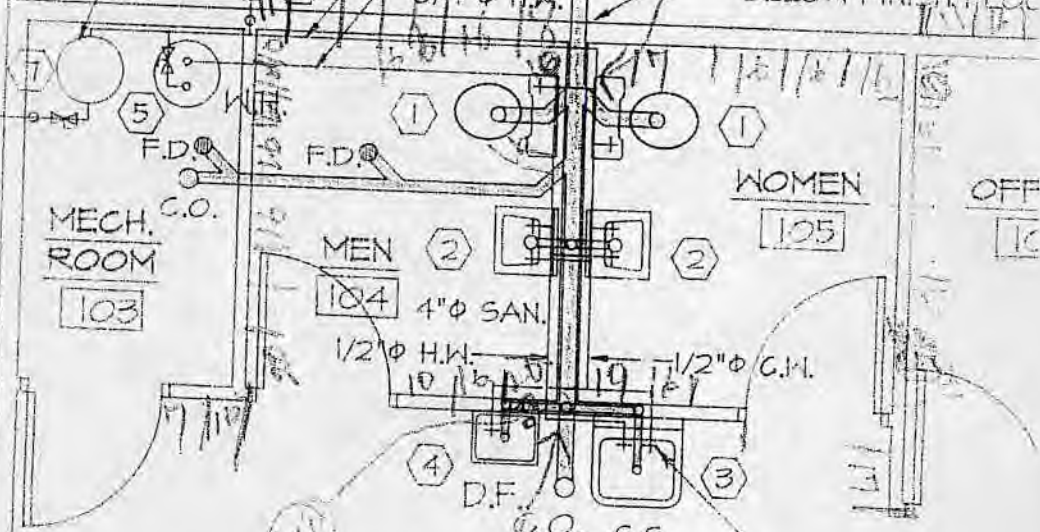

MECH.
ROOM
103

MEN
104

WOMEN
105

OFF
106

ARTS & CRAFTS
102

PLAY AREA
101

Sample Location
Men Sinks Women Sinks

RAW WATER
SAMPLING TAP
(COLD WATER)

VAULTED CLS.

PLUMBING PLAN

DAVID L. GERINGER P.E.
Consulting Engineer

201 Ditto St. Archbold, Ohio 43502

REVISIONS	BY
PERMITS 8-28-98	D.G.
PERMITS 10-14-98	D.G.

PROPOSED DAYCARE CENTER FOR KID'S CAMPUS

25018 COUNTY ROAD L, FAYETTE, OHIO

Date 8-28-98

Scale AS NOTED

Drawn D.L.G.

Job 98008

Sheet No.

P-1