

RE: Coble Village MHP  
Report  
Drinking Water Program  
Huron County  
PWS ID: OH3900112



# Coble Village MHP, LLC

2948 Neal Zick Road  
Willard, Ohio 44890

Business: 419-935-0891

FAX: 859-858-0568

RECEIVED

FEB 21 2017

OHIO E.P.A.  
N.W.D.O.

February 17, 2017

Beth Ames  
Northwest District Office  
347 N. Dunbridge Rd.  
Bowling Green, OH 43402

Beth Ames

My Park was built by my Dad in the Spring of 1970. Therefore, I was told that, "Buildings in Ohio built prior to 1998 or that use plumbing material or solder manufactured before 1998 may have materials with greater than 8% lead and are at a higher risk of contributing lead to the drinking water than materials manufactured after 1998. In addition, buildings built and plumbing materials manufactured after 2014 were required to have less than 0.25% lead by weight and have the lowest risk for contributing lead to the drinking water. It should be noted however that, although prohibited, some use of leaded solder or leaded components may have occurred after the prohibitions became effective."

Sincerely


Wally Cook  
Owner of Coble Village



RECEIVED

FEB 21 2017

OHIO E.P.A.  
N.W.D.O.

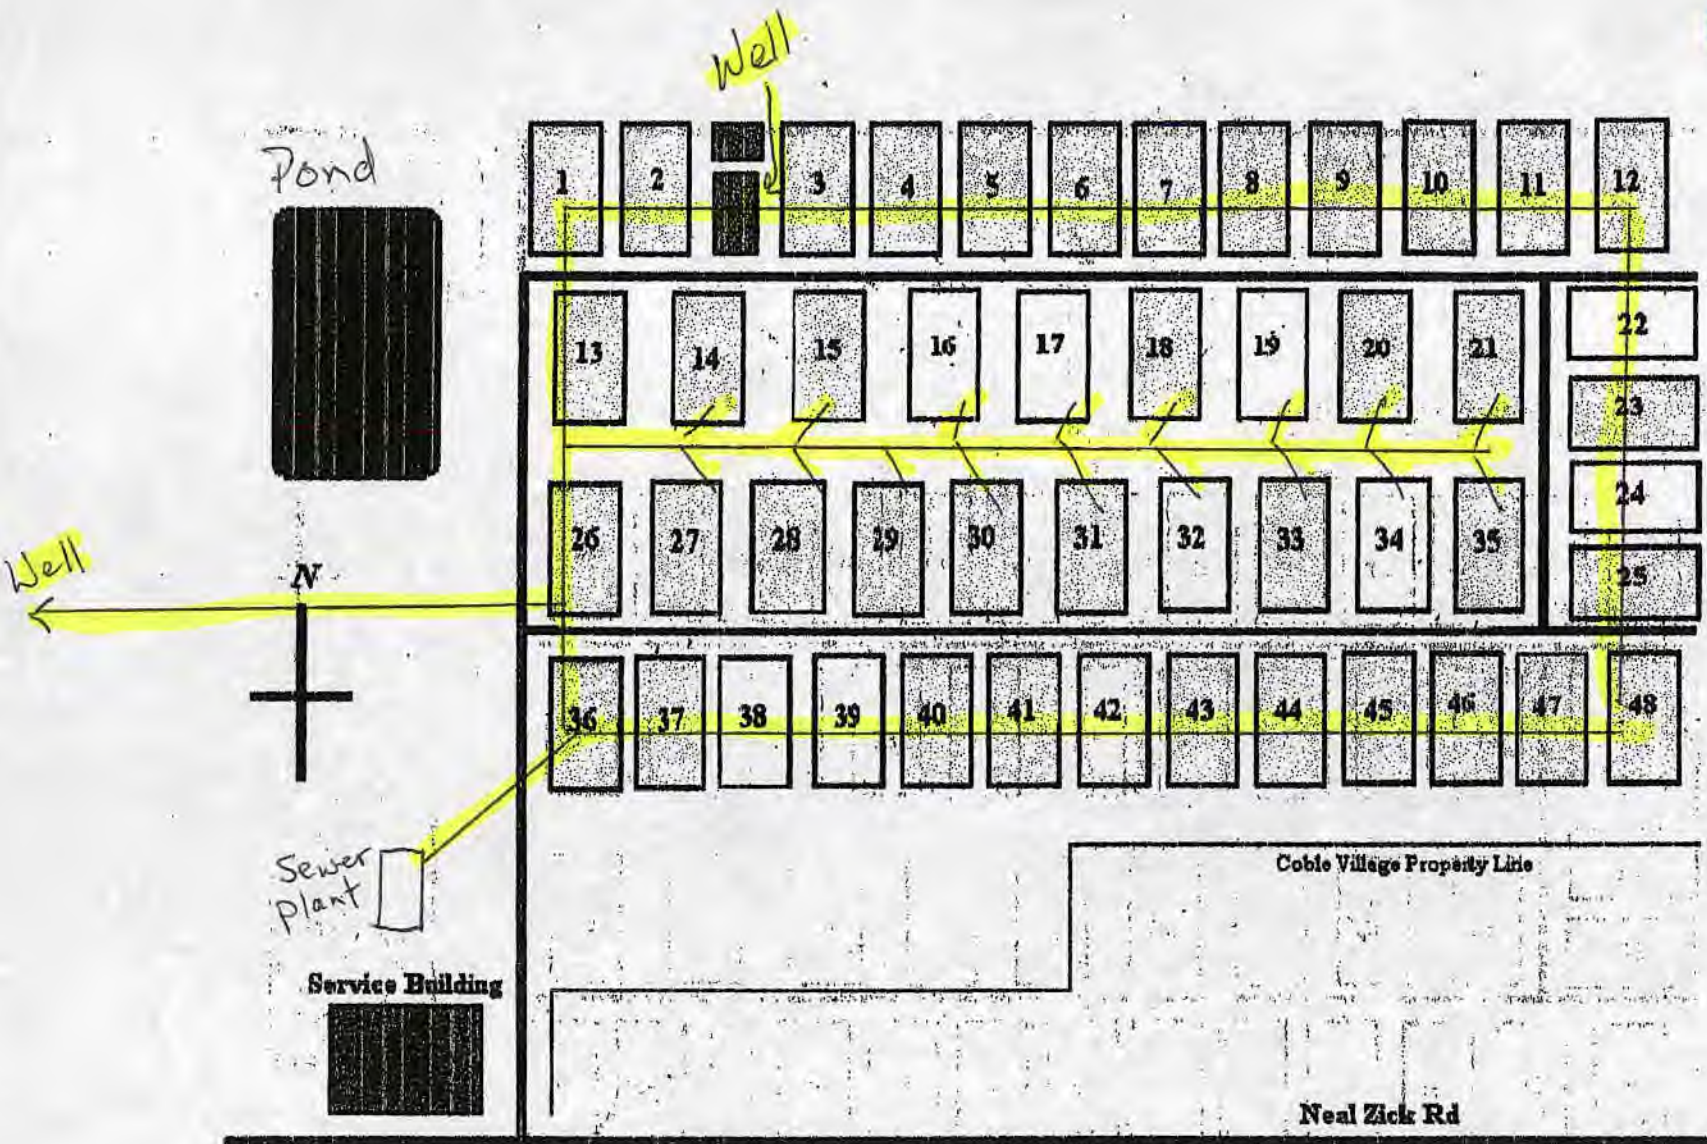

— water line (4")

— Road