



15835 Danville Jelloway Rd.

Danville, Ohio 43014

PH 740-599-7979

The original building was built in 1960 with an addition built in 1986.

The building is served by two wells, Well #1 is located 3' west of the building and has PVC schedule 80 service line to the holding tank, Well #2 is located 120' east of the building and has Copper CuPb>82 service line to the holding tank. The service line to the Truck Shop is copper CuPb<83. The Truck Shop was built before 1983 and is located 81' west of the hatchery building.

All fixtures were installed in or before 1986. The map is marked at the point of the addition to the original building.

Lead and Copper Sample sites are marked on the map, and are as follow.

LC01-Truck Shop Drinking Fountain Tier 1

LC02-Egg Storage Drinking Fountain Tier 2

LC03-Service Room Drinking Fountain Tier 1

LC04-Office Drinking Fountain Tier 1

LC05-Kitchen Sink Tier 1

Entity: Ag Forte
Doc Type: Correspondence
Doc Subtype: ~~Letter~~
Program: DW
County: Knox
Secondary ID: 5992712

Recd. 2/21/17
DEPA/CDD/DW

HB - Hose Bib
MC - Machine Cooling
DF - Drinking Fountain
RR - Rest Room



○ - Lead + Copper Sample Point

HW - Hot Water

Addition 1986

Original BLDG 1960



120' to Well #2

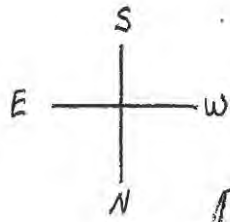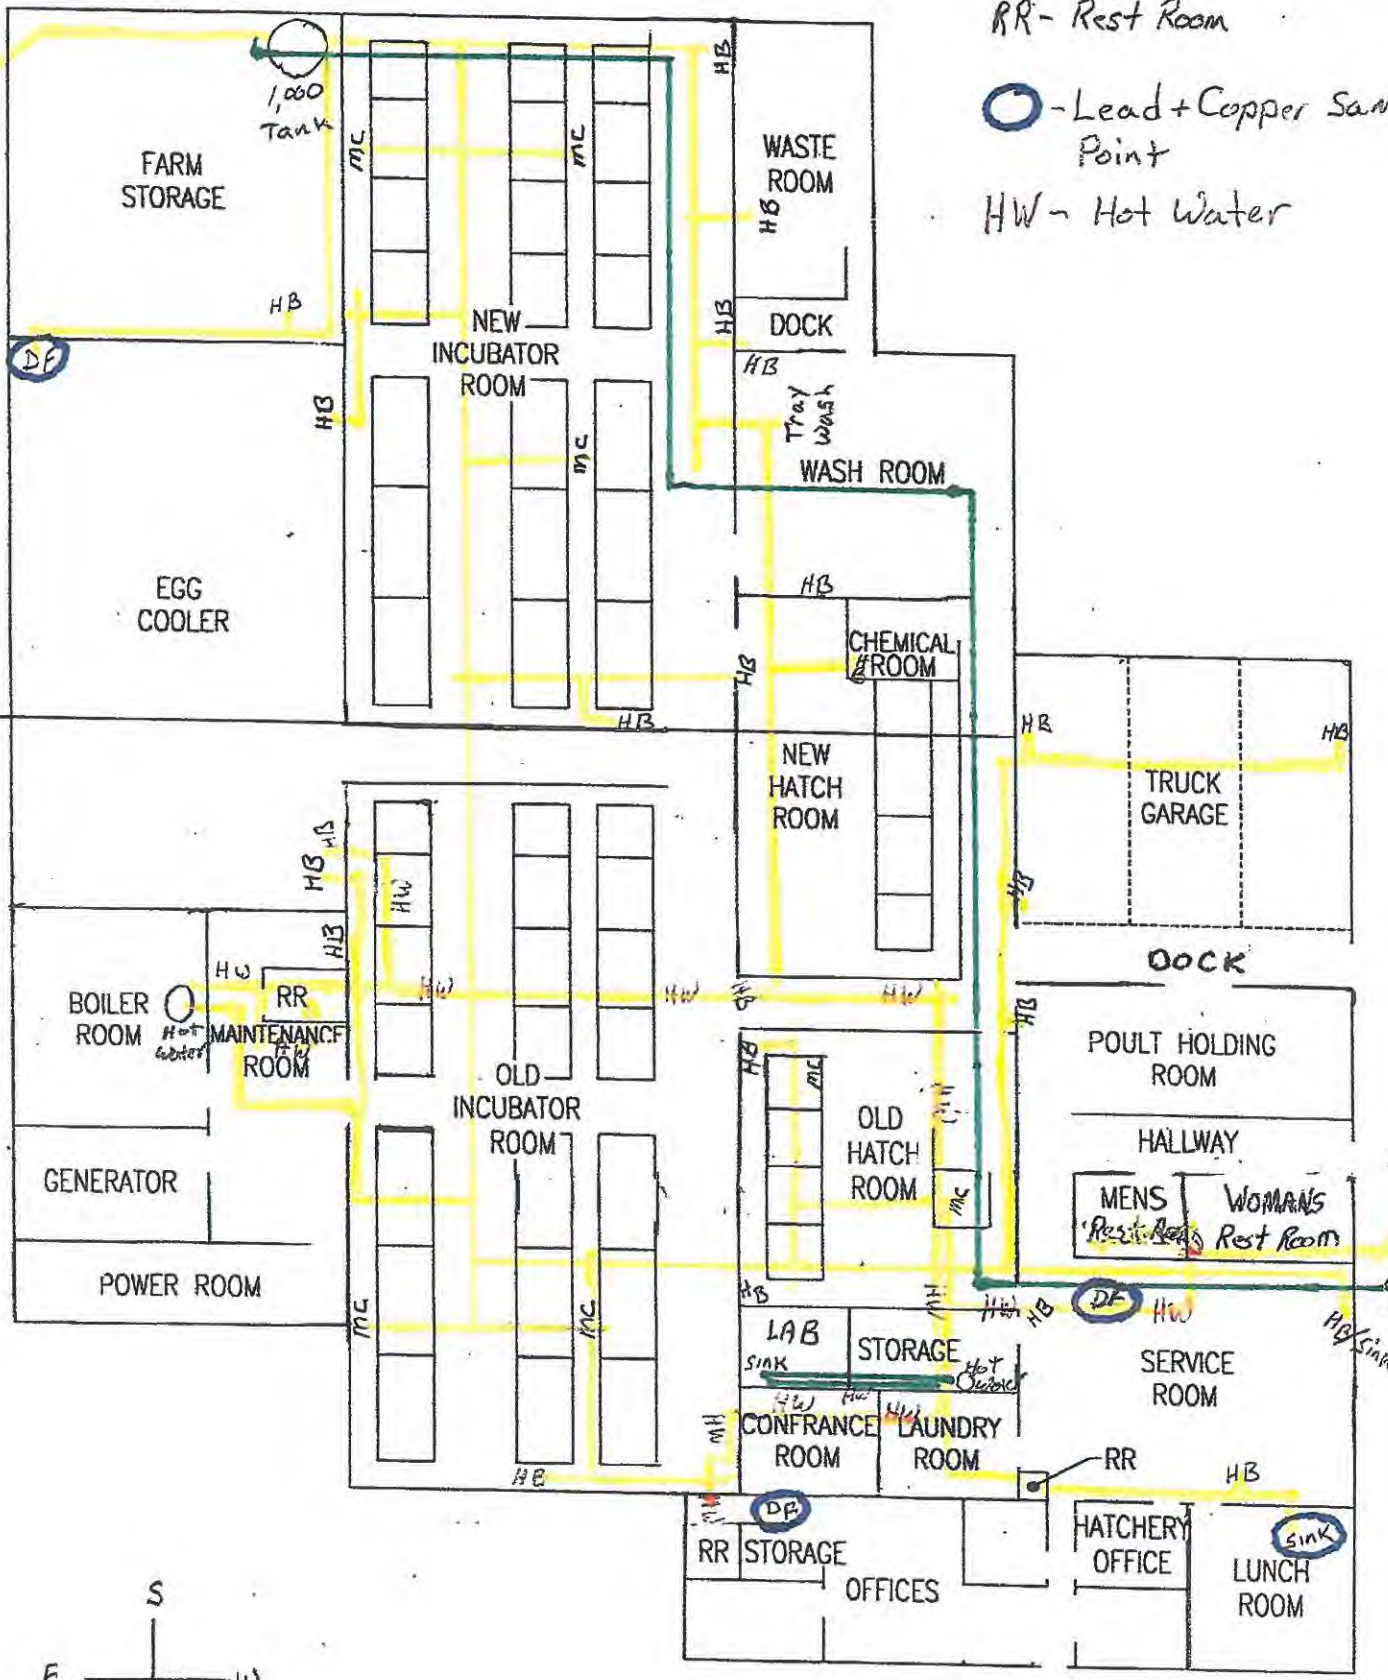

Ag Forte

To Tractor Shop 117' to Well #2

Rec'd 2/2/17

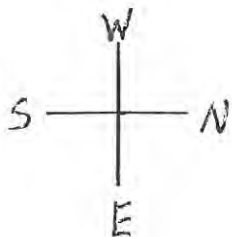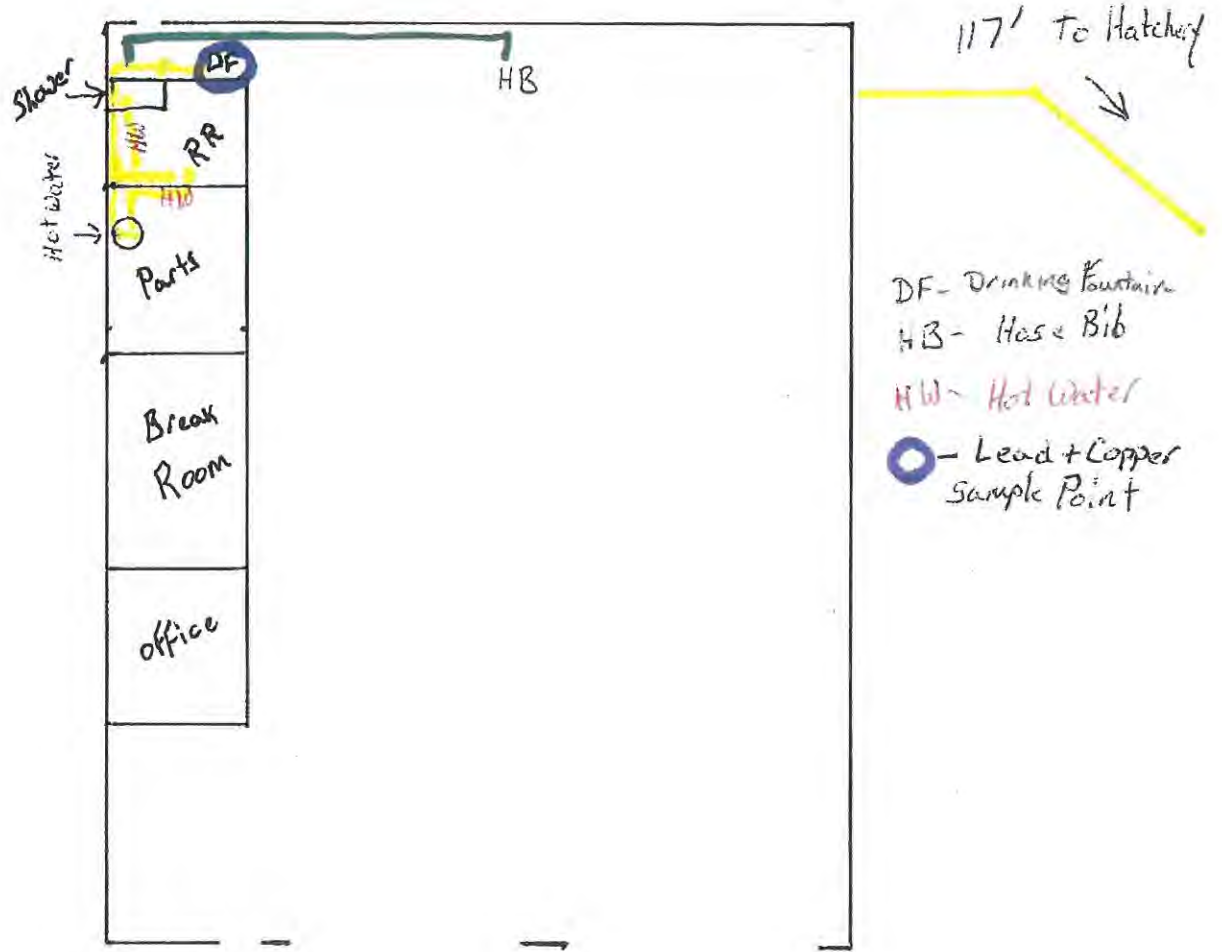

Ag Forte Truck Shop