

# MPW Industrial Services PWS OH4555112

9711 Lancaster Road SE, Hebron, OH 43025


800-827-8790

PWS OH4555112 consist of two buildings on the MPW Industrial Services campus- the ICG Building (2 stories) and the Body Shop (1 story)

1<sup>st</sup> Floor ICG Building

Constructed 1986


**RECEIVED**  
FEB 16 2017  
Central District Office  
Ohio EPA

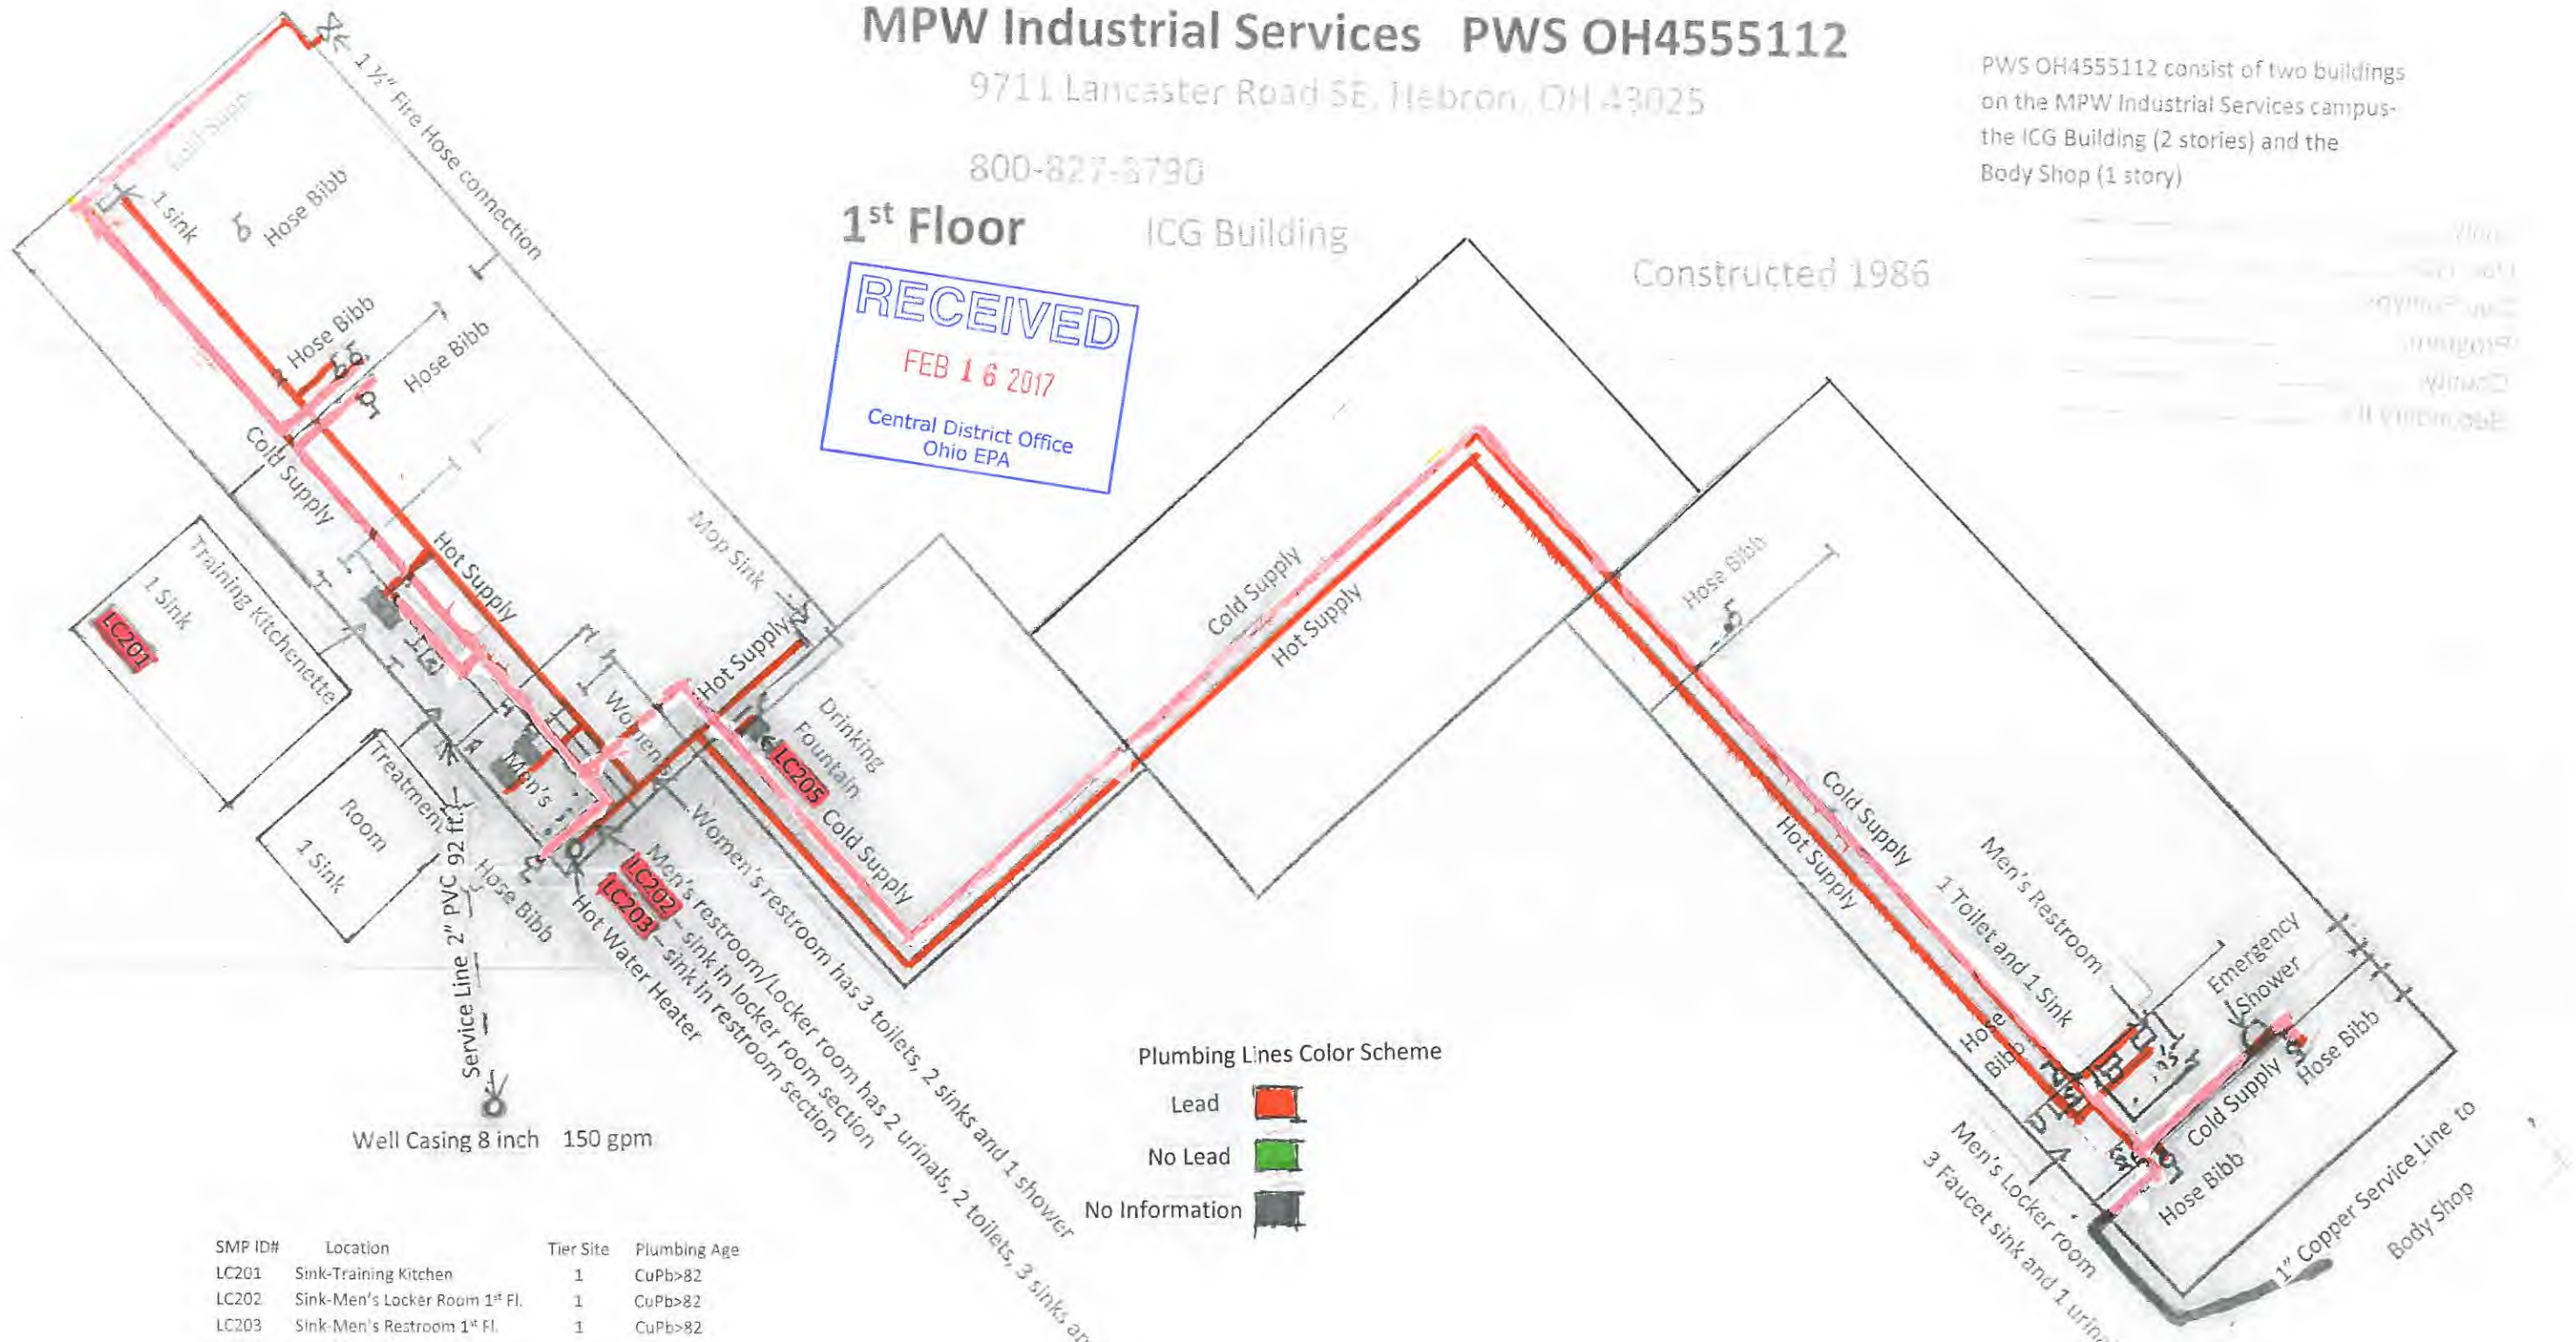

SMP ID#	Location	Tier Site	Plumbing Age
LC201	Sink-Training Kitchen	1	CuPb>82
LC202	Sink-Men's Locker Room 1 <sup>st</sup> Fl.	1	CuPb>82
LC203	Sink-Men's Restroom 1 <sup>st</sup> Fl.	1	CuPb>82
LC204	Sink-Men's Restroom 2 <sup>nd</sup> Fl.	1	CuPb>82
LC205	Drinking Fountain 1 <sup>st</sup> Fl.	1	CuPb>82

The ICG Building was constructed in 1986. All plumbing supply lines are copper ranging in size from 2 inch down to ½ inch. There are no lead lines based on inspection of plumbing and the material called out on construction drawings. However, there is strong evidence that there are fixtures or solder with high lead content based on lab analysis of lead and copper sampling. Because of the possible lead content in the plumbing, Orthophosphate is used in the treatment process for corrosion control.

Plumbing, solder and fixtures produced before 1986 had no limit on the lead content. From 1986 to 2014 the plumbing, fixtures and solder could contain up to 8.0% lead. In 2014 plumbing, fixtures and solder were limited to 0.25% lead.

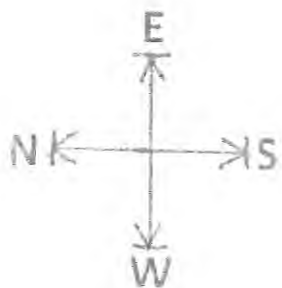

# MPW Industrial Services PWS OH4555112


9711 Lancaster Road SE, Hebron, OH 43025

800-827-8790

2<sup>nd</sup> Floor ICG Building

PWS OH4555112 consist of two buildings on the MPW Industrial Services campus- the ICG Building (2 stories) and the Body Shop (1 story).

Constructed 1986

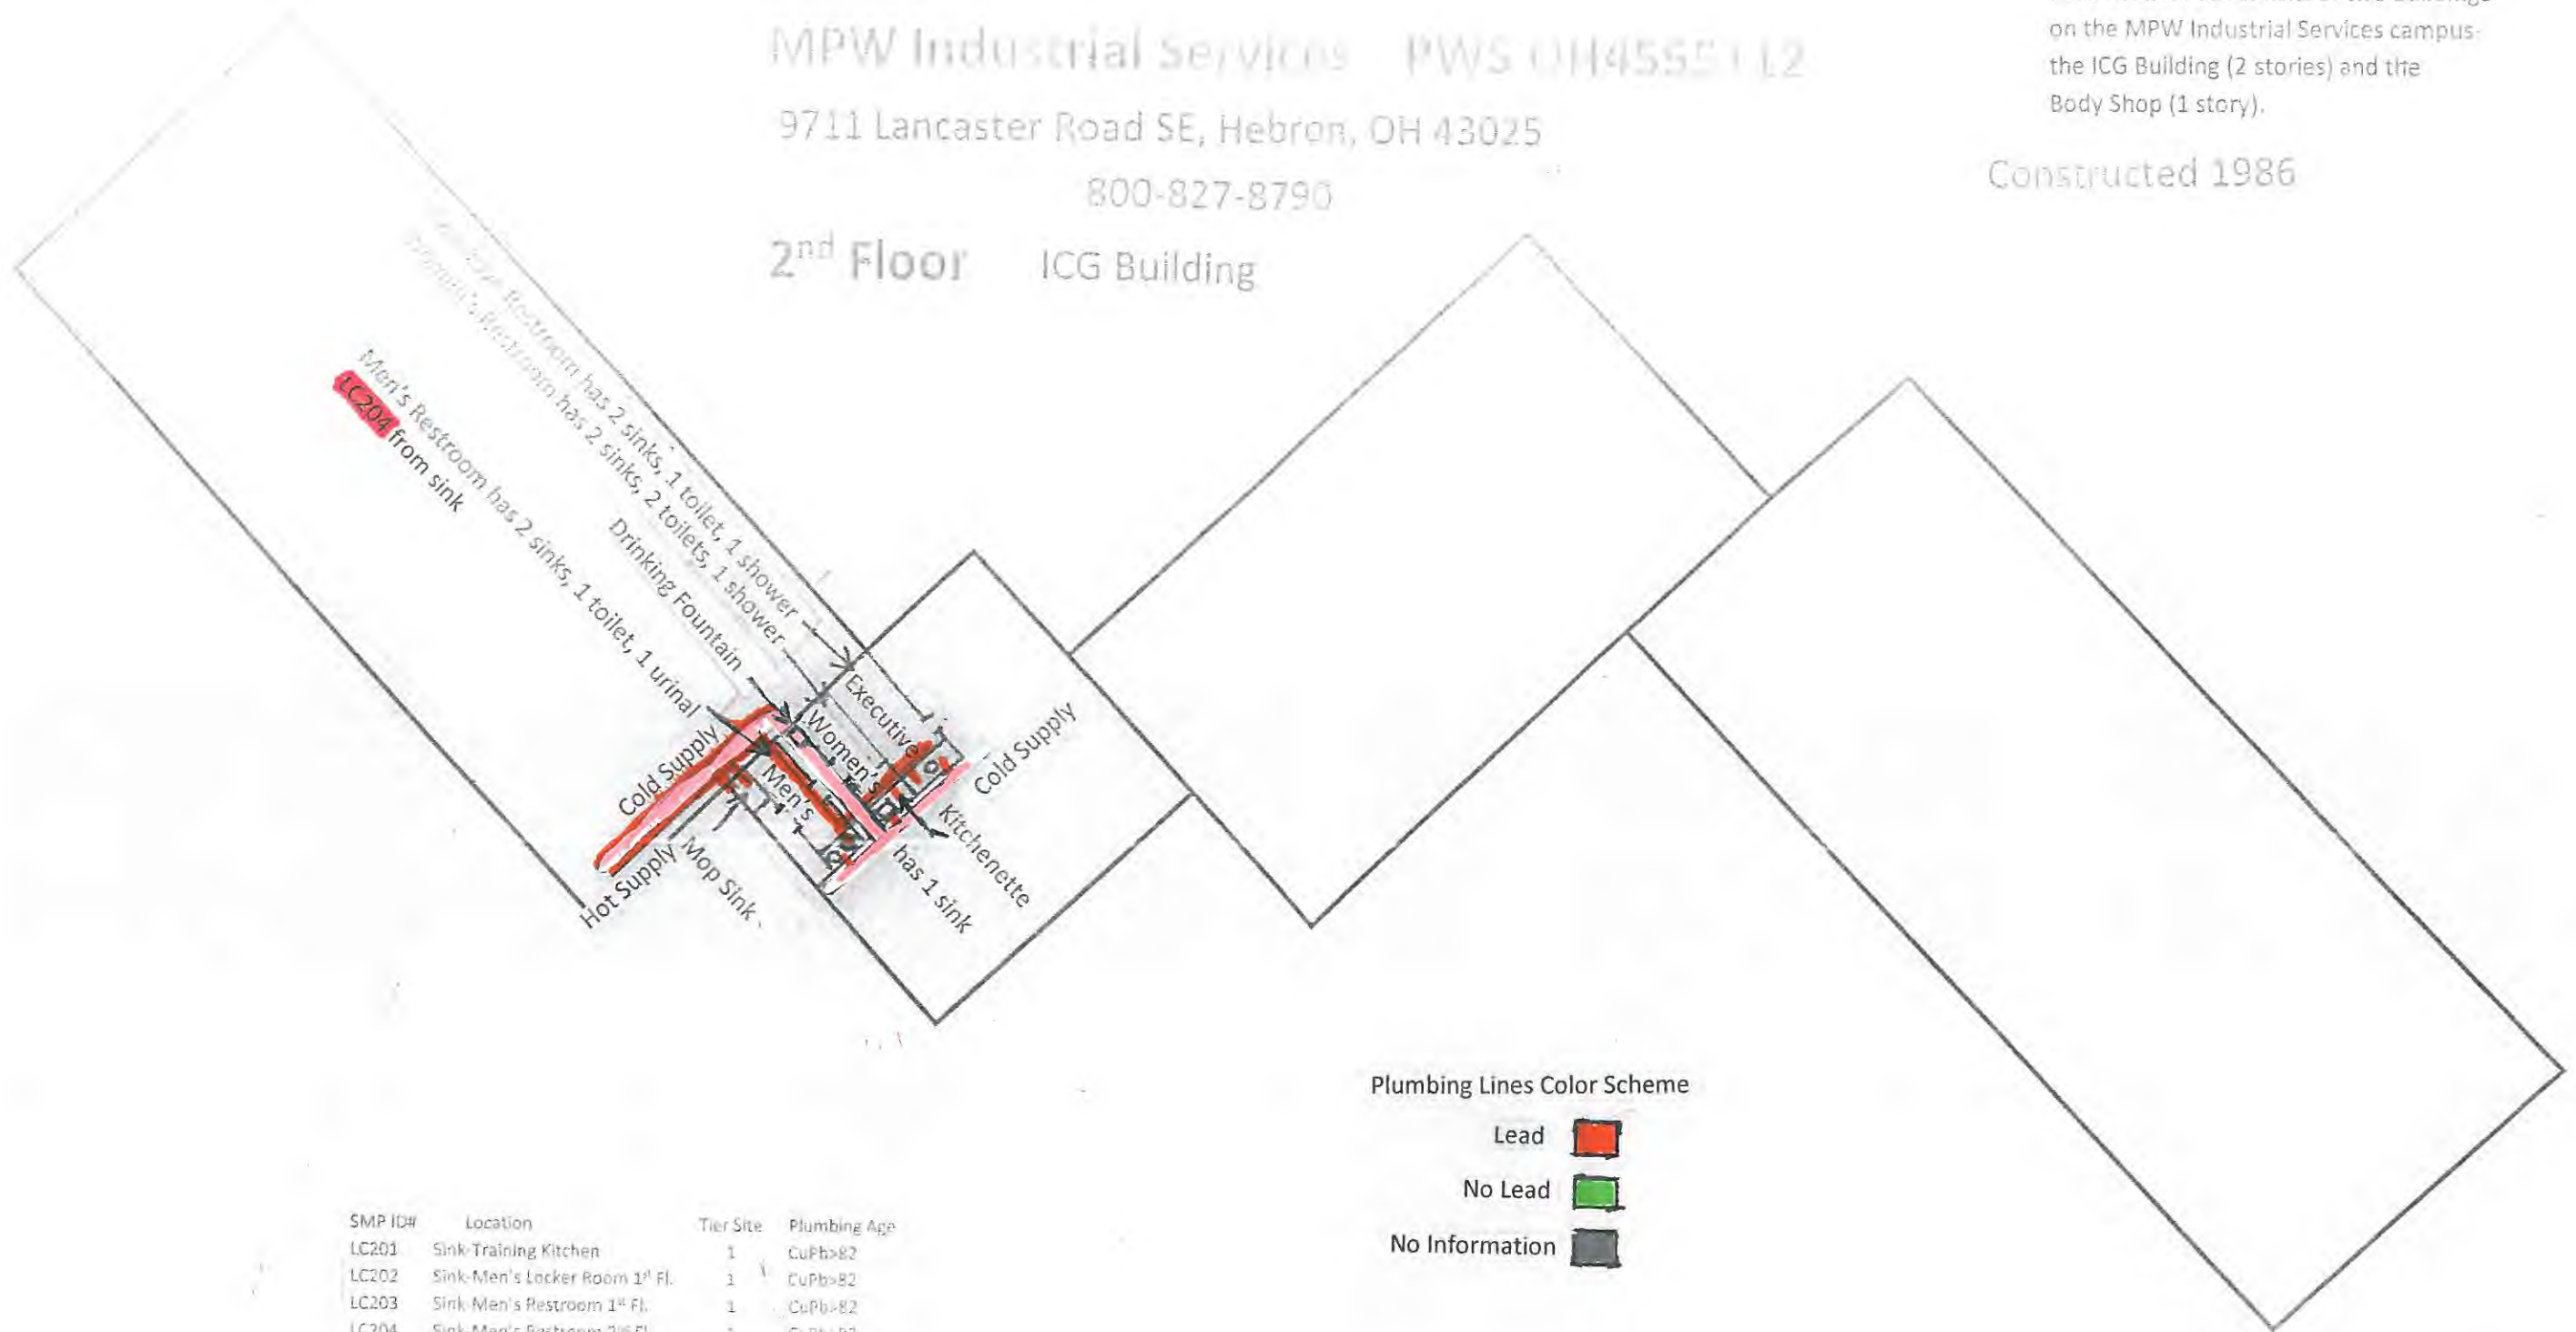



Men's Restroom has 2 sinks, 1 toilet, 1 shower  
**LC204** from sink


Women's Restroom has 2 sinks, 2 toilets, 1 shower  
 Drinking Fountain  
 Hot Supply  
 Cold Supply  
 Mop Sink

Executive  
 Women's Restroom has 1 sink  
 Kitchenette  
 Cold Supply


### Plumbing Lines Color Scheme

Lead 

No Lead 

No Information 

SMP ID#	Location	Tier Site	Plumbing Age
LC201	Sink-Training Kitchen	1	CuPb>82
LC202	Sink-Men's Locker Room 1 <sup>st</sup> Fl.	1	CuPb>82
LC203	Sink-Men's Restroom 1 <sup>st</sup> Fl.	1	CuPb>82
LC204	Sink-Men's Restroom 2 <sup>nd</sup> Fl.	1	CuPb>82
LC205	Drinking Fountain 1 <sup>st</sup> Fl.	1	CuPb>82

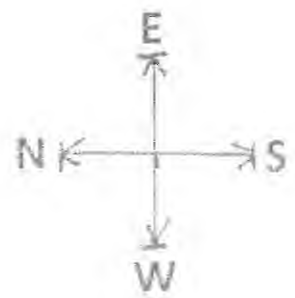

The ICG Building was constructed in 1986. All plumbing supply lines are copper ranging in size from 2 inch down to 1/8 inch. There are no lead lines based on inspection of plumbing and the material called out on construction drawings. However, there is strong evidence that there are fixtures or solder with high lead content based on lab analysis of lead and copper sampling. Because of the possible lead content in the plumbing, Orthophosphate is used in the treatment process for corrosion control.

Plumbing, solder and fixtures produced before 1986 had no limit on the lead content. From 1986 to 2014 the plumbing, fixtures and solder could contain up to 8.0% lead. In 2014 plumbing, fixtures and solder were limited to 0.25% lead.

Map Current for 2017




9711 Lancaster Road SE, Hebron, OH 43025

800-827-8790


Body Shop

EXISTING BUILDING (1 story) on the MPW Industrial Center -  
EXISTING BUILDING (2 stories) and the  
Body Shop (1 story)

Constructed 1989

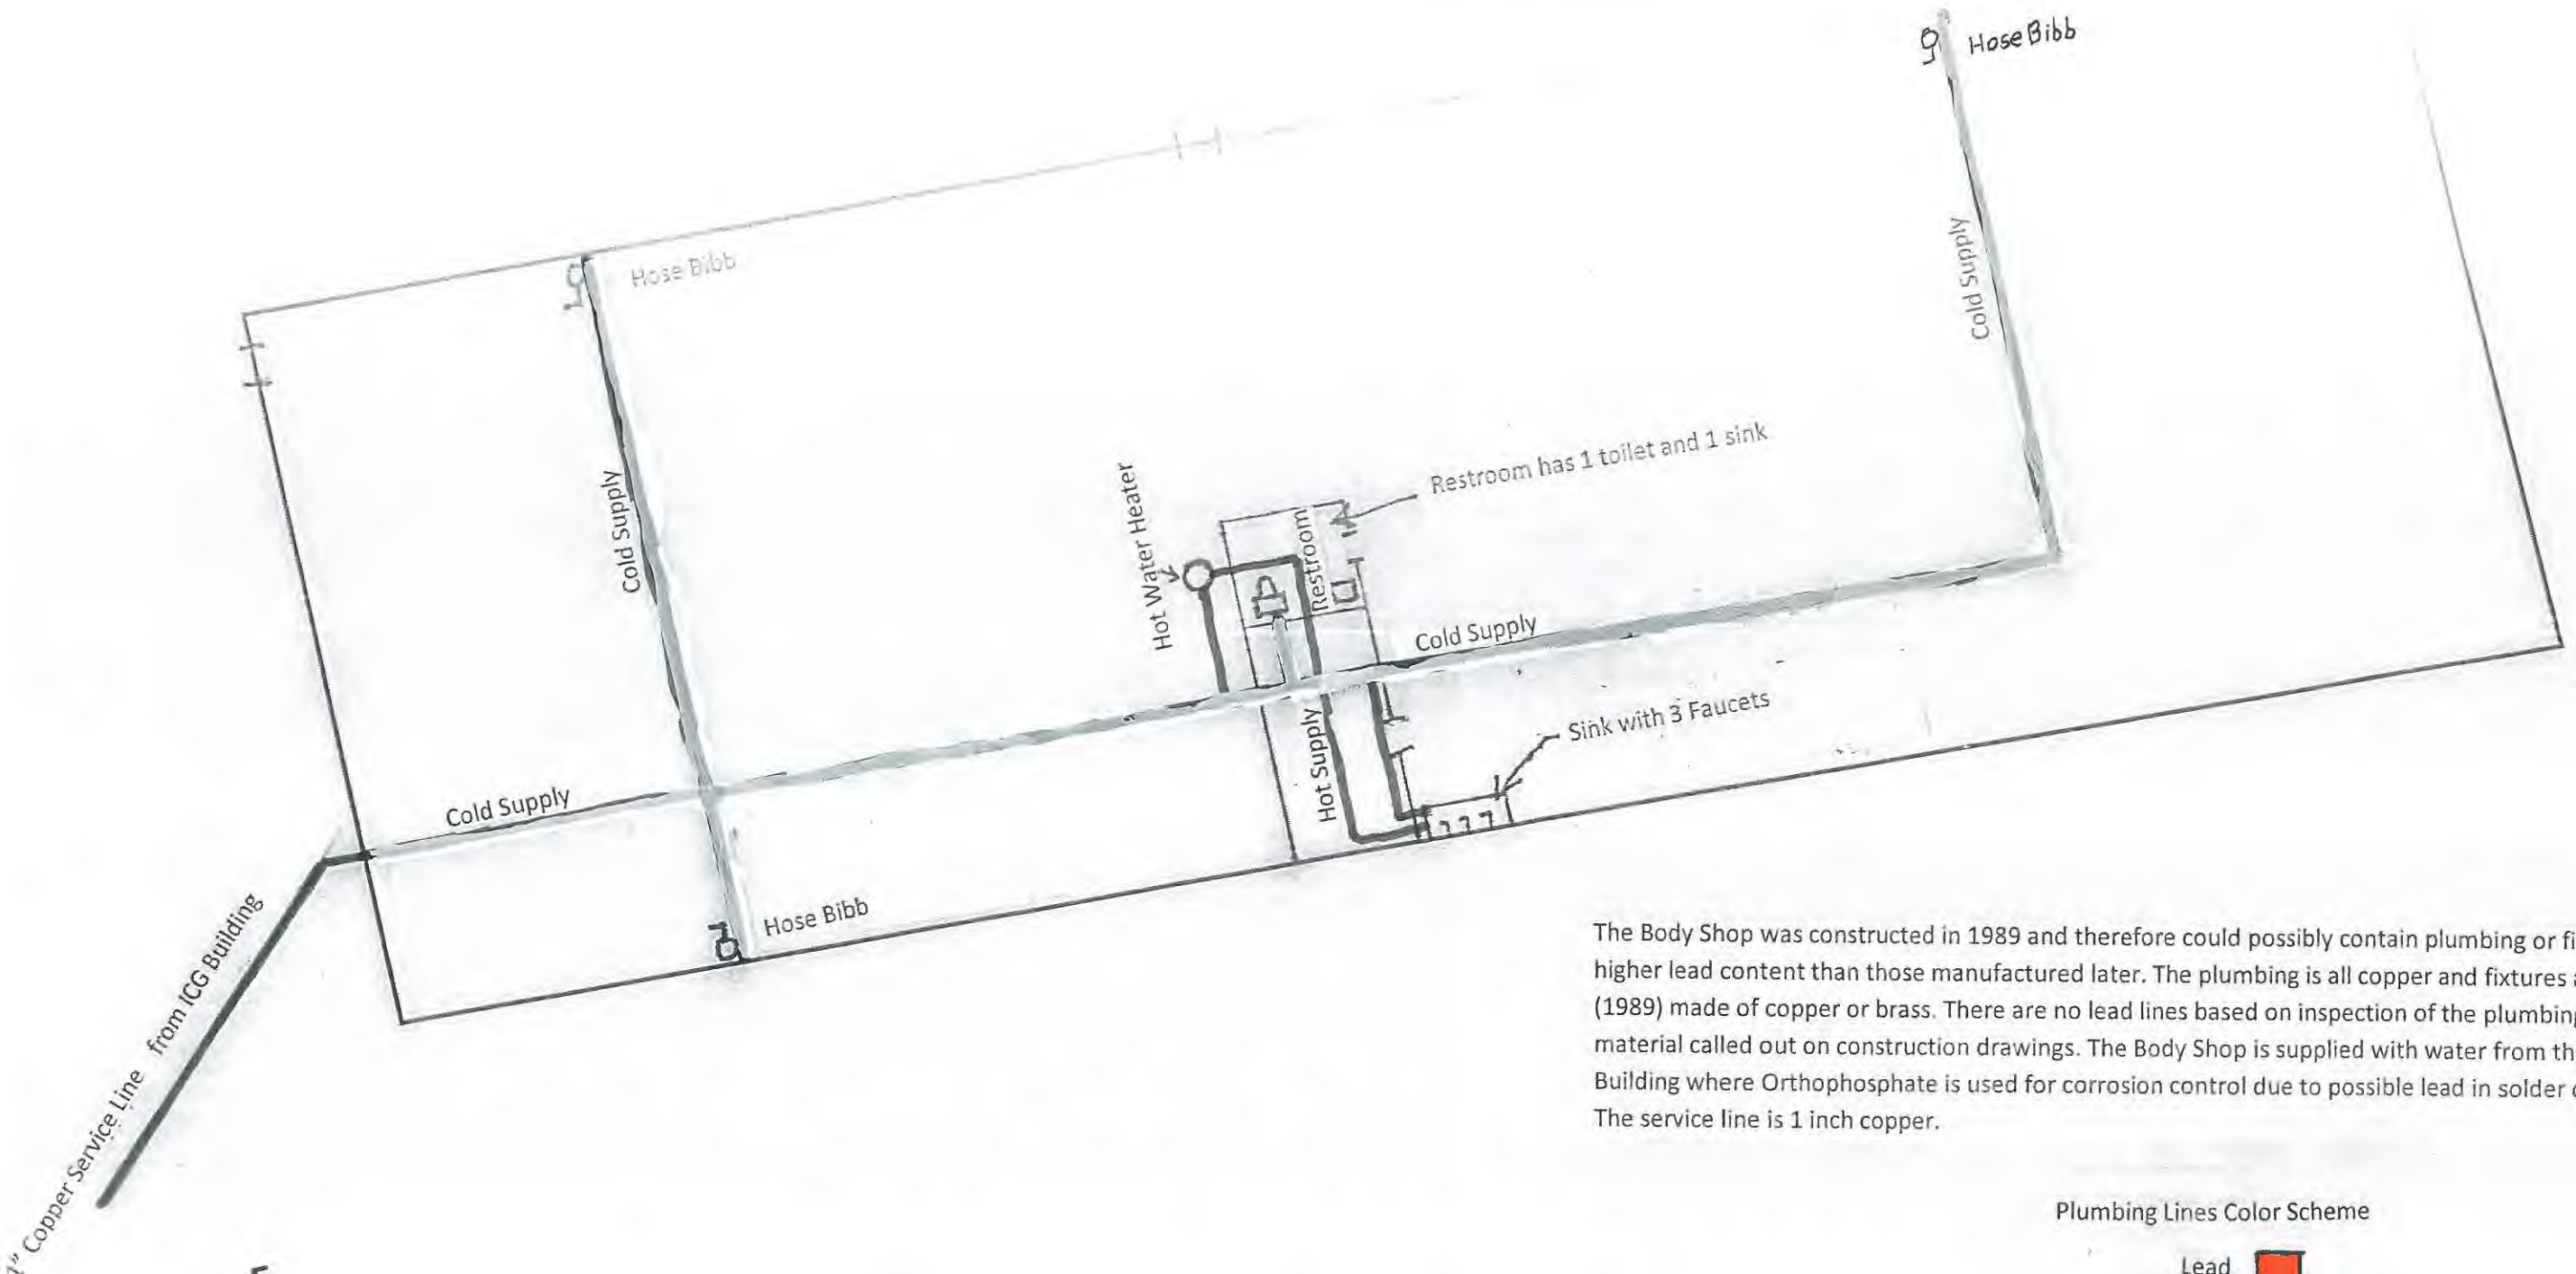

The Body Shop was constructed in 1989 and therefore could possibly contain plumbing or fixtures with higher lead content than those manufactured later. The plumbing is all copper and fixtures are original (1989) made of copper or brass. There are no lead lines based on inspection of the plumbing and material called out on construction drawings. The Body Shop is supplied with water from the ICG Building where Orthophosphate is used for corrosion control due to possible lead in solder or fixtures. The service line is 1 inch copper.

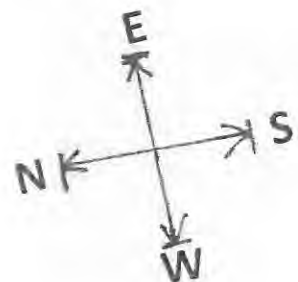


Plumbing, solder and fixtures produced before 1986 had no limit on the lead content.  
 From 1986 to 2014 the plumbing, fixtures and solder could contain up to 8.0% lead.  
 In 2014 plumbing, fixtures and solder were limited to 0.25% lead.

Plumbing Lines Color Scheme

- Lead
- No Lead
- No Information

Map Current for 2017

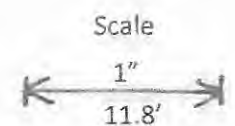

Entity: MPW Industrial Services  
Doc Type: Report  
Doc Subtype: NA  
Program: Drinking Water  
County: Licking  
Secondary ID: OH 4555112

date received 02/16/2017