


Well - 2009

* PLUMBING REPLACED TO PVC.

PLAINVIEW CHRISTIAN SCHOOL
OH 43063
8270 AMISA PIKE
PLAIN CTRY, OH 43069
614-579-6205

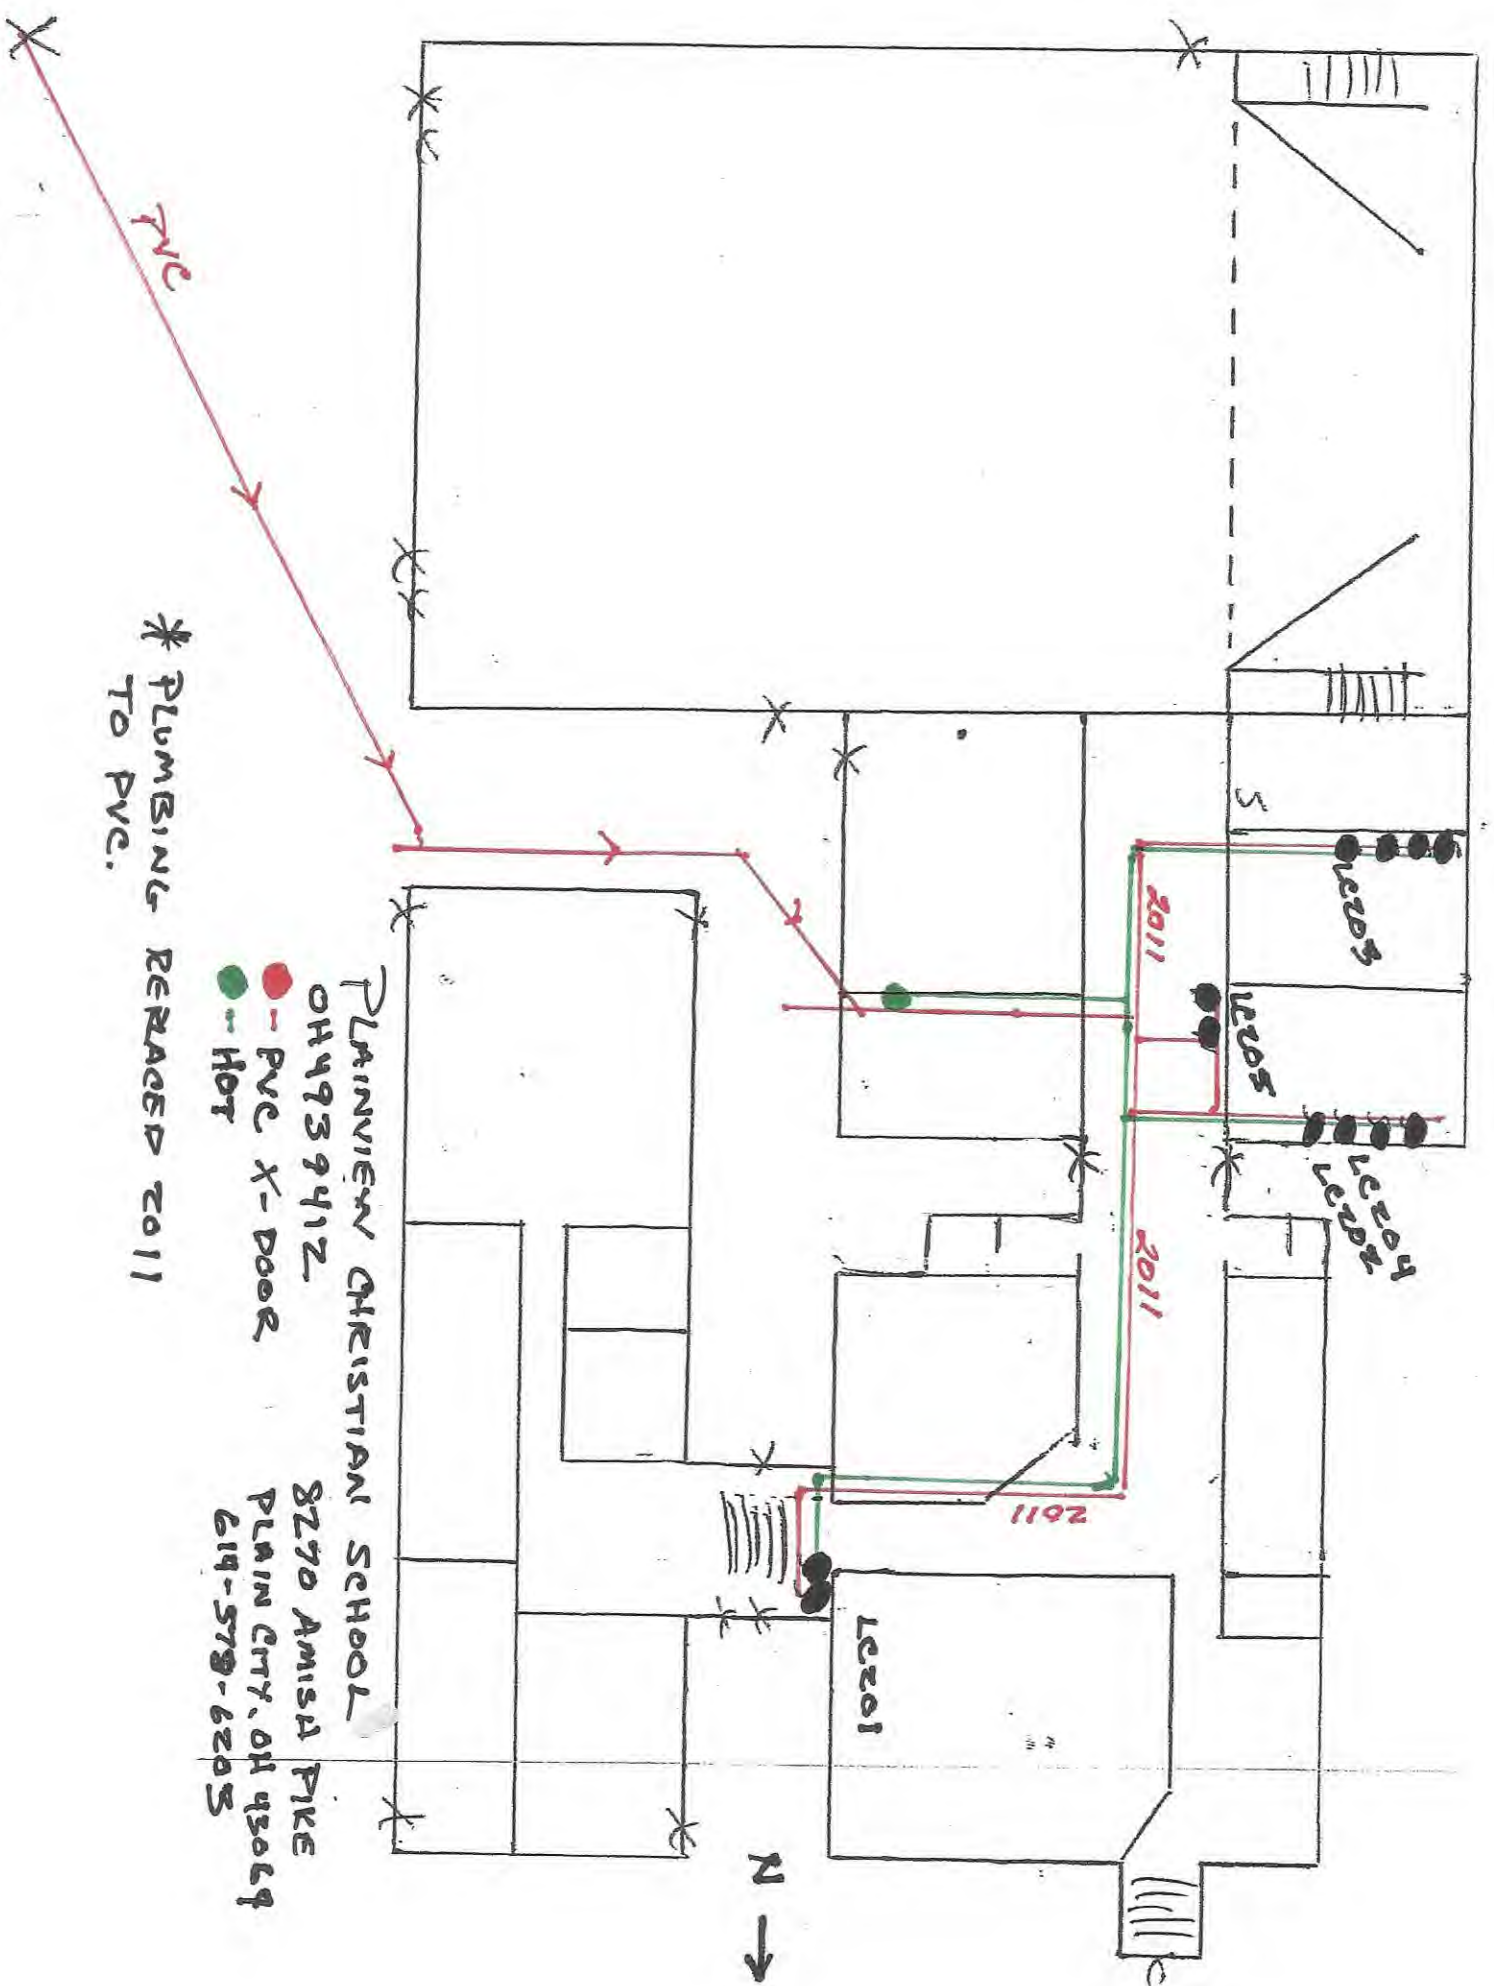

N →