


Rec'd 2/13/17
OEPA 100/10W

Building was constructed by OSFC in 2011
 Building is lead pipe + Solder Free
 Service line - ductile IRON
 Wells - PVC
 Distribution lines - Copper

Yellow - Pb/Cu Sample Sites

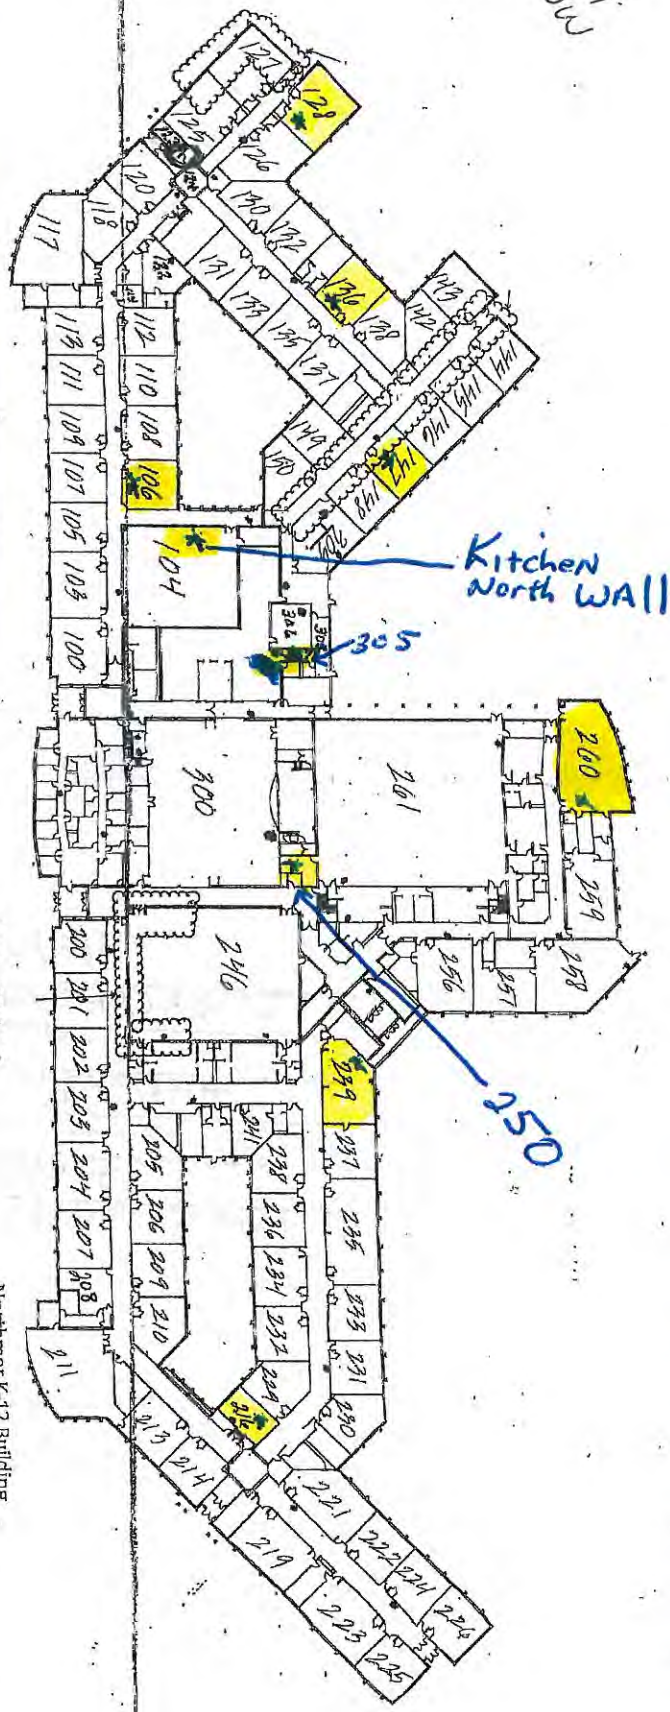

Lead + Copper Sample Monitoring Points

Name of School: Northmor K-12 Building
 Address of School: 7819 State Route 19 Galion Ohio 44833

PWS Name	PWS ID	Type of System	Contact Name	Phone	Email
Northmor Local School	OH5942112	Nontransient Noncommunity	John B. Smith	419-571-9182	Smith.john@northmor.k12.oh.us