

440-729-7898

OH 2864612

COMMUNITY CHURCH / PRE-SCHOOL


11984 CAVE RD. CHESTERLAND, OH 44026

MAIN FLOOR



LC 201

LC 205

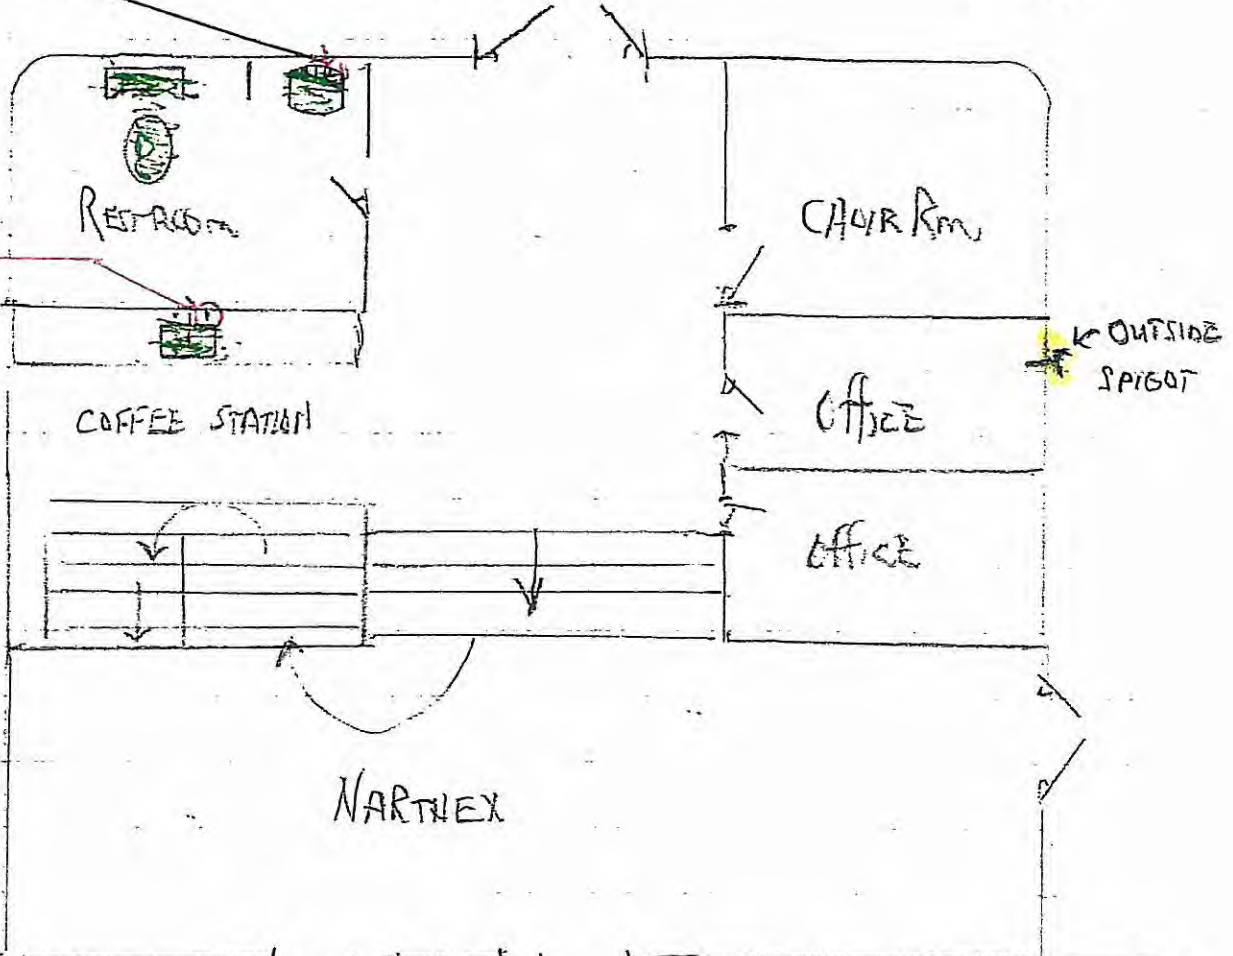

Entity: Community Church/Preschool
 Doc Type: Report
 Program: DPACN
 County: Cuyahoga
 Secondary ID: 2122864612
 eDoc in Color

SANCTUARY

NO PLUMBING IN THIS BLDG. HAS BEEN DONE AFTER 2014.

YELLOW = PLUMBING COMPLETED BEFORE 1982

GREEN = PLUMBING COMPLETED AFTER 1982

RECEIVED
FEB 08 2014

H40-729-7898



COMMUNITY CHURCH / PRE-SCHOOL

1984 CAVES RD. CHESTERLAND, OH 44026



WATER WELL
1" K" COPPER

LOWER LEVEL

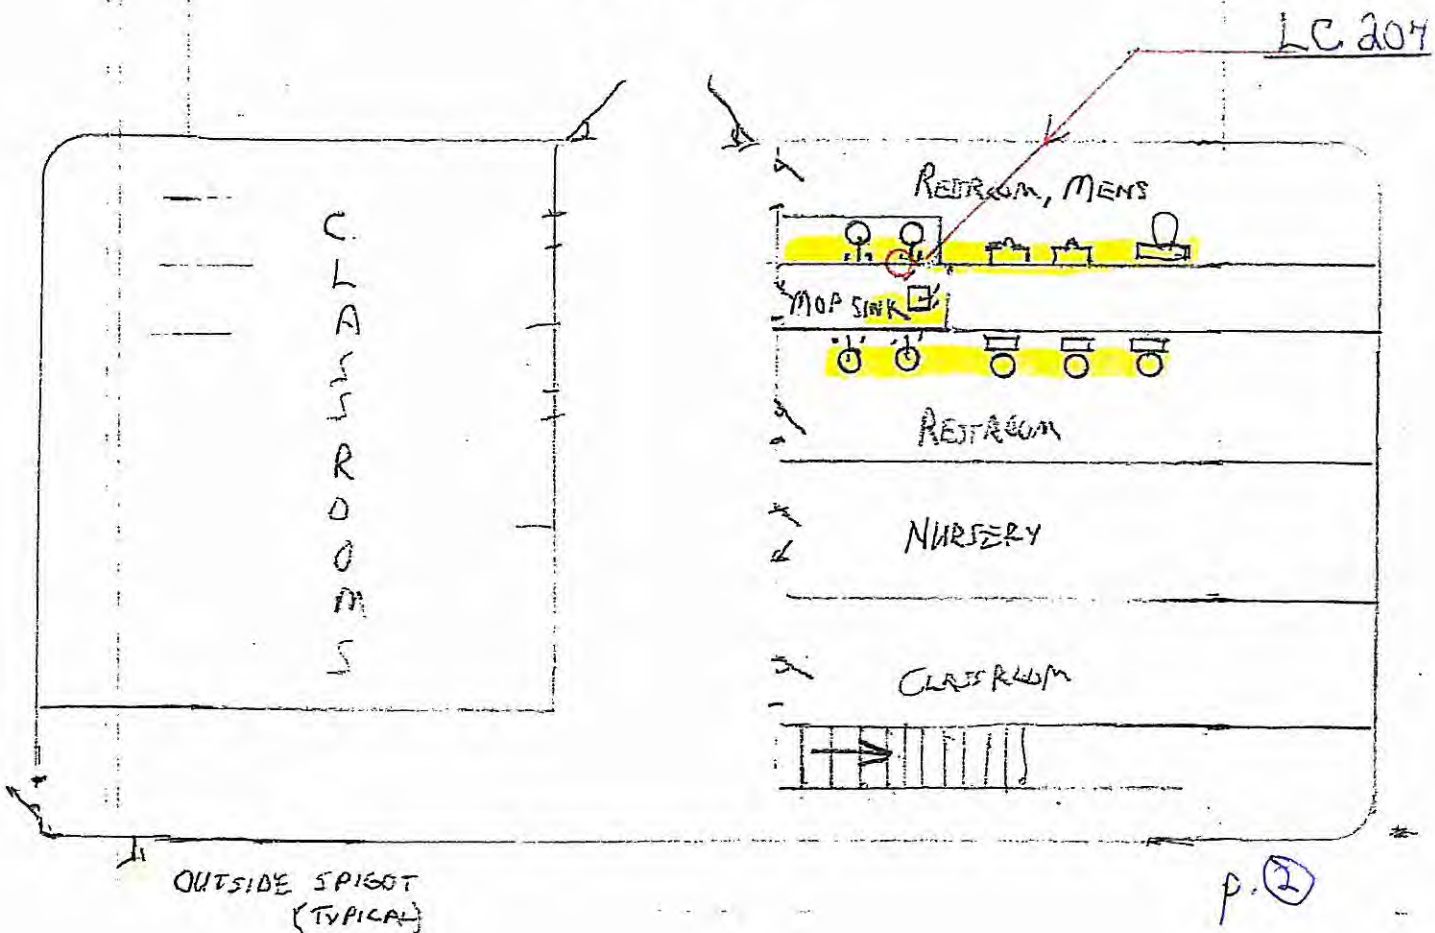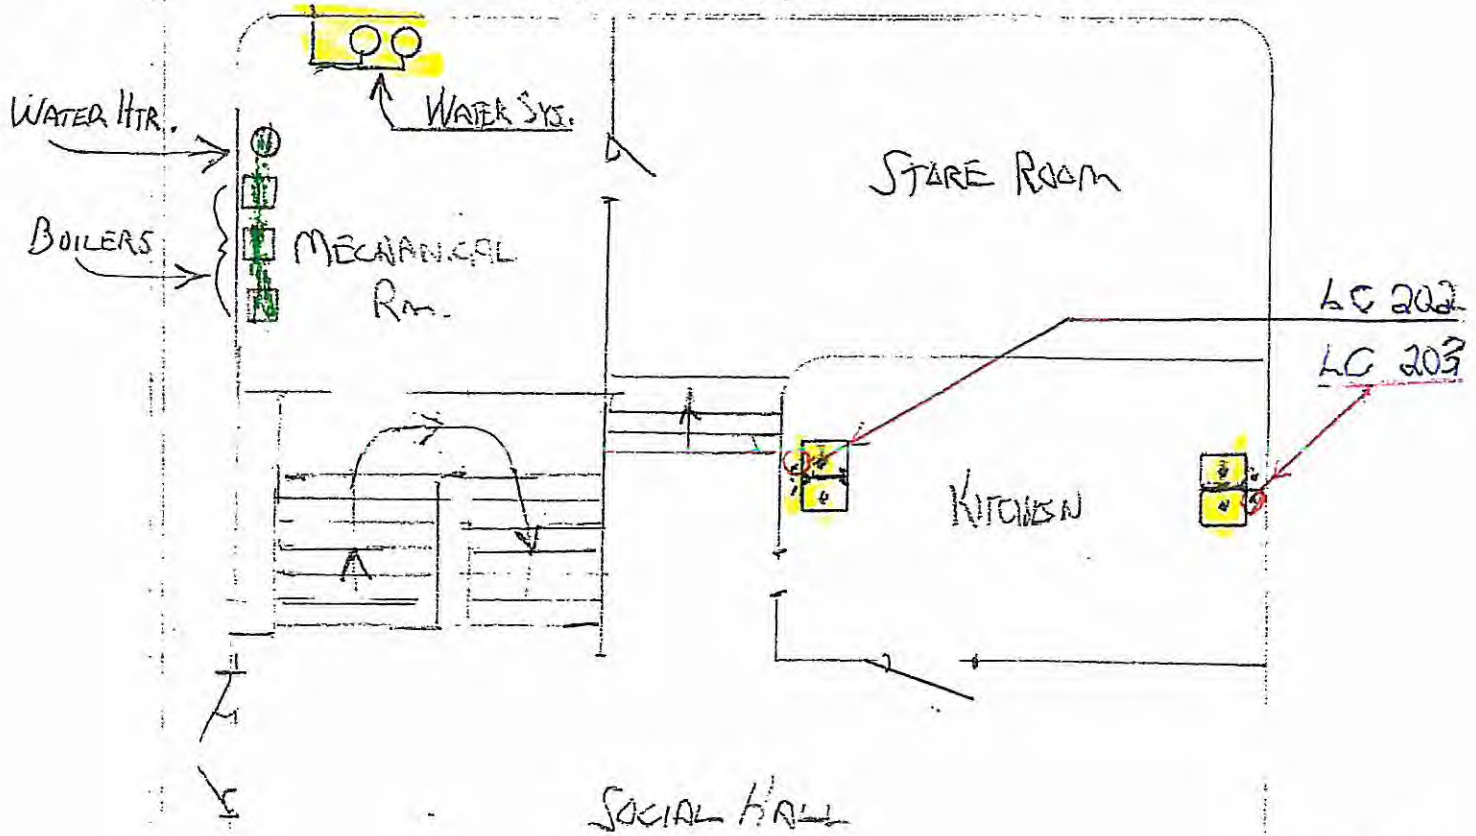

440-729-7298

COMMUNITY CHURCH/PRE-SCHOOL
11984 CAVES RD. WESTERLAND, OH 44026

NOTES:

1) TIER 1 SITES ARE AS FOLLOWS:

LC 201 = MAIN FLOOR RR CHINA FACE BOWL

LC 202 = WEST SIDE DBLE. BOWL SS KITCHEN
SINK

LC 203 = EAST SIDE DBLE. BOWL SS KITCHEN
SINK

LC 204 = LEFT HAND CHINA FACE BOWL IN
MENS RR

LC 205 = SS SELF RIMMING SINK AT COFFEE
STATION.

2) A WATER WELL SUPPLIES THE CHURCH/PRE-SCHOOL
WATER (SEE ATTACHED WELL LOG)

3) THE SERVICE LINE FROM WELL IS 1" R" COPPER.

4) THE DOMESTIC WATER IS SUPPLIED THROUGHOUT
THE BLDG. W/ TYPE "L" COPPER PIPING.

5) THE BUILDING WAS BUILT IN 1966.

OPERATOR: JOHN C. FRESHLEY - I.D. 1061900
PHONE 440-336-3650.

P. (3)

WELL LOG AND DRILLING REPORT

Ohio Department of Natural Resources
 Division of Water, 1939 Fountain Square Drive
 Columbus, Ohio 43224 Phone (614) 265-6739

839335

Page 1 of 1

Permit Number
 Lot

COUNTY SEAUCA
 Owner

TOWNSHIP CHESTER

SECTION/LOT No.
 (Circle One)

OWNER/BUILDER COMMUNITY CHURCH/CHESTERLAND
 (Circle One or Both) First Last

PROPERTY ADDRESS
 (Address of well location) Number Street City

11984 CAVES RD CHESTERLAND OH 44026

LOCATION OF PROPERTY NORTH WEST CORNER OF WILSON HILLS AND CAVES RD

Zip Code + 4

CONSTRUCTION DETAILS

CASING *(Length below grade) Borehole Diameter 9 1/4 in.
 Diameter 6 5/8 in. Length* 100 ft. Wall Thickness SDR21 in. Material BENSEAL Volume used 300#
 Diameter _____ in. Length* _____ ft. Wall Thickness _____ in. Method of installation TREMBIE TUBE
 Type: Steel Galv. PVC Other _____
 Joints: Threaded Welded Solvent Other CERTA-LOC Material _____ Volume used _____
 Liner: Length _____ Type _____ Wall Thickness _____ in. Depth: placed from _____ ft. to _____ ft.
SCREEN
 Type (wire wrapped, louvered, etc.) _____ Material _____
 Length _____ ft. Diameter _____ in. Rotary Cable Augered Driven Dug Other _____
 Set between _____ ft. and _____ ft. Slot _____ Date of Completion 08/02/96

WELL LOG*

INDICATE DEPTH(S) AT WHICH WATER IS ENCOUNTERED.

Show color, texture, hardness, and formation:
 sandstone, shale, limestone, gravel, clay, sand, etc.

	From	To
BROWN CLAY	0	6
BROKEN SHARON SANDSTONE	6	30
CREAMY AND BROWN SANDSTONE	20	64
SOFT GRAY SHALE	64	95
GRAY SHALE	95	165
BEREA SANDSTONE	165	215
GRAY SHALE	215	220

WELL TEST

Bailing Pumping* Other _____
 Test rate 15 gpm Duration of test _____ hr
 Drawdown 30
 Measured from: top of casing ground level Other _____
 Static Level (depth to water) 170 ft. Date: 08/02/96
 Quality (clear, cloudy, taste, odor) CLOUDY
 *(Attach a copy of the pumping test record, per section 1521.05, ORC)


PUMP

Type of pump _____ Capacity 0 gp
 Pump set at _____ ft.
 Pump installed by _____

WELL LOCATION

Location of well in State Plane coordinates, if available:
 Zone _____ x _____ y _____
 Elevation of well _____ ft./m. Datum plain: NAD27 NAD83
 Source of coordinates: GPS Survey Other _____

Sketch a map showing distance well lies from numbered state highways, street intersections, county roads, buildings or other notable landmarks.

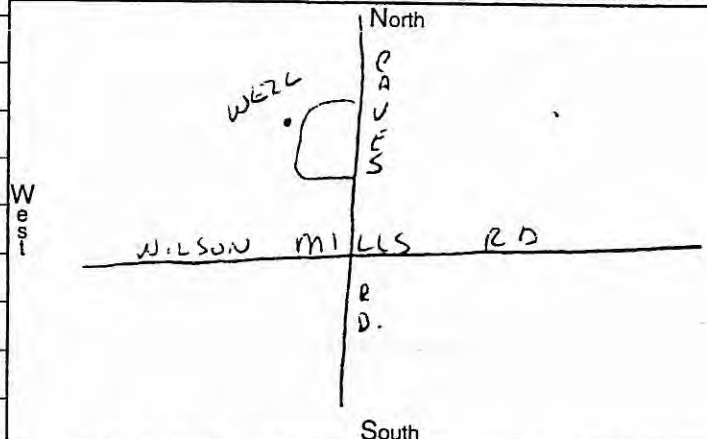

*(If additional space is needed to complete well log, use next consecutively numbered form.)

I hereby certify the information given is accurate and correct to the best of my knowledge

Drill Firm FREDEBAUGH WELL DRILLING, INC.

Signed Mark Fredelberg (w)

Address P.O. Box 266

Date 08.07/96

City, State, Zip Grand River, OH 44045

ODH Registration Number 004