

RE: Five Point MHP  
Report  
Drinking Water Program  
Wood County  
PWS ID: OH8704312

FEB 26 2017

Date: February 23, 2017

**Five Point MHP Lead Mapping additional information** DDAGW - NWDO

The Mobile Home Park is listed as a class A community public water supply system.

Address is 24370 McCutcheonville Rd.

Telephone No. 419 893-4879

The PWS ID No. is OH8704312 and the Facility ID is 8759928

The Mobile Home Park has 32 spaces for homes with 2 vacant lots.

The Mobile home park was constructed in the early 70's.

The Water mains consist of 2 inch PVC, with service lines consisting of galvanized pipe and PEX pipe.

The map included on page 1 is color coded as follows:

Green - Water mains

The map included on page 2 is color coded as follows:

Yellow - Trailers built before 1986

Orange - Trailers built between 1986-2013

Green - Trailers built 2014 or newer

Lots 21 and 26 are vacant with no building currently on lot.

All submitted information compiled by:

**Ronald Suter**

Operator of record

Five Point MHP

Tele: 419 806-6828

E-Mail [rrsuter@yahco.com](mailto:rrsuter@yahco.com)

**Trace Meyer**

Property Owner

Five Point MHP

Tele: 419 893-4879

E-Mail [trace@pmsc1.com](mailto:trace@pmsc1.com)

Five Point MHP  
 24370 McCutcheonville Rd.  
 Perrysburg, OH 43551

PWS ID# OH8704312  
 Facility ID# 8759928

Color Code

Yellow - Trailer built before 1986

Orange - Trailer built between 1986 and 2014

Green - Trailer built 2014, 2015, 2016, or 2017

Lots 21 and 26 vacant

5 Point Road

WWTP

Mail boxes




McCutcheonville Rd.

garage WTP


Lead and copper Sample Site locations

Lot #	SMP #
1	LC201
4	LC202
7	LC203
23	LC204
31	LC205

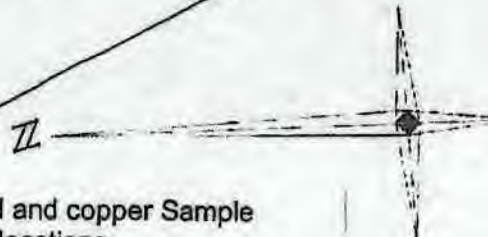

Five Point MHP  
 24370 McCutcheonville Rd.  
 Perrysburg, OH 43551

PWS ID# OH8704312  
 Facility ID# 8759928

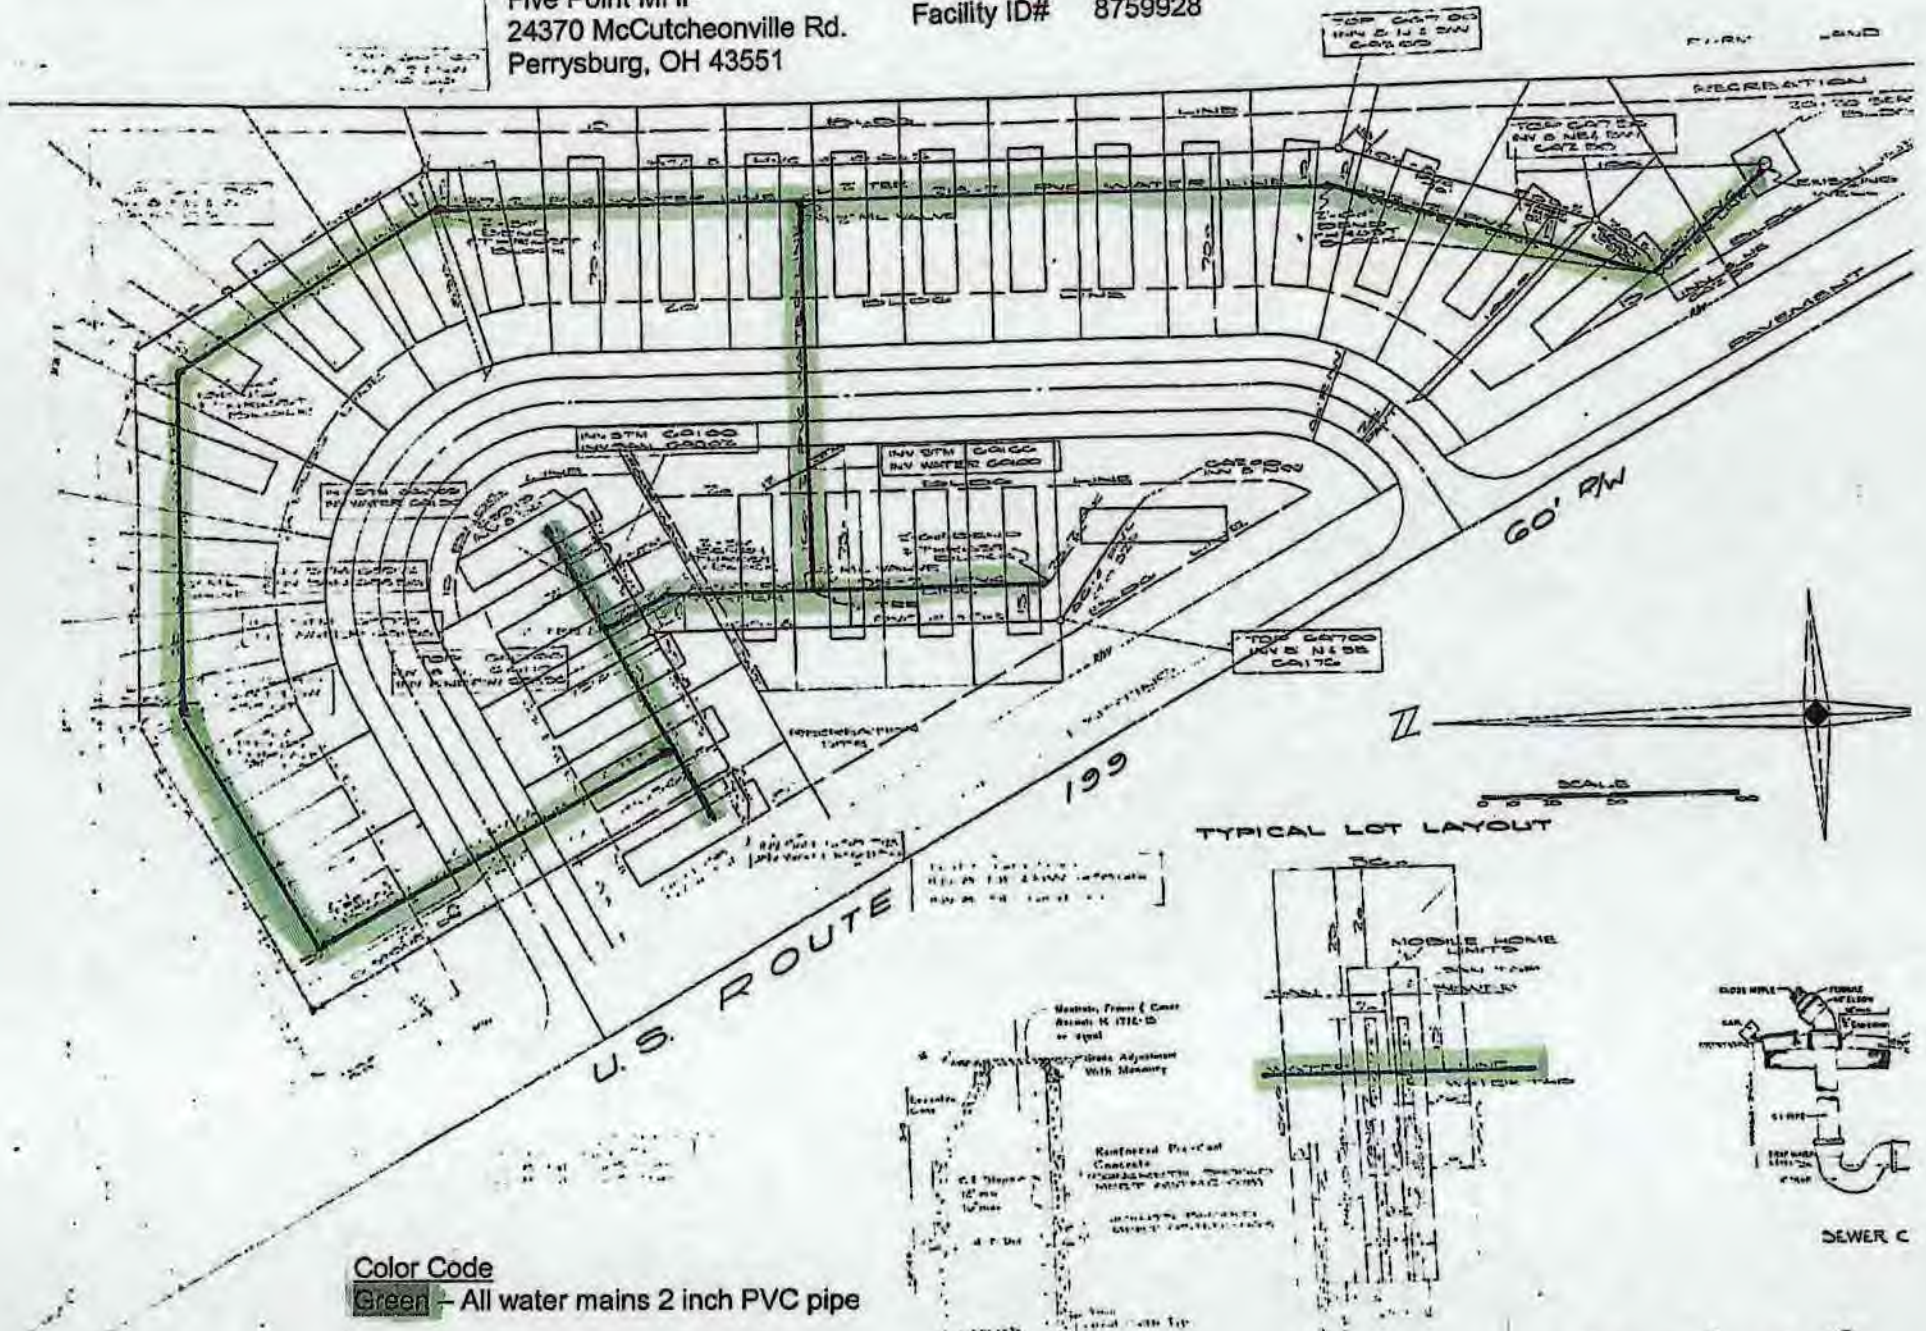

**Color Code**  
 Green - All water mains 2 inch PVC pipe

All service lines Galvanized or PEX pipe