


RE: Toledo Edison – Lindsey Service Center  
Report  
Drinking Water Program  
Sandusky County  
PWS ID: OH7243212

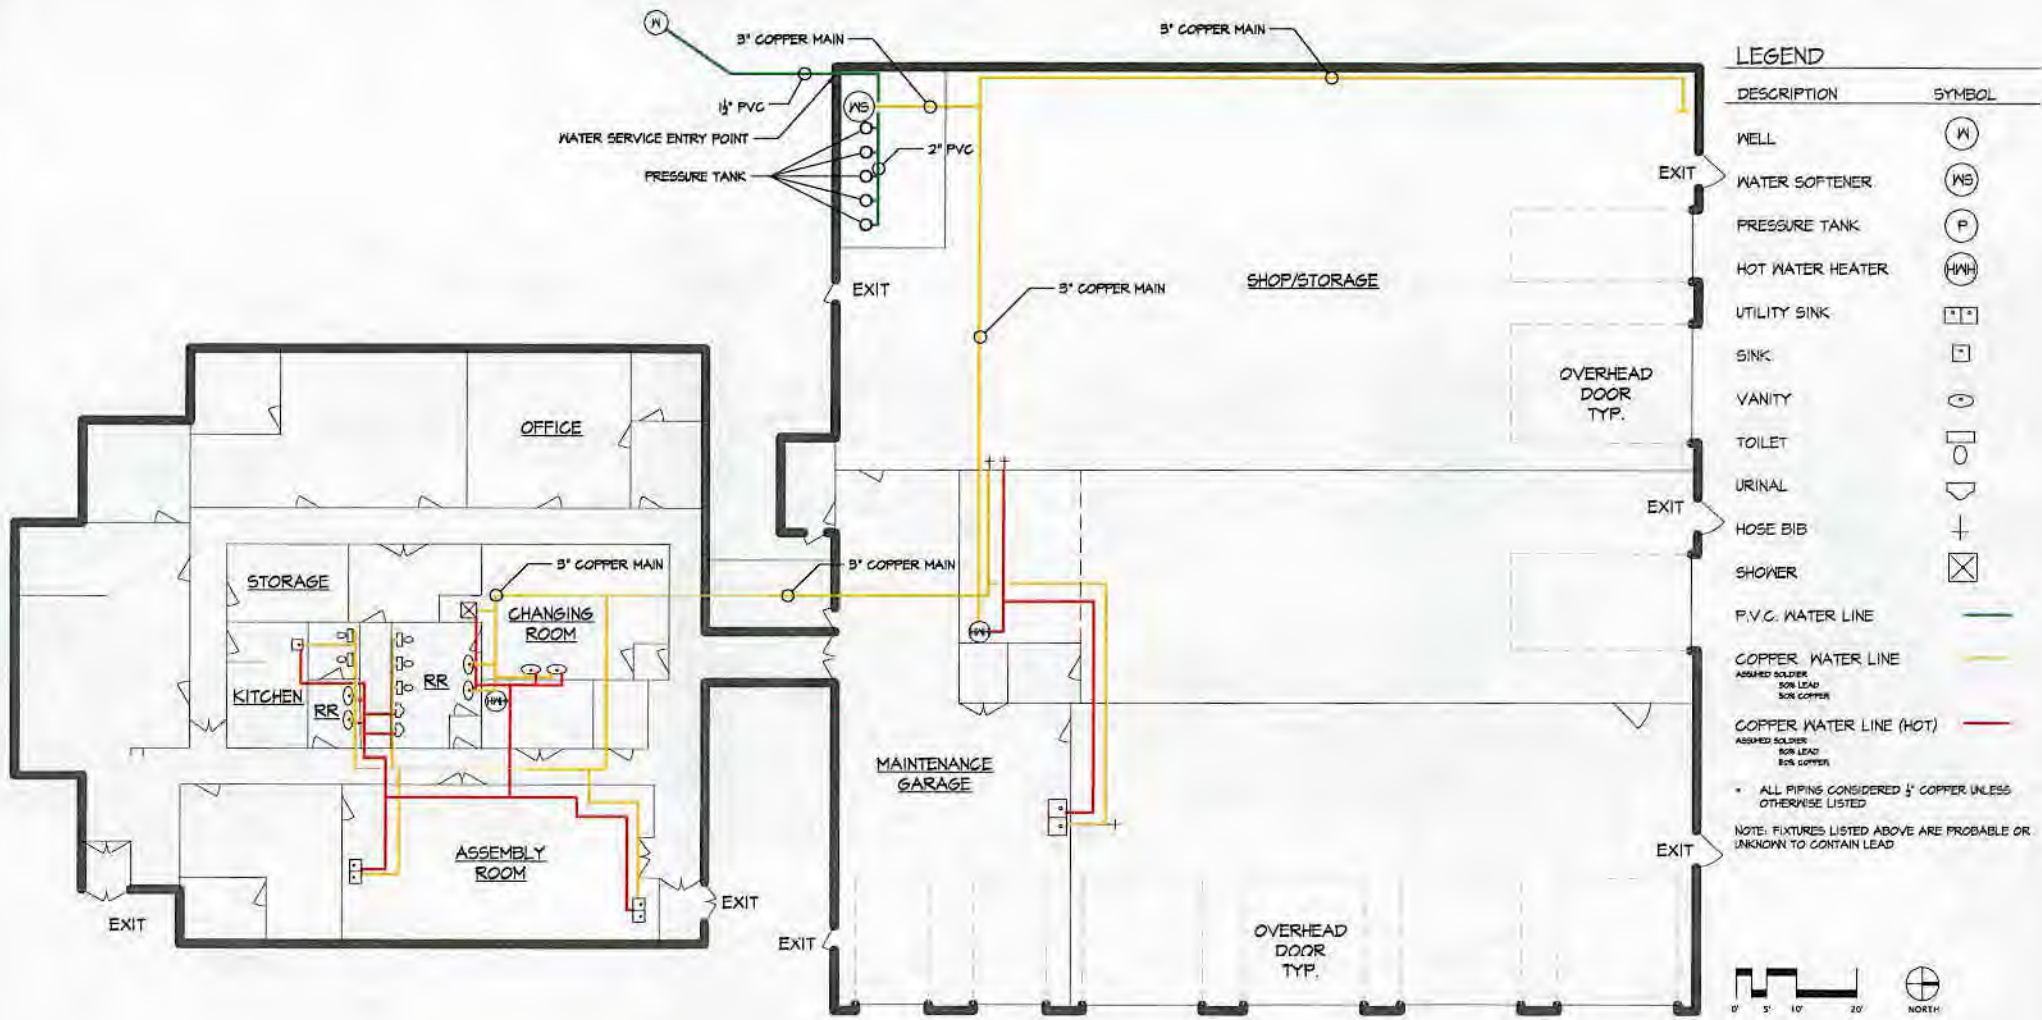

February 17, 2017

**TOLEDO EDISON**  
 Lindsey Service Center - 26 State Route 20, Lindsey, OH 43442  
 E.P.A. Lead Pipe Infrastructure Mapping

**RECEIVED**  
**FEB 27 2017**  
 OHIO E.P.A.  
 N.W.D.O.