


RE: Wapakoneta City  
Report  
Drinking Water Program  
Auglaize County  
PWS ID: OH0600712

Revised

RECEIVED

FEB 28 2017

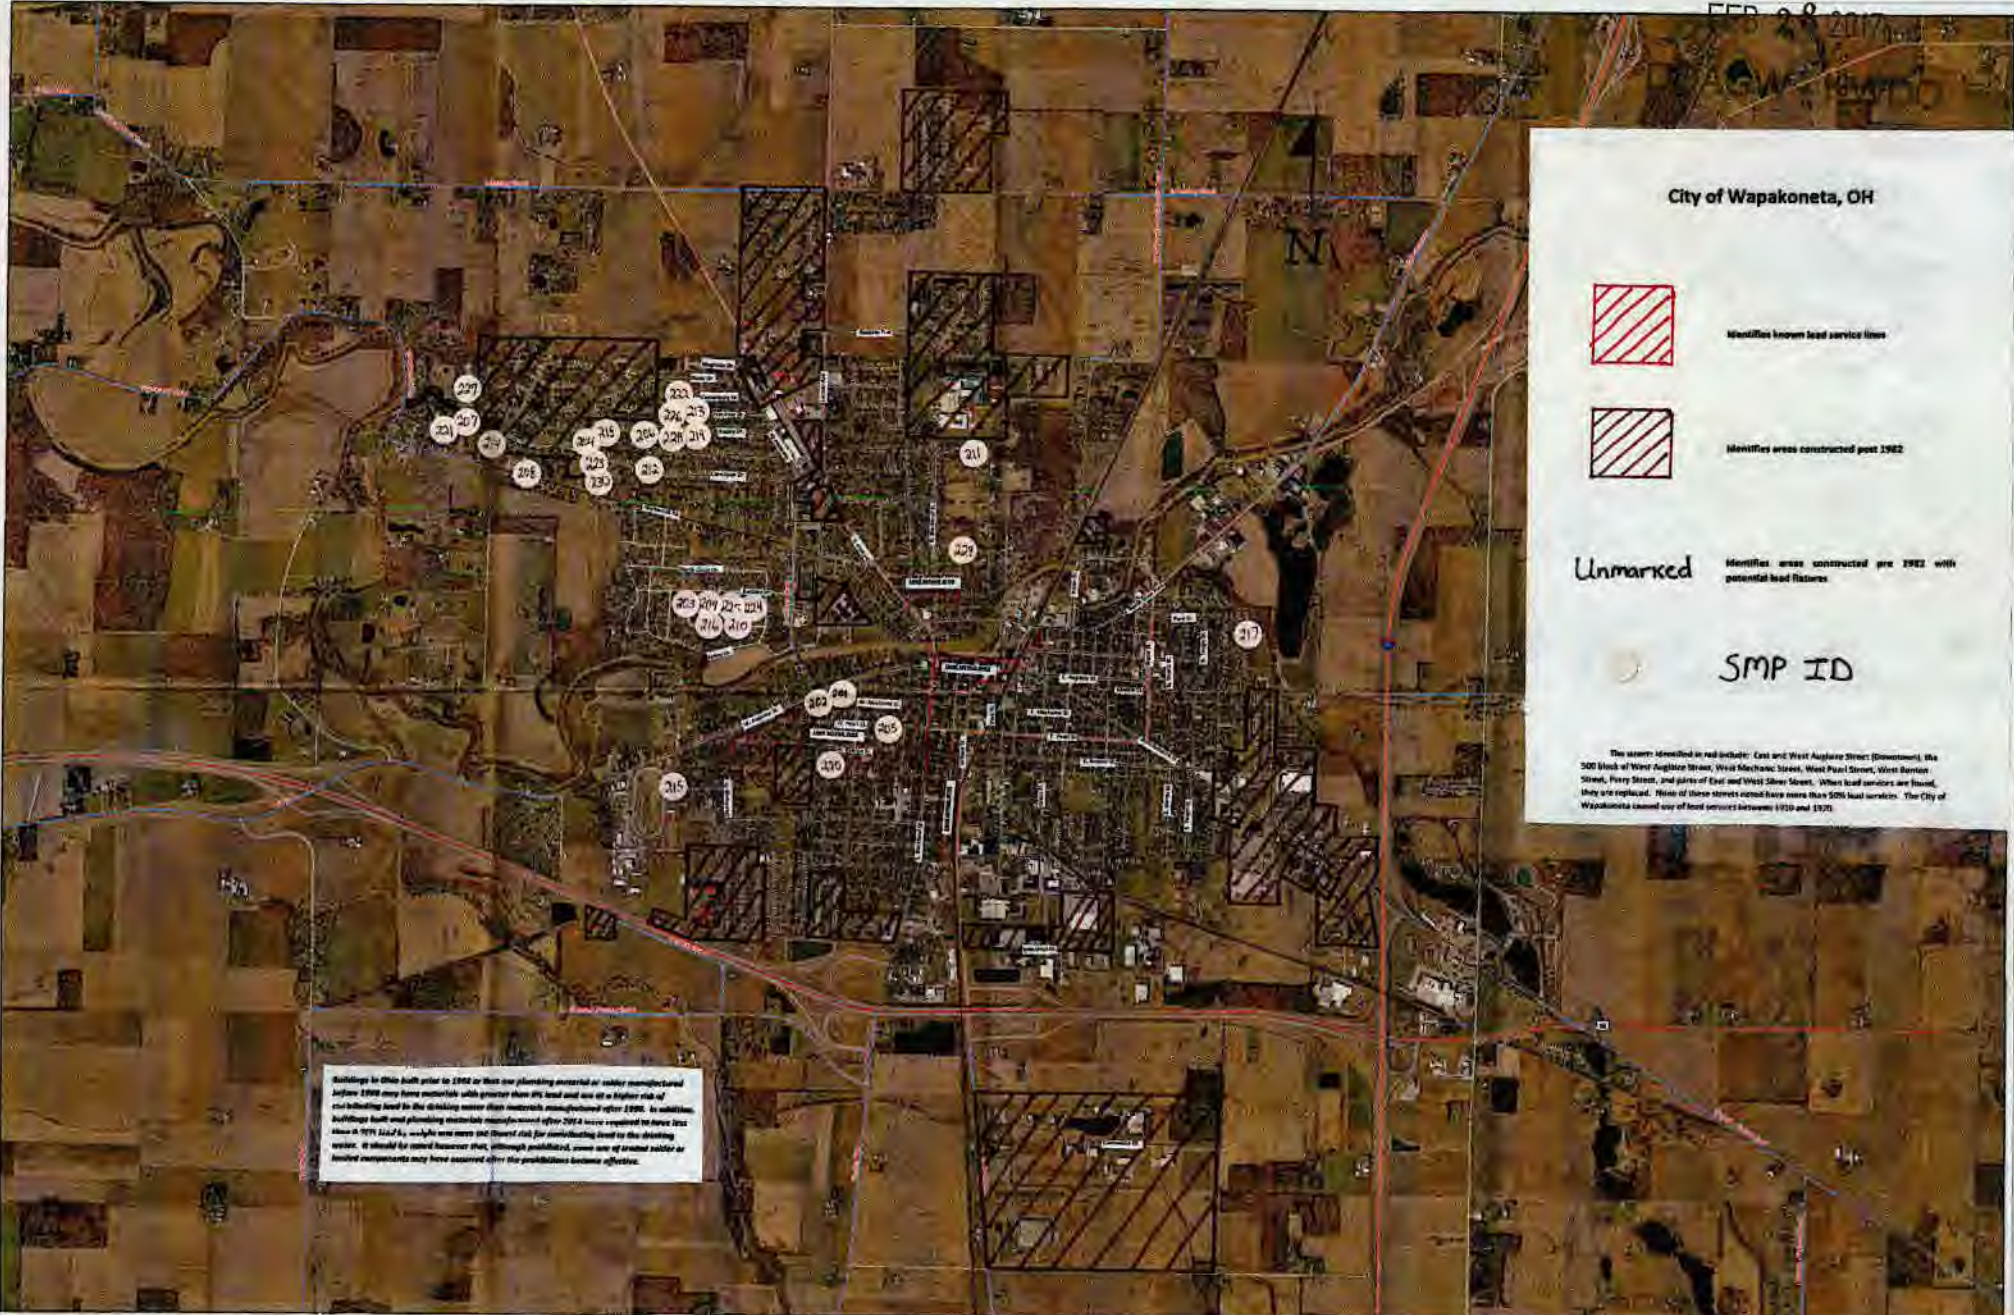

City of Wapakoneta, OH



Identifies known lead service lines



Identifies areas constructed post 1982

Unmarked

Identifies areas constructed pre 1982 with potential lead fixtures



SMP ID

The streets identified in red include: East and West Ashtabula Street (Downtown), the 300 block of West Ashtabula Street, West Mechanics Street, West Pearl Street, West Barclay Street, Perry Street, and pairs of East and West Silver Street. Where lead service lines are found, they are replaced. None of these streets exceed more than 50% lead service. The City of Wapakoneta ceased use of lead service between 1970 and 1975.

Buildings in this built prior to 1982 or that use plumbing material or solder manufactured before 1982 may have materials with greater than 9% lead and are at a higher risk of containing lead in the drinking water than materials manufactured after 1982. In addition, buildings built and plumbing materials manufactured after 1982 were required to have less than 0.1% lead in solder and should not be used for drinking water. It should be noted however that, although prohibited, some use of lead solder or leaded components may have occurred after the prohibitions became effective.