

Entity: Hershey Monessori  
 Doc Type: As-Built  
 Doc Subtype: DRG  
 Program: AS-BUILT  
 County: Cuyahoga  
 Secondary ID: OH2875312



Rec'd 1/17

**Hershey Monessori Farm School, OH2875312**  
 11530 Madison Rd, Huntsburg, OH 44046 - (440) 636-6290

Community Center, Lower Level  
 Built in 2008. May, therefore, have fixtures, plumbing material or solder with  $\leq 8\%$  lead by weight



Plastic service line

Hershey Monessori Farm School, OH2875312  
11530 Madison Rd, Huntsburg, OH 44046 - (440) 636-6290

Community Center, Upper Level  
Built in 2008. May, therefore, have fixtures, plumbing  
material or solder with  $\leq 8\%$  lead by weight

Plastic service line

PERFORMANCE  
CENTER

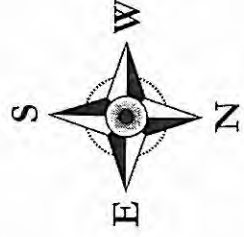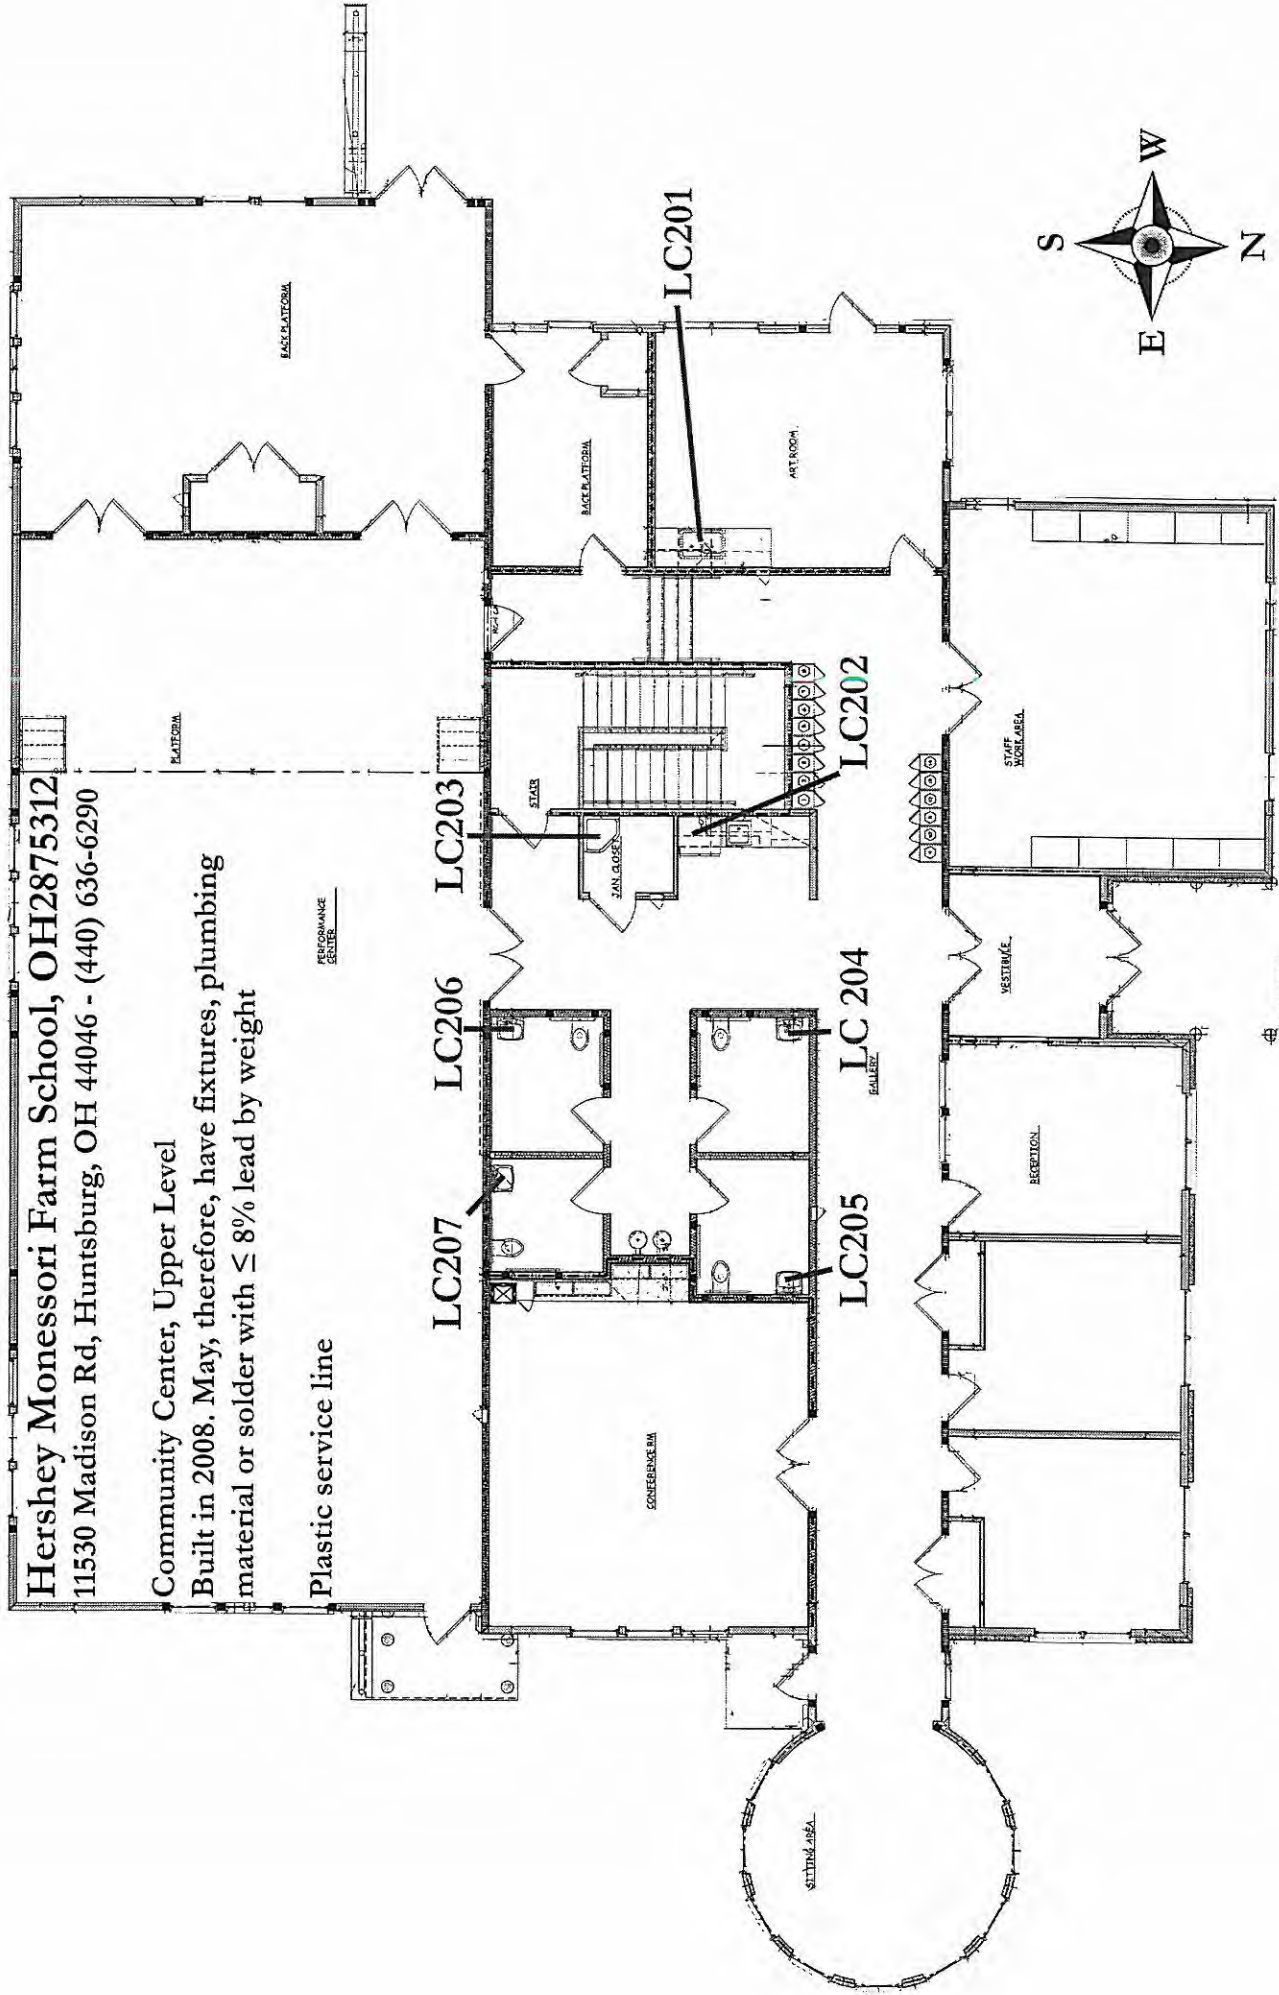

RESTROOMS

☎

☎