


1995  
1999

1993  
1990

Building  
Color Code  
Year Built

FILE ID: 14-354472

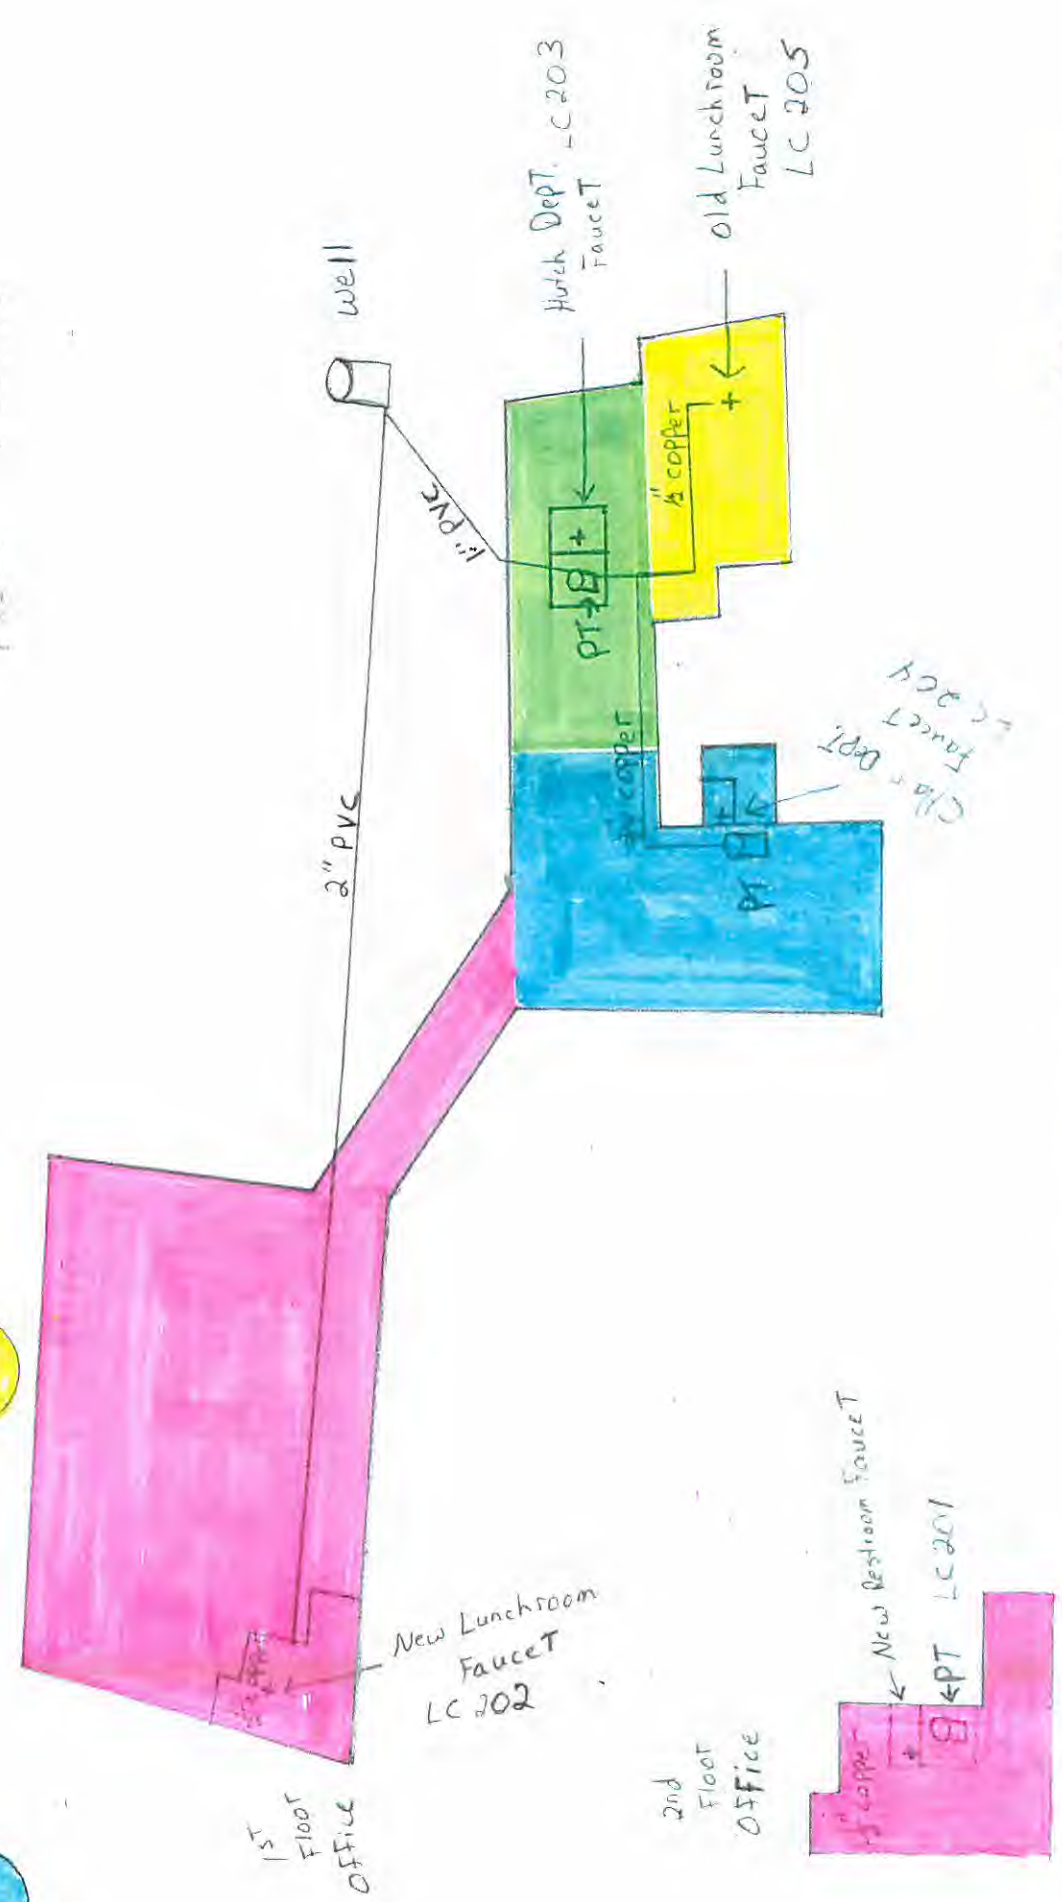

**RECEIVED**  
JAN 13 2017  
**OHIO EPA NEDO**

Entity: Valley View Oak  
 Doc Type: REPORT  
 Doc Subtype: \_\_\_\_\_  
 Program: DDAGW  
 County: HOLMES  
 Secondary ID: 061284912  
 & DOC in color