

Stewart Lodge copper and lead mapping testing.

4302212

Stewart Lodge PWS. ID. 432212, is a health care facility with 54 residents and up to 25 staff at any time on a normal day.

Stewart Lodge is a single building consisting of a century home and two additions. The Eastern addition known as A-wing and the century home were constructed before 1983 so the copper and lead testing is done from these two sections. The western addition known as E-wing was constructed after 1983. There are no lead supply lines at Stewart Lodge. The century home and a-wing are plumbed with copper pipe and soldered joints. Due to the age of this plumbing it is assumed that there is lead in the soldered joints.

The A-wing addition was constructed in 1968/1969. The century home plumbing was also replaced in 1968/1969.

The location of S.M.P. are as follows:

- LC 201 A-wing nursing station
- LC 202 A-wing upstairs large bathroom sink
- LC 203 A-wing upstairs shower room sink 1
- LC 204 A-wing upstairs shower room sink 2
- LC 205 A-wing upstairs shower room sink 3


Any questions or concerns may be addressed to:

Ken Kahr or John Dalsky
at 440-428-7121
or mail concerns to
Stewart Lodge
P.O. box 520
Madison ohio 44057

RECEIVED
FEB 06 2017
OHIO EPA NEIM

Entity: Stewart Lodge
Doc Type: REPORT
Doc Subtype: _____
Program: DDAW
County: LAKE
Secondary ID: 4302212
eDOC in color

Stewart Lodge copper and lead mapping

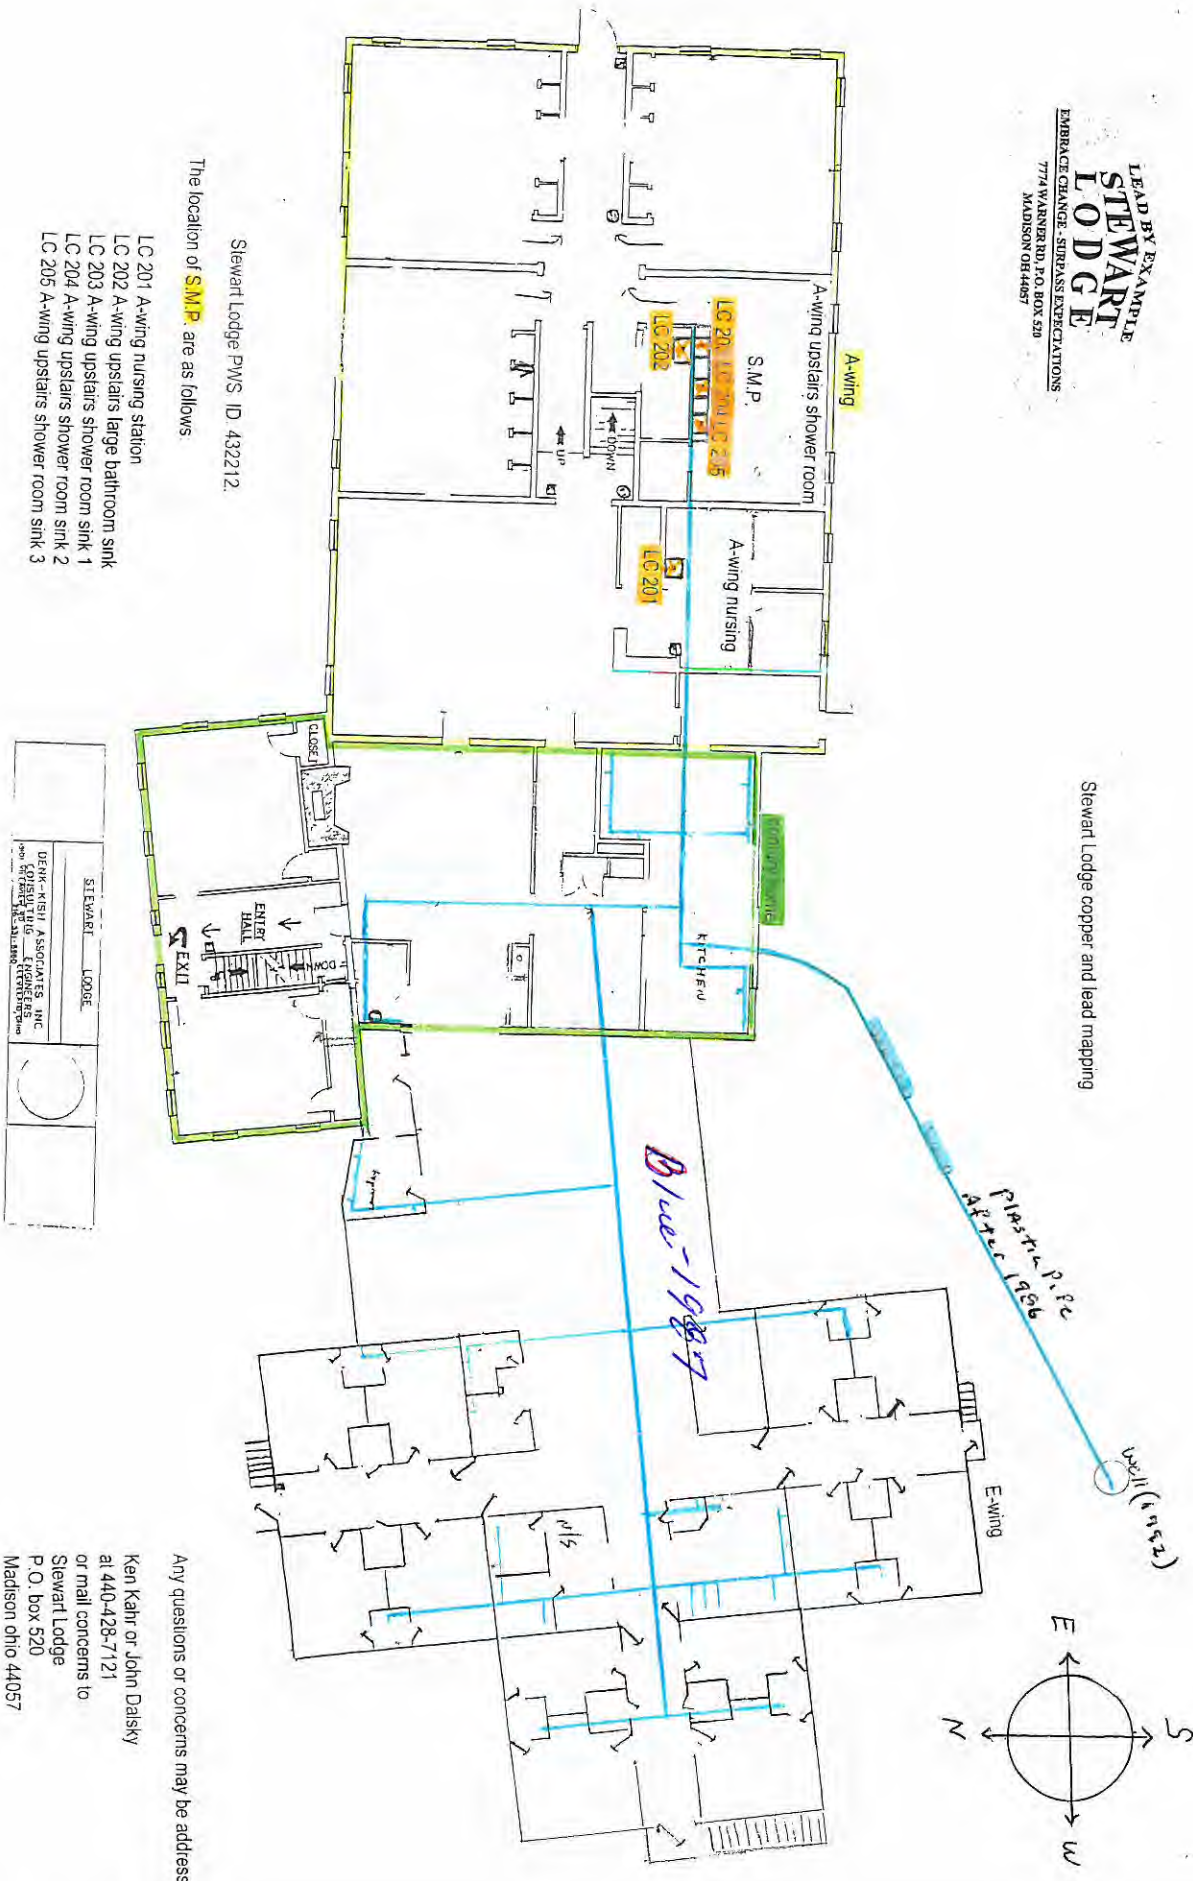

Stewart Lodge PWS ID 432212.
The location of **S.M.P.** are as follows

- LC 201 A-wing nursing station
- LC 202 A-wing upstairs large bathroom sink
- LC 203 A-wing upstairs shower room sink 1
- LC 204 A-wing upstairs shower room sink 2
- LC 205 A-wing upstairs shower room sink 3

STEWART LODGE	
DENK-KIRSH ASSOCIATES, INC.	
3800 WOODBURN AVENUE, SUITE 100	
MADISON, OHIO 44057	

Ken Kahr or John Daisky
at 440-428-7121
or mail concerns to
Stewart Lodge
P O box 520
Madison Ohio 44057

Any questions or concerns may be addressed to