


1-10-17

Service line & fixture mapping

was built 1983
and may have >8% lead solder

f = faucets
fixture lines are copper

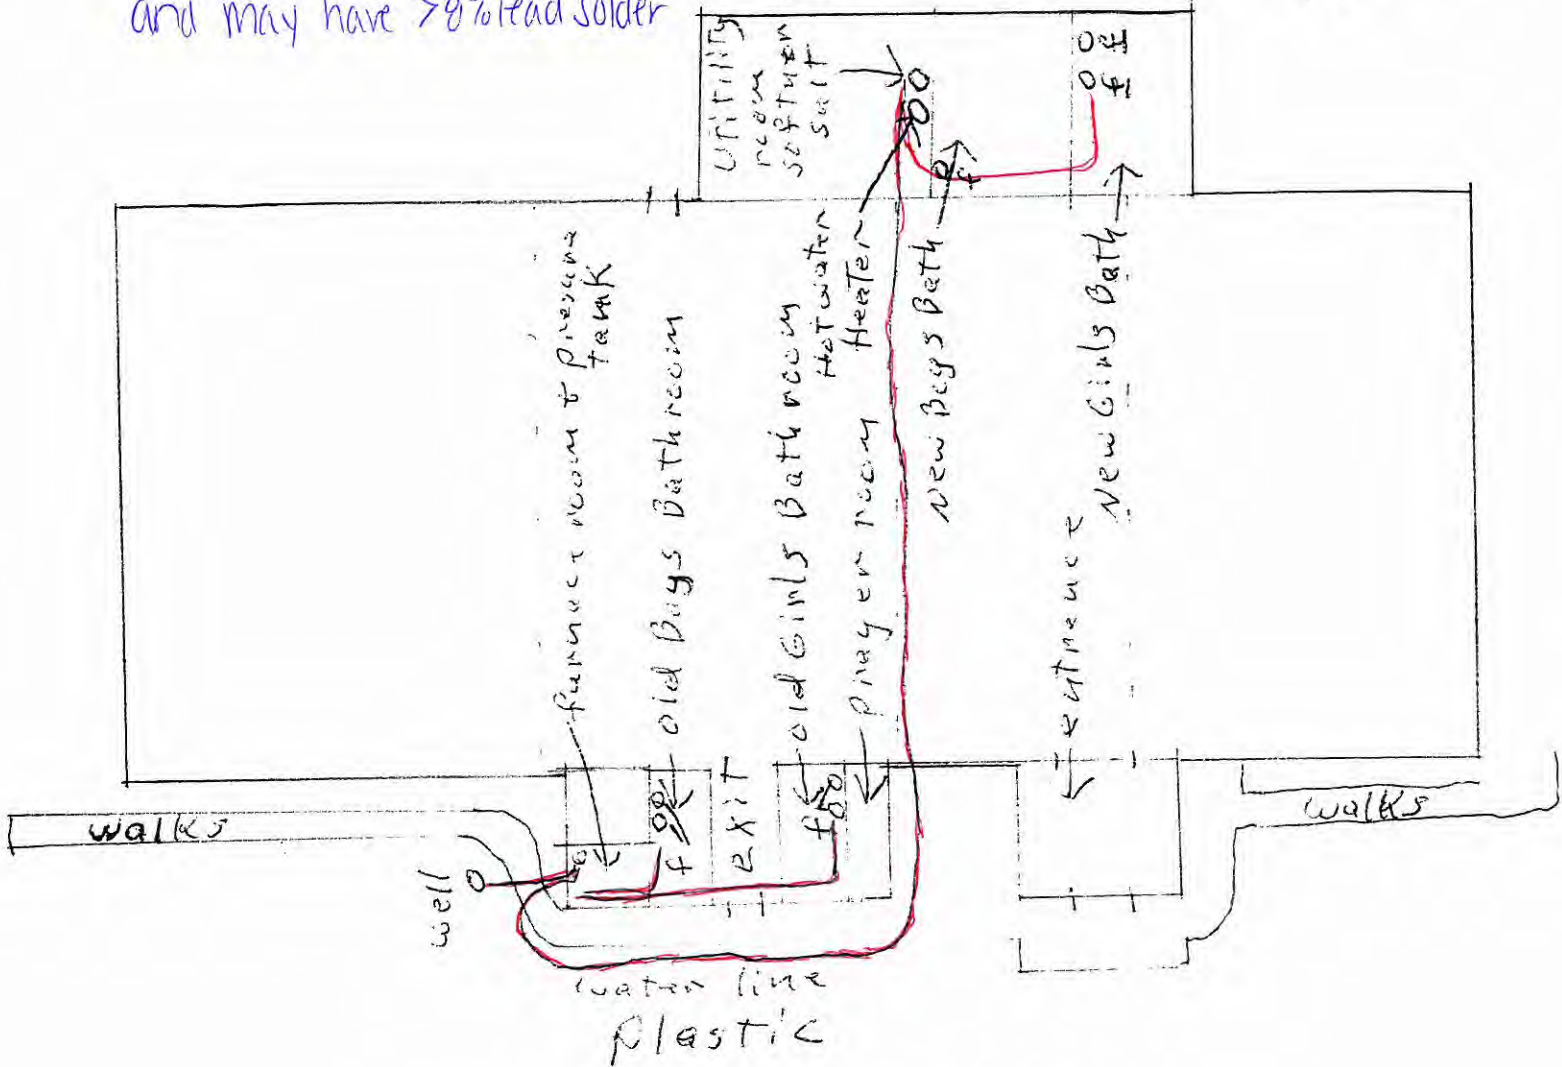

Peniel Fellowship church

PWS ID # 3842112

STU ID # 3855789

Wyman Yoder Cert-number CA-1115664-11

8984 TR552

Shreve, OH 44676

cell phone 330-464-6600

home phone 330-567-2636

email - wyoder@emypeople.net

RECEIVED
JAN 12 2017
OHIO EPA NEDO

eDoc
in color

Entity: Peniel Fellowship Church
 Doc Type: Report
 Doc Subtype: _____
 Program: DDAGW
 County: HOLMES
 ID: OH 3855789