

Heritage Private School  
PWS ID: OH8558912  
9060 Yoder Road  
Sterling, OH 44276  
330-669-2900

Original building built after drawings date of 1-16-1997.

44x50 building addition built after drawing date of 5-16-2001.

All service lines were installed after the 1986 Lead Service Line ban.

Outside spigots have dedicated water lines.


Water lines drawn on map are not necessarily the actual route taken to each fixture.

Copper lines are only used in utility room connecting water softener / pressure tanks and water heater.

All lines leaving utility room are Pex.

In reference to numbers drawn on map:

- 2 = Boys bathroom left faucet = DS002 = LC201
- 7 = Boys bathroom right faucet = DS007
- 3 = Drinking fountain in front hall = DS003 = LC202
- 5 = Girls bathroom left faucet = DS005 = LC203
- 10 = Girls bathroom right faucet = DS010
- 9 = Lunchroom faucet = DS009 = LC204
- 11 = Lunchroom drinking fountain = DS011
- 8 = Kitchen faucet = DS008 = LC205
- 6 = Staff bathroom = DS006
- 4 = Utility room = DS004

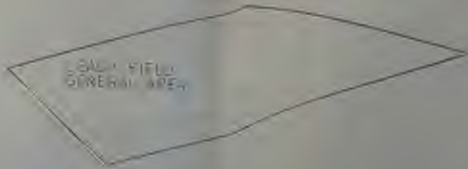


— = Black plastic water-line frame used to stabilize stone

50 boundary 1/10/04



ENTER OF  
WATER DRAIN

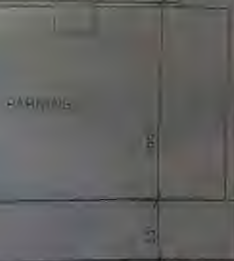

START OF TILES ROAD

50'

HERITAGE PRIVATE SCHOOL

DATE	BY	SCALE
DRAWING NO. 1000-0000-0000-0000		

North ↑

See page 3 For details

New 44 x 50 Addition

- ⊙ = Pressure Tanks (from 3)
- ⊙ = Water heater
- ⊙ = Pressure tank
- ⊙ = to hot
- ⊙ = to cold
- ⊙ = sink
- = Hot water line (PVC plates)
- = Cold water line (PVC plates)
- = Drain plate with main floor ballhead
- = Copper
- DF = Drinking Fountain

\* Below is new addition built after 6/2001  
 all other building areas built after 1/1997



Existing Floor Plan

Adapted  
 2200 Sq Ft Addition




Heritage Private School

Drawn by: C3

Drawn by: C3

A-3

See page 1 for sub-division of this part of building

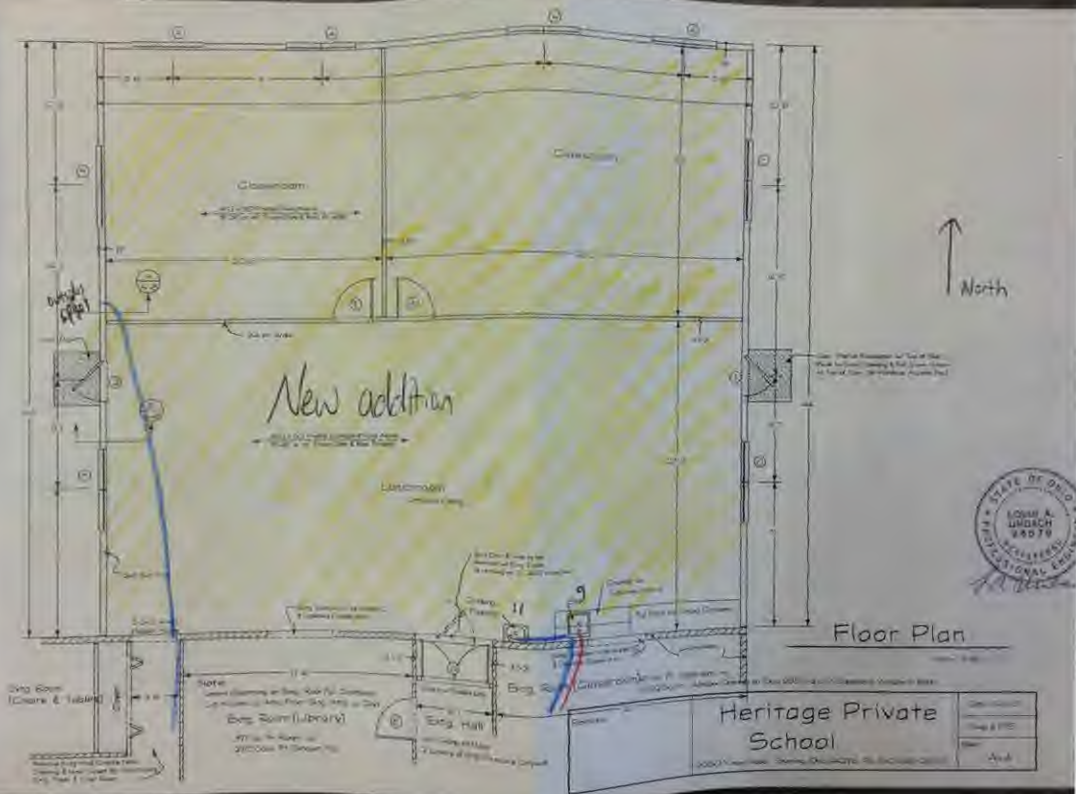

North ↑



Floor Plan

Chg. Room  
(Change & Toilet)

Note:  
Current Classroom on Site, 1000 sq. ft. Classroom  
Library on Site, 1000 sq. ft. Library on Site  
Exis. Gym (Library)

Exis. Gym Hall  
Exis. Gym Hall  
2000mm clearances  
2000mm clearances

Client:	Heritage Private School
Address:	2000mm clearances, 2000mm clearances, 2000mm clearances
Date:	2000mm clearances, 2000mm clearances, 2000mm clearances
Scale:	As Shown