

DOOR

EXIT


FIXTURE

RESTROOM

STATE ROUTE 557

- 1 = LC201
- 2 = LC202
- 3 = LC203
- 4 = LC204
- 5 = LC205
- 6 = LC206
- 7 = LC207
- 8 = LC208
- 9 = LC209
- 10 = LC210
- 11 = LC211
- 12 = LC212

*Basement*

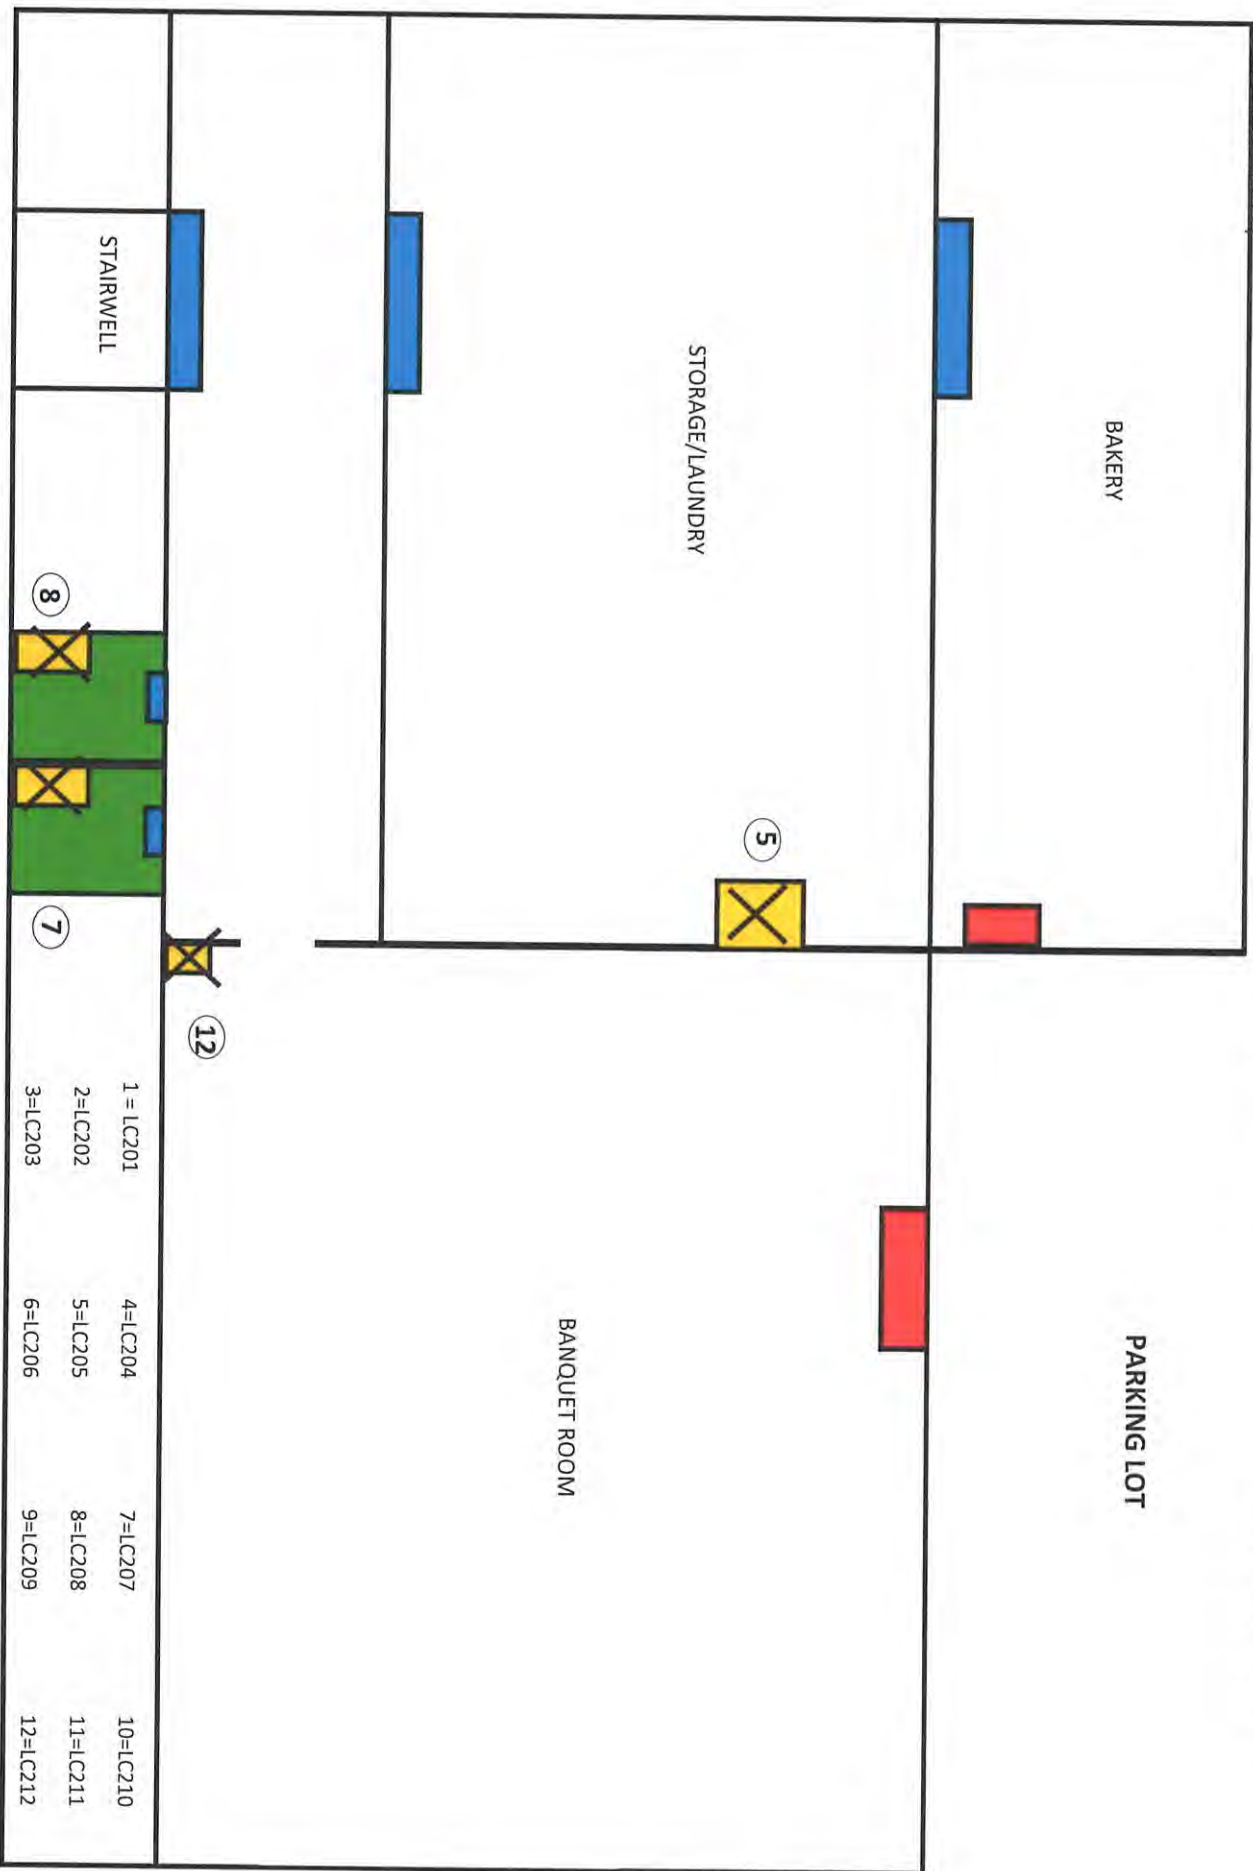

DOOR

EXIT

SINK

RESTROOM

- 1 = LC201
- 2 = LC202
- 3 = LC203
- 4 = LC204
- 5 = LC205
- 6 = LC206
- 7 = LC207
- 8 = LC208
- 9 = LC209
- 10 = LC210
- 11 = LC211
- 12 = LC212