

# Western Reserve Local School District

BOARD OF EDUCATION  
MAHONING COUNTY

Doug McGlynn  
Superintendent  
Cathy Romack  
Treasurer

13850 AKRON-CANFIELD ROAD  
BERLIN CENTER, OHIO 44401-9756

Debbie Farelli  
Principal K-5  
Dallas Saunders  
Principal 6-12

PHONE: (330)547-4100 FAX: (330)547-9302

## Summary of Maps

Western Reserve Schools is supplied with potable water by a well located at the facility. The Old High School is the source for treated water for the district. The treated water leaves location 1 on map #1 and supplies both facilities. A visual inspection shows overhead copper supply lines for the Old HS. The New K-12 Complex is supplied by an underground cast-iron pipe. This supply line was installed during construction of the new K-12 Facility in 2011.

### Map #1 overview

Tap locations are numbered. LC221 and LC222 are the SMP ID collection points for sampling. We are aware of brass fixtures and/or lead-based solder in the old HS. Visual inspection has shown copper pipes used for water distribution. This building is reported as a Tier 2 facility based on the age of the structure.

### Map #2 overview

Constructed in 2011, there are numerous tap locations. I have identified SMP IDs on all locations spread throughout the district. The facility is reported a Tier 1, there are many fixtures containing copper, stainless steel, brass, and zinc alloys. These same metals can be found in mixing valves, check valves, and solder joints throughout the facility. Visual inspection has shown copper pipes used for water distribution. This facility is reported as Tier 1 was constructed after the lead-free standards of 2008.

Please review the maps and let us know if more information is required.

Thank You,

Dean Pagnotta  
Water Operator  
PWS OH5040012

Thank You,


Douglas McGlynn  
Superintendent  
Western Reserve Local Schools

Resources: v. 4/16) "Non-Transient Non-Community Water System sampling sites Tier 1 - Buildings (BLDGs) that contain copper pipes with lead solder\* installed after 1982 (CuPb>82) or contain lead pipes (Pb); buildings with lead service lines. Tier 2 - Buildings (BLDGs) that contain copper pipes with lead solder installed before 1983 (CuPB<83). \*lead solder banned in July 1987

Source: <http://www.wateronline.com/doc/are-you-ready-for-lead-free-0001>


Are you ready for "Lead Free" 2014

Source: Ohio EPA, Division of Drinking and Ground Waters, "Guidelines for Lead Mapping in Distribution Systems."

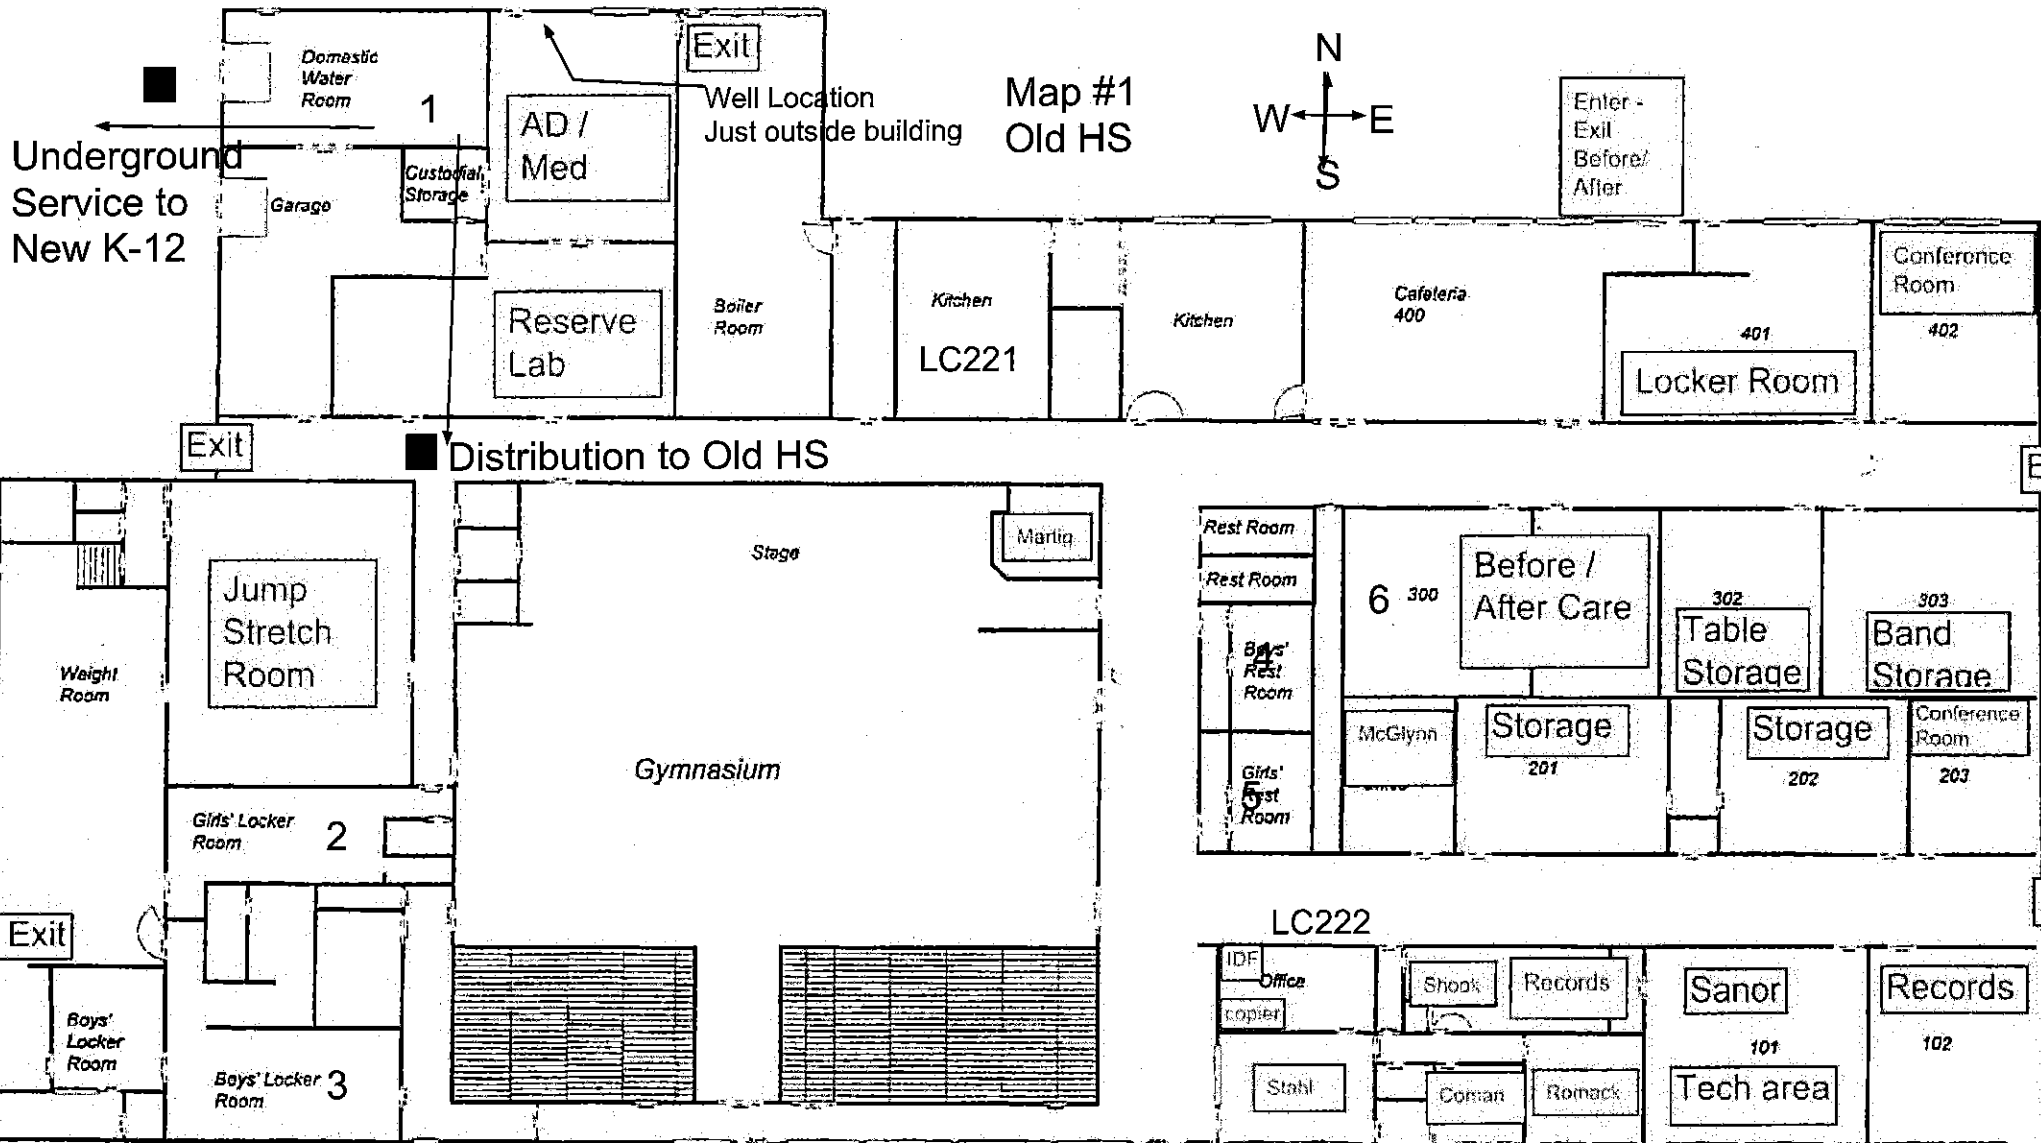

Map #2  
New K-12

Cast-iron service line entering from Map #1 Old HS

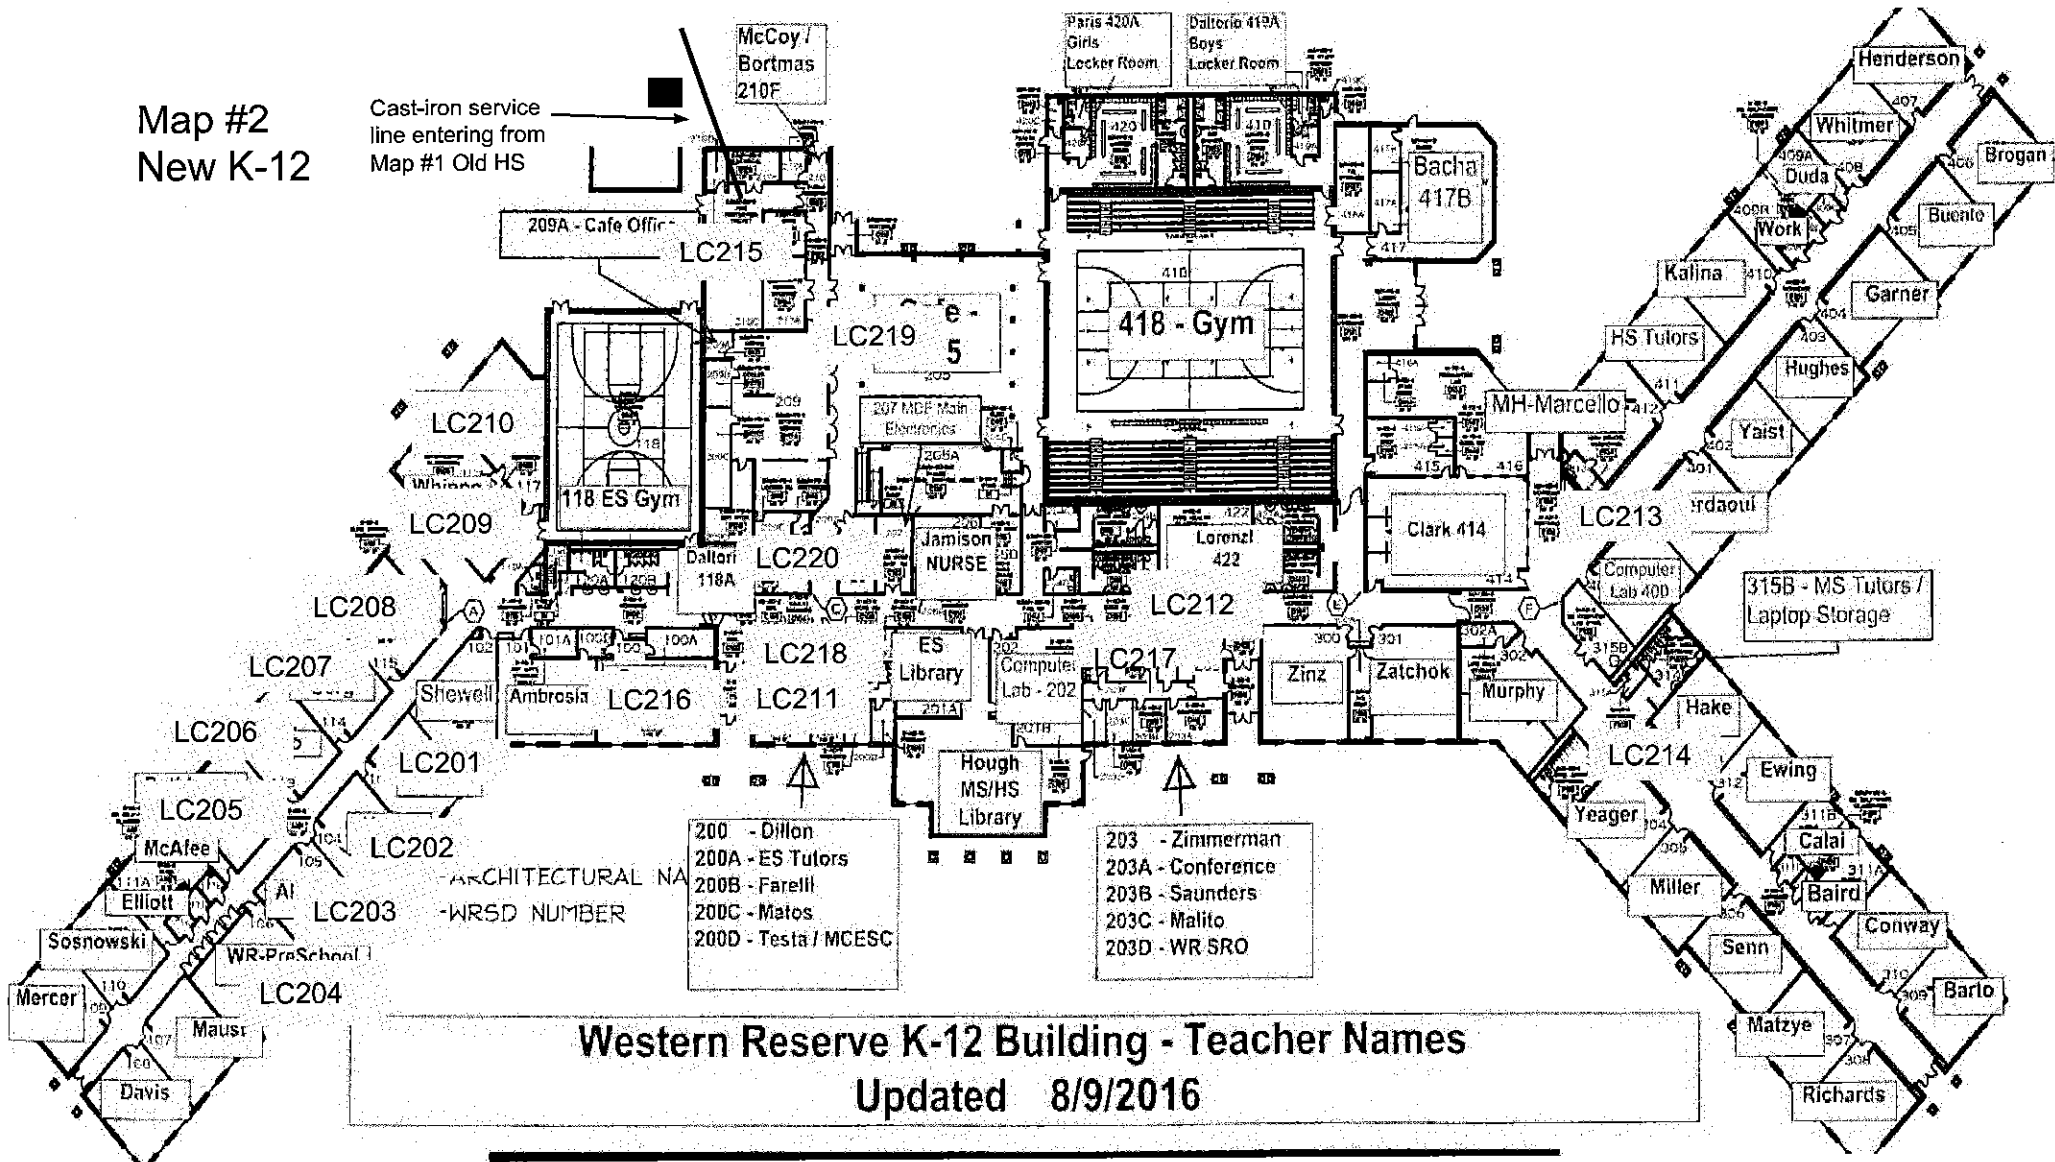

200 - Dillon  
200A - ES Tutors  
200B - Farell  
200C - Matos  
200D - Testa / MCESC

203 - Zimmerman  
203A - Conference  
203B - Saunders  
203C - Malito  
203D - WR SRO

**Western Reserve K-12 Building - Teacher Names**  
Updated 8/9/2016