

RE: Mifflin Elementary School
Report
Drinking Water Program
Richland County
PWS ID: OH7033412

**VERIFICATION FORM FOR COMMUNITY PUBLIC WATER SYSTEMS
CLAIMING NO LEAD SERVICE LINES**

The owner or operator of all community public water systems must identify and map areas of their distribution system that are known or are likely to contain lead service lines. Systems must submit a copy of the applicable map to the Ohio Department of Health and the Ohio Department of Job and Family Services. Systems must also submit a report to the director containing at least both of the following: (1) The applicable map with narrative, and (2) A list of sampling locations used to collect samples as required by Ohio Revised Code (ORC) Section 6109.121 and any rules adopted thereunder, including contact information for the owner and occupant of each sampling site.

Should a water system determine no lead service lines exist in their distribution system, they must provide information stating they reviewed, at the minimum, historical permit records and local ordinances, distribution maintenance records and information pertaining to installation dates or materials for all services lines. This information must be verified below.

I HEREBY CERTIFY THAT THE FOLLOWING METHOD(S) WERE USED TO DETERMINE NO LEAD SERVICE LINES EXIST IN THIS WATER SYSTEM'S DISTRIBUTION SYSTEM, AS REQUIRED BY ORC 6109.121(F):


LEAD SERVICE LINE VERIFICATION
<p>This PWS states they have no lead service lines and has reviewed the following information (select one or more of the following):</p> <ul style="list-style-type: none"><input type="checkbox"/> Historical permit records and/or local ordinances<input checked="" type="checkbox"/> Distribution maintenance records (i.e. meter replacement, waterline break repairs)<input type="checkbox"/> Information pertaining to installation dates for all service lines (i.e. after 1986 when lead services lines were banned)<input checked="" type="checkbox"/> Service line material of all service lines is known (i.e. all service lines are known to be PVC)

Holly L. McGhee 2-22-17
Signature of Responsible Person Date
Holly L. McGhee MTWSI
Printed Name and Title of Responsible Person

PWS NAME: Mifflin Elementary
PWS ID: OH 7033412
COUNTY: Richland

<p>For Ohio EPA use only:</p> <p>Date Verification Rec'd: _____</p>
--

RECEIVED
MAR 01 2017
DDAGW - NWDO

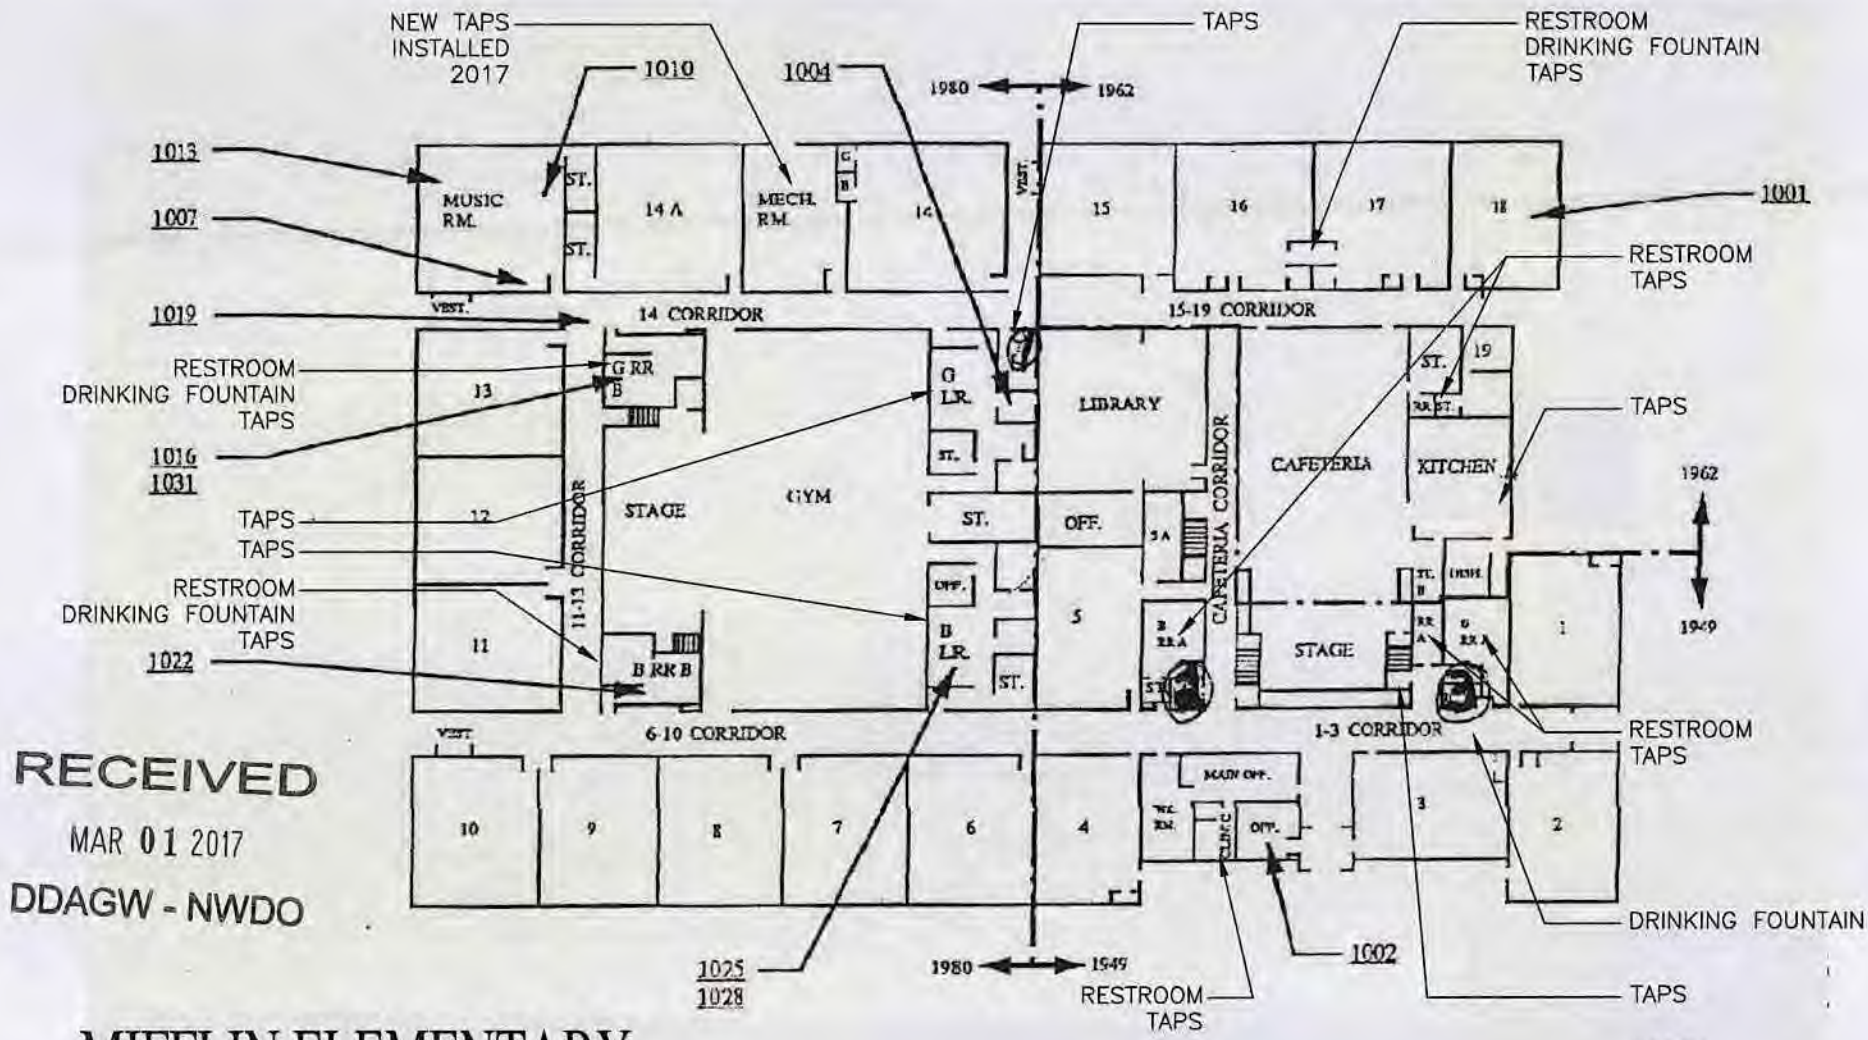

RECEIVED
 MAR 01 2017
 DDAGW - NWDO

MIFFLIN ELEMENTARY

SCALE : NOT TO SCALE

NOTES;

1. BUILDING WAS BUILT IN 1949 & ADDED ONTO IN 1962 & 1980.
2. ALL PIPING IS PVC PLASTIC, GALVANIZED, & COPPER.
3. ALL COPPER PIPING LIKELY CONTAINS LEAD SOLDER.
4. ALL PIPING IN MECHANICAL ROOM IS PVC PLASTIC & COPPER.
5. ALL PIPING IN BUILDING EXCEPT MECHANICAL ROOM IS GALVANIZED AND COPPER.

MIFFLINE ELEMENTARY SCHOOL
 441 REED ROAD
 MANSFIELD, OHIO 44903
 PHONE # (419) 589-6517
 PWS ID # OH7033412

MCGHEE'S TECHNICAL
MIWSI
WATER SERVICES, INC.
 2230 JAMES ROAD, BELLVILLE, OHIO 44813-9279