

RE: Trinity Lutheran School - Jenera
Report
Drinking Water Program
Hancock County
PWS ID: OH3245912

February 27, 2017

RE: PWSID 3245912

RECEIVED

MAR 01 2017

**OHIO E.P.A.
N.W.D.O.**

Ohio EPA
Northwest District Office
North Dunbridge Road
Bowling Green OH 43402

Dear Sirs,

This letter is in response to the new directive on lead in drinking water in schools. Included with this letter is a color coded map of our facility showing the water lines and fixtures and the locations for lead and copper testing.

The school was built in three phases. Original phase in 1952. Second phase in 1966. Third phase in 1984. The service line from the well to the pressure tanks is copper. All supply lines are copper.

All the soldered joints were done before 1998. All fixtures except the hand wash sink in the kitchen were installed before 1998. The hand wash faucet and supply lines were removed in 2016 and new items installed.

Since all soldered joints were done before the lead ban we know there is lead in those soldered joints. And since all but one of the fixtures was installed before 1998 we know they all contain lead.

We have 19 potential taps for water in the school. We tested all but one tap, in the computer room. They all tested below the threshold of concern for lead and copper.

We use the two sinks in each of the boys and girls restroom across from the kitchen and the kitchen sink as our taps for testing lead and copper.

Please let me know of any additional information you might need for this project.

Dan Webb
Operator
Trinity Lutheran School water system PWSID 3245912

Attachment: Map of water service lines
List of LCR sampling locations

CC: Ohio Department of Health
Ohio Department of Jobs and Family Services
Hancock County Health Department

Service line is Copper installed 1952

Supply lines are Copper installed before 1986

All fixtures except kitchen hand wash sink in kitchen installed before 1986
Allen Street

All solder joints before 1986

Trinity Lutheran School Floor Plan

□ - Sinks = 16


D - Drinking Fountain 3

H - Hot Water Heater - 2

Red — Hot water line

Blue — Coldwater line

Green — Service line
from Well

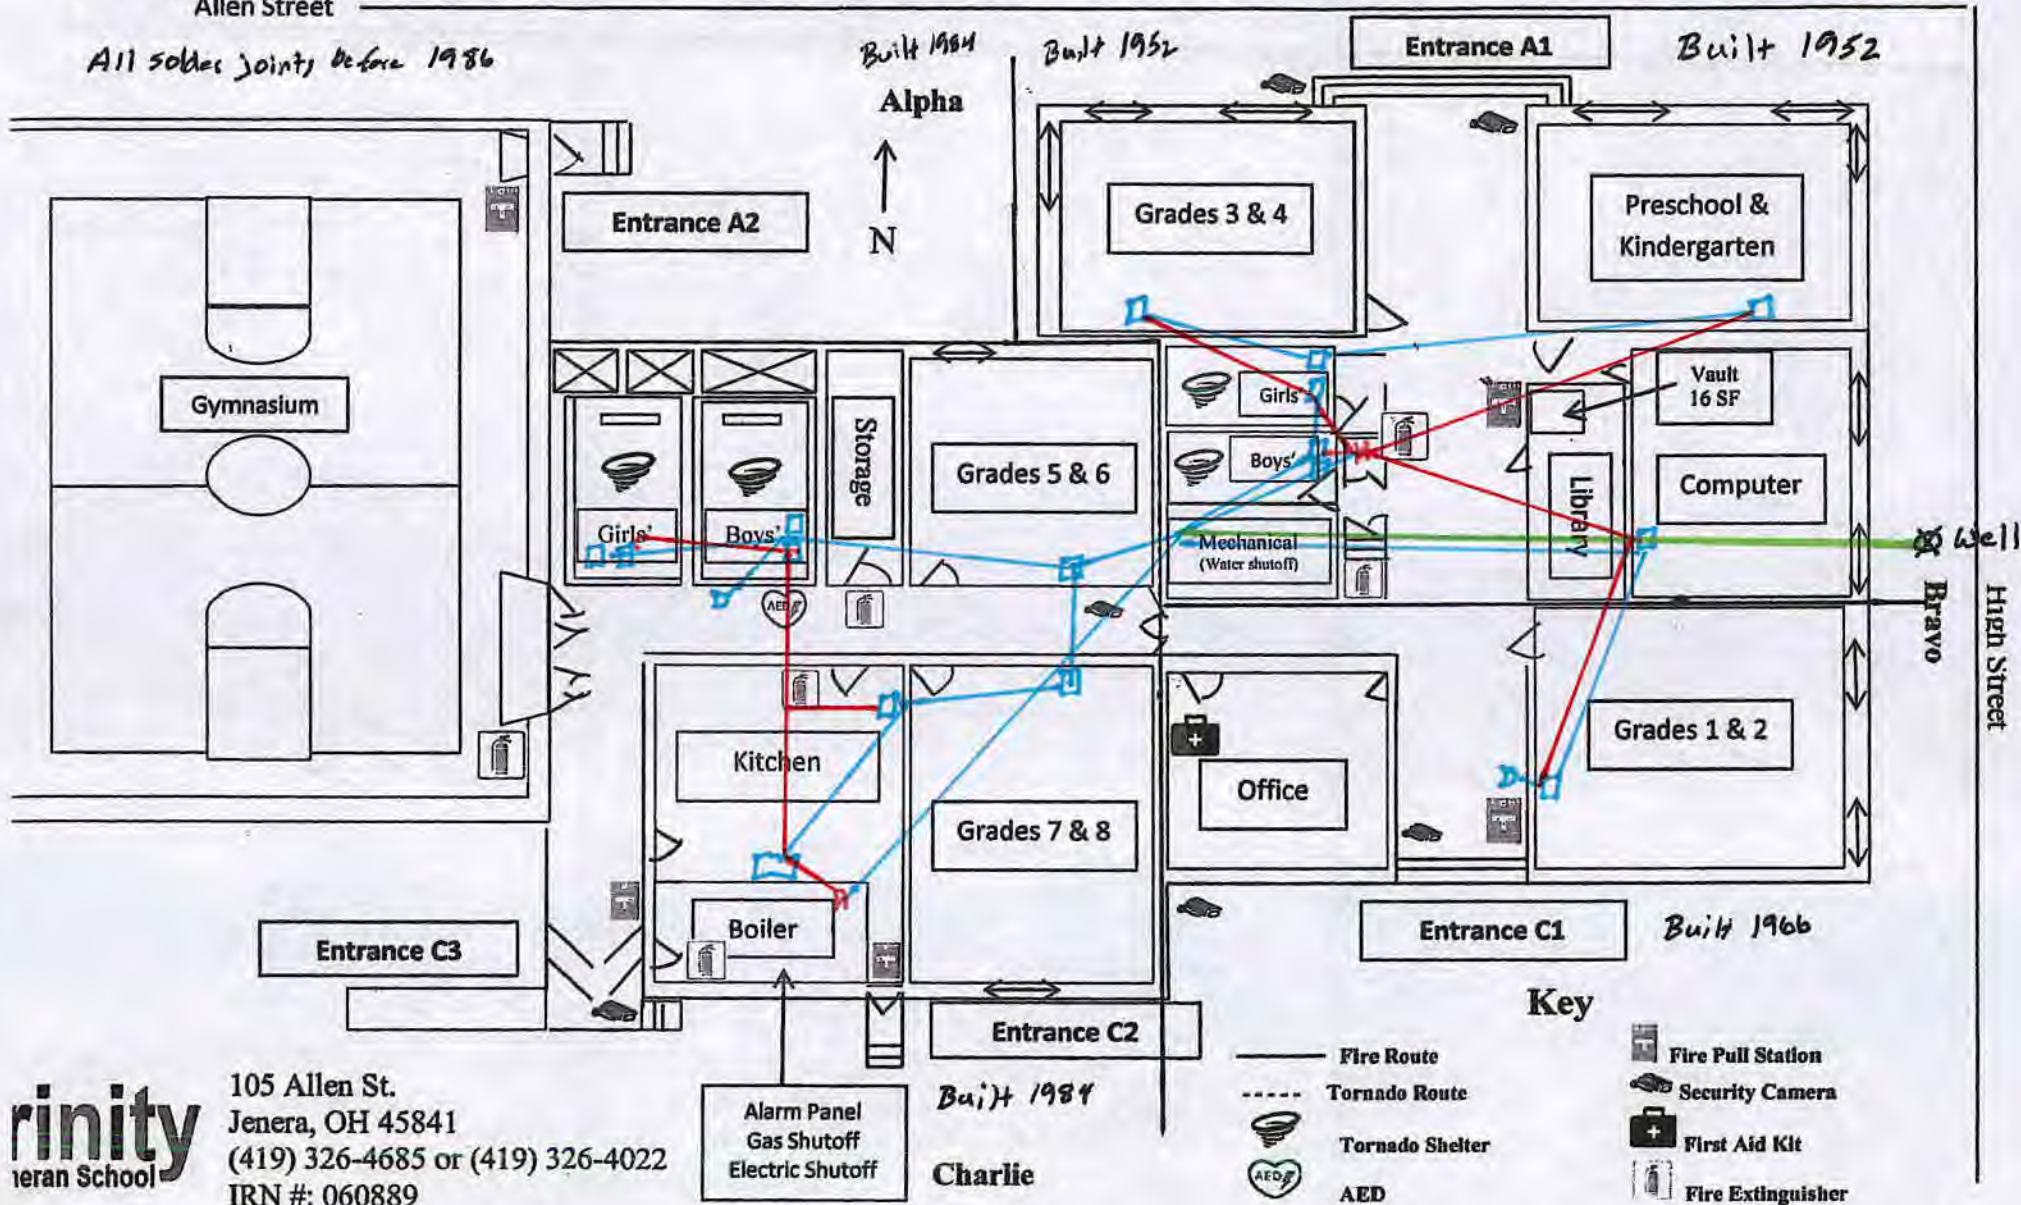

Trinity
Lutheran School

105 Allen St.
Jenera, OH 45841
(419) 326-4685 or (419) 326-4022
IRN #: 060889