


Doors

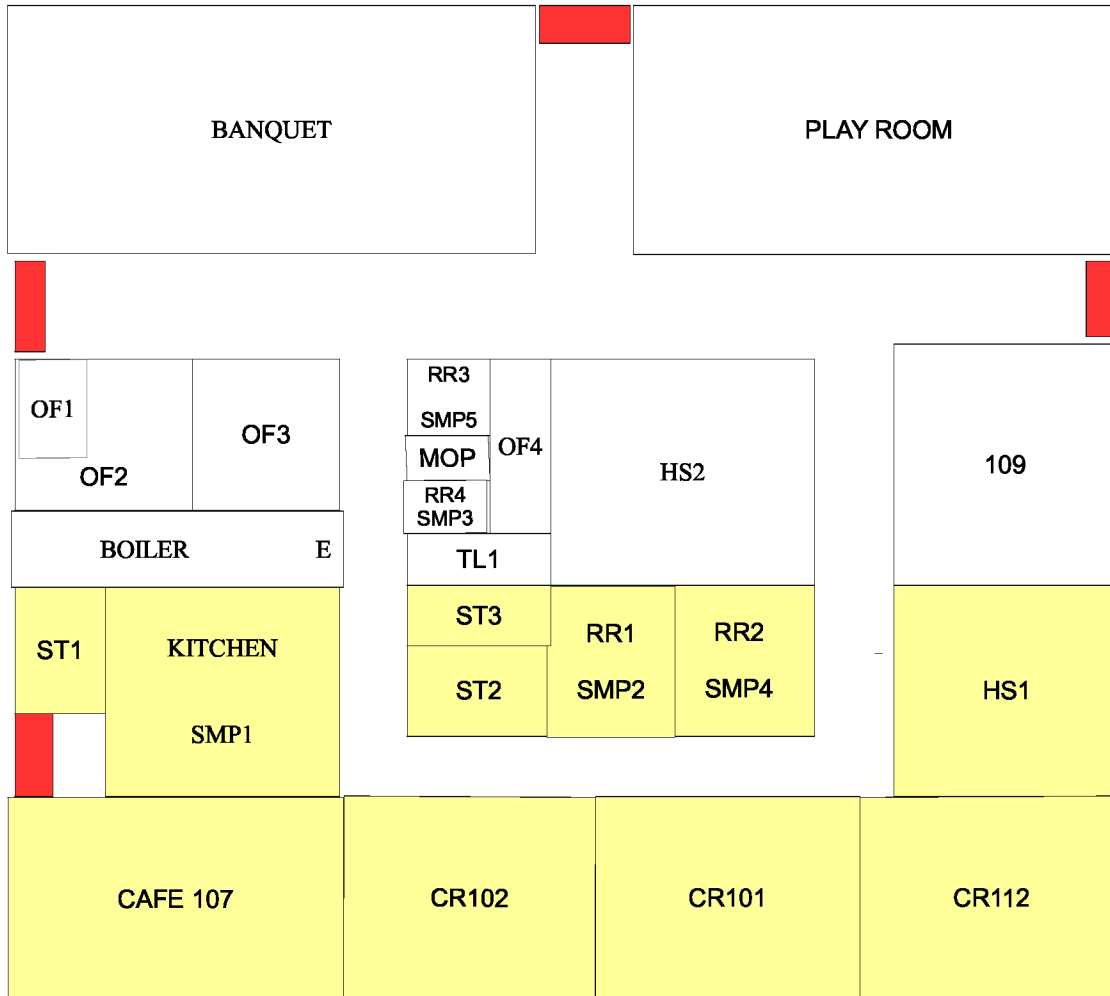

**This section constructed 1974
 Water piping copper and solder
 construction**

E – Water Enters Boiler Room to Storage Tank

**SMP 1 Kitchen
 SMP 2 Boy's Restroom
 SMP 3 Men's Restroom
 SMP 4 Girls Restroom
 SMP 5 Women's Restroom 1**

**This section constructed 1954
 Water piping copper and solder
 construction**