


SUBURBAN MOBILE HOME PARK
5823 JACKSONTOWN ROAD SE
NEWARK, OHIO 43056

OFFICE-55 DEWMAR DRIVE SE
HEATH, OHIO 43056
740-928-3772

PWS ID-OH4502812

FEBRUARY 20, 2017

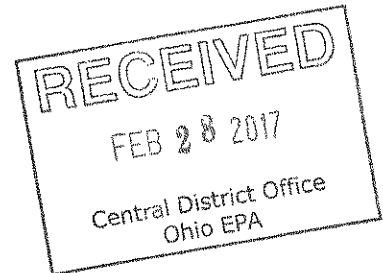

The interior lines of all the mobile homes are either plastic or PVC.

The water distribution system in the park was completely replaced in 1987 (July-October). All mains and laterals are of black plastic polyethylene pipe(thick wall). All connections, (tees, ells, couplings) are nylon.

The pipe connection work was done by S. T. Roberts.

ROBERTS PLUMBING
127 JEFFERSON STREET
NEWARK, OHIO 43055
740-345-9582

R. F. Toland
R. F. TOLAND – OWNER/OPERATOR

2-21-2017
DATE



Stephen T. Roberts
S. T. ROBERTS – CONTRACTOR

2-21-2017
DATE

SUBURBAN MOBILE HOME PARK MOBILE HOMES

PWS ID OH4502812

- BUILT BEFORE 1986
- BUILT 1986-1996
- BUILT 1997-2014
- BUILT AFTER 2014

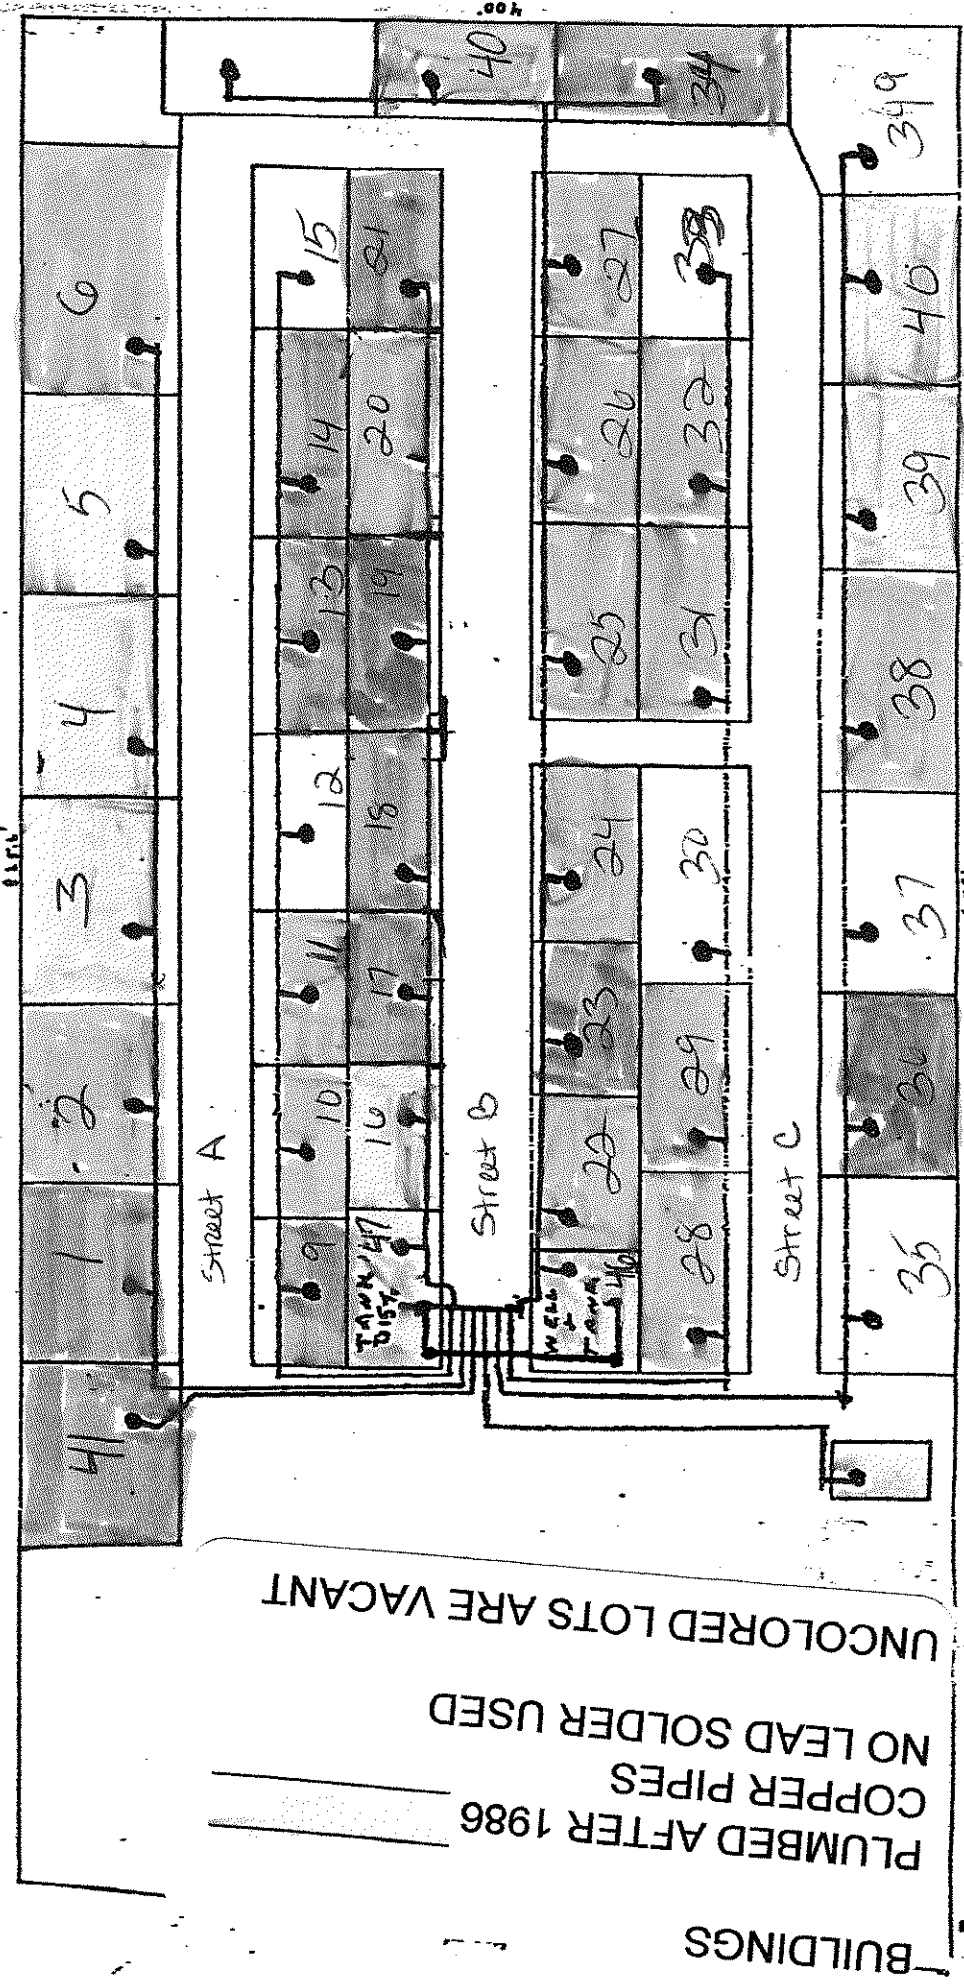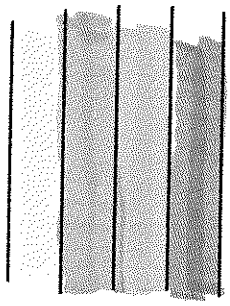

PLUMBED AFTER 1986
 COPPER PIPES
 NO LEAD SOLDER USED
 UNCOLORED LOTS ARE VACANT

* 2/29/17 altered map per J. Roland's Instruction

AD

**VERIFICATION FORM FOR COMMUNITY PUBLIC WATER SYSTEMS
CLAIMING NO LEAD SERVICE LINES**

The owner or operator of all community public water systems must identify and map areas of their distribution system that are known or are likely to contain lead service lines. Systems must submit a copy of the applicable map to the Ohio Department of Health and the Ohio Department of Job and Family Services. Systems must also submit a report to the director containing at least both of the following: (1) The applicable map with narrative, and (2) A list of sampling locations used to collect samples as required by Ohio Revised Code (ORC) Section 6109.121 and any rules adopted thereunder, including contact information for the owner and occupant of each sampling site.

Should a water system determine no lead service lines exist in their distribution system, they must provide information stating they reviewed, at the minimum, historical permit records and local ordinances, distribution maintenance records and information pertaining to installation dates or materials for all services lines. This information must be verified below.

I HEREBY CERTIFY THAT THE FOLLOWING METHOD(S) WERE USED TO DETERMINE NO LEAD SERVICE LINES EXIST IN THIS WATER SYSTEM'S DISTRIBUTION SYSTEM, AS REQUIRED BY ORC 6109.121(F):

LEAD SERVICE LINE VERIFICATION	
This PWS states they have no lead service lines and has reviewed the following information (select one or more of the following):	
<input type="checkbox"/>	Historical permit records and/or local ordinances
<input type="checkbox"/>	Distribution maintenance records (i.e. meter replacement, waterline break repairs)
<input checked="" type="checkbox"/>	Information pertaining to installation dates for all service lines (i.e. after 1986 when lead services lines were banned)
<input checked="" type="checkbox"/>	Service line material of all service lines is known (i.e. all service lines are known to be PVC)

Signature of Responsible Person	Date
<i>R.F. Toland</i>	2-28-2017
Printed Name and Title of Responsible Person	
Robert F. Toland	
Owner/Operator	

PWS NAME: SUBURBAN
MOBILE HOME
PARK _____
PWS ID:
OH_4502812 _____
COUNTY:
LICKING _____

For Ohio EPA use only:
Date Verification Rec'd: <u>2/28/17</u>