

Multi-Wing America Inc.  
 15030 Berkshire Industrial Parkway  
 Burton, Ohio 44021  
 440-834-9208  
 PW's ID OH2863412

The building was built in 1992. It is a steel building that was designed and used as an Office with a factory attached. With a total of 31,954 Sqft. Divided into 3 building on the drawing.


Service line from the well to the pressure tank is PVC

Building # 1 & 2 is plumbed with copper water lines with the potential of lead solder. Fixtures have been replaced in the restrooms approximately 2008. The lunch room 2013

Building # 3 was rebuilt in 2011 due to a fire. It is plumbed with copper water lines and lower limit lead solder. Fixtures in both the lunch room and restrooms were replaced in 2011

There are no drinking fountains in any of the buildings

BERKSHIRE INDUSTRIAL PARKWAY 60' R/W

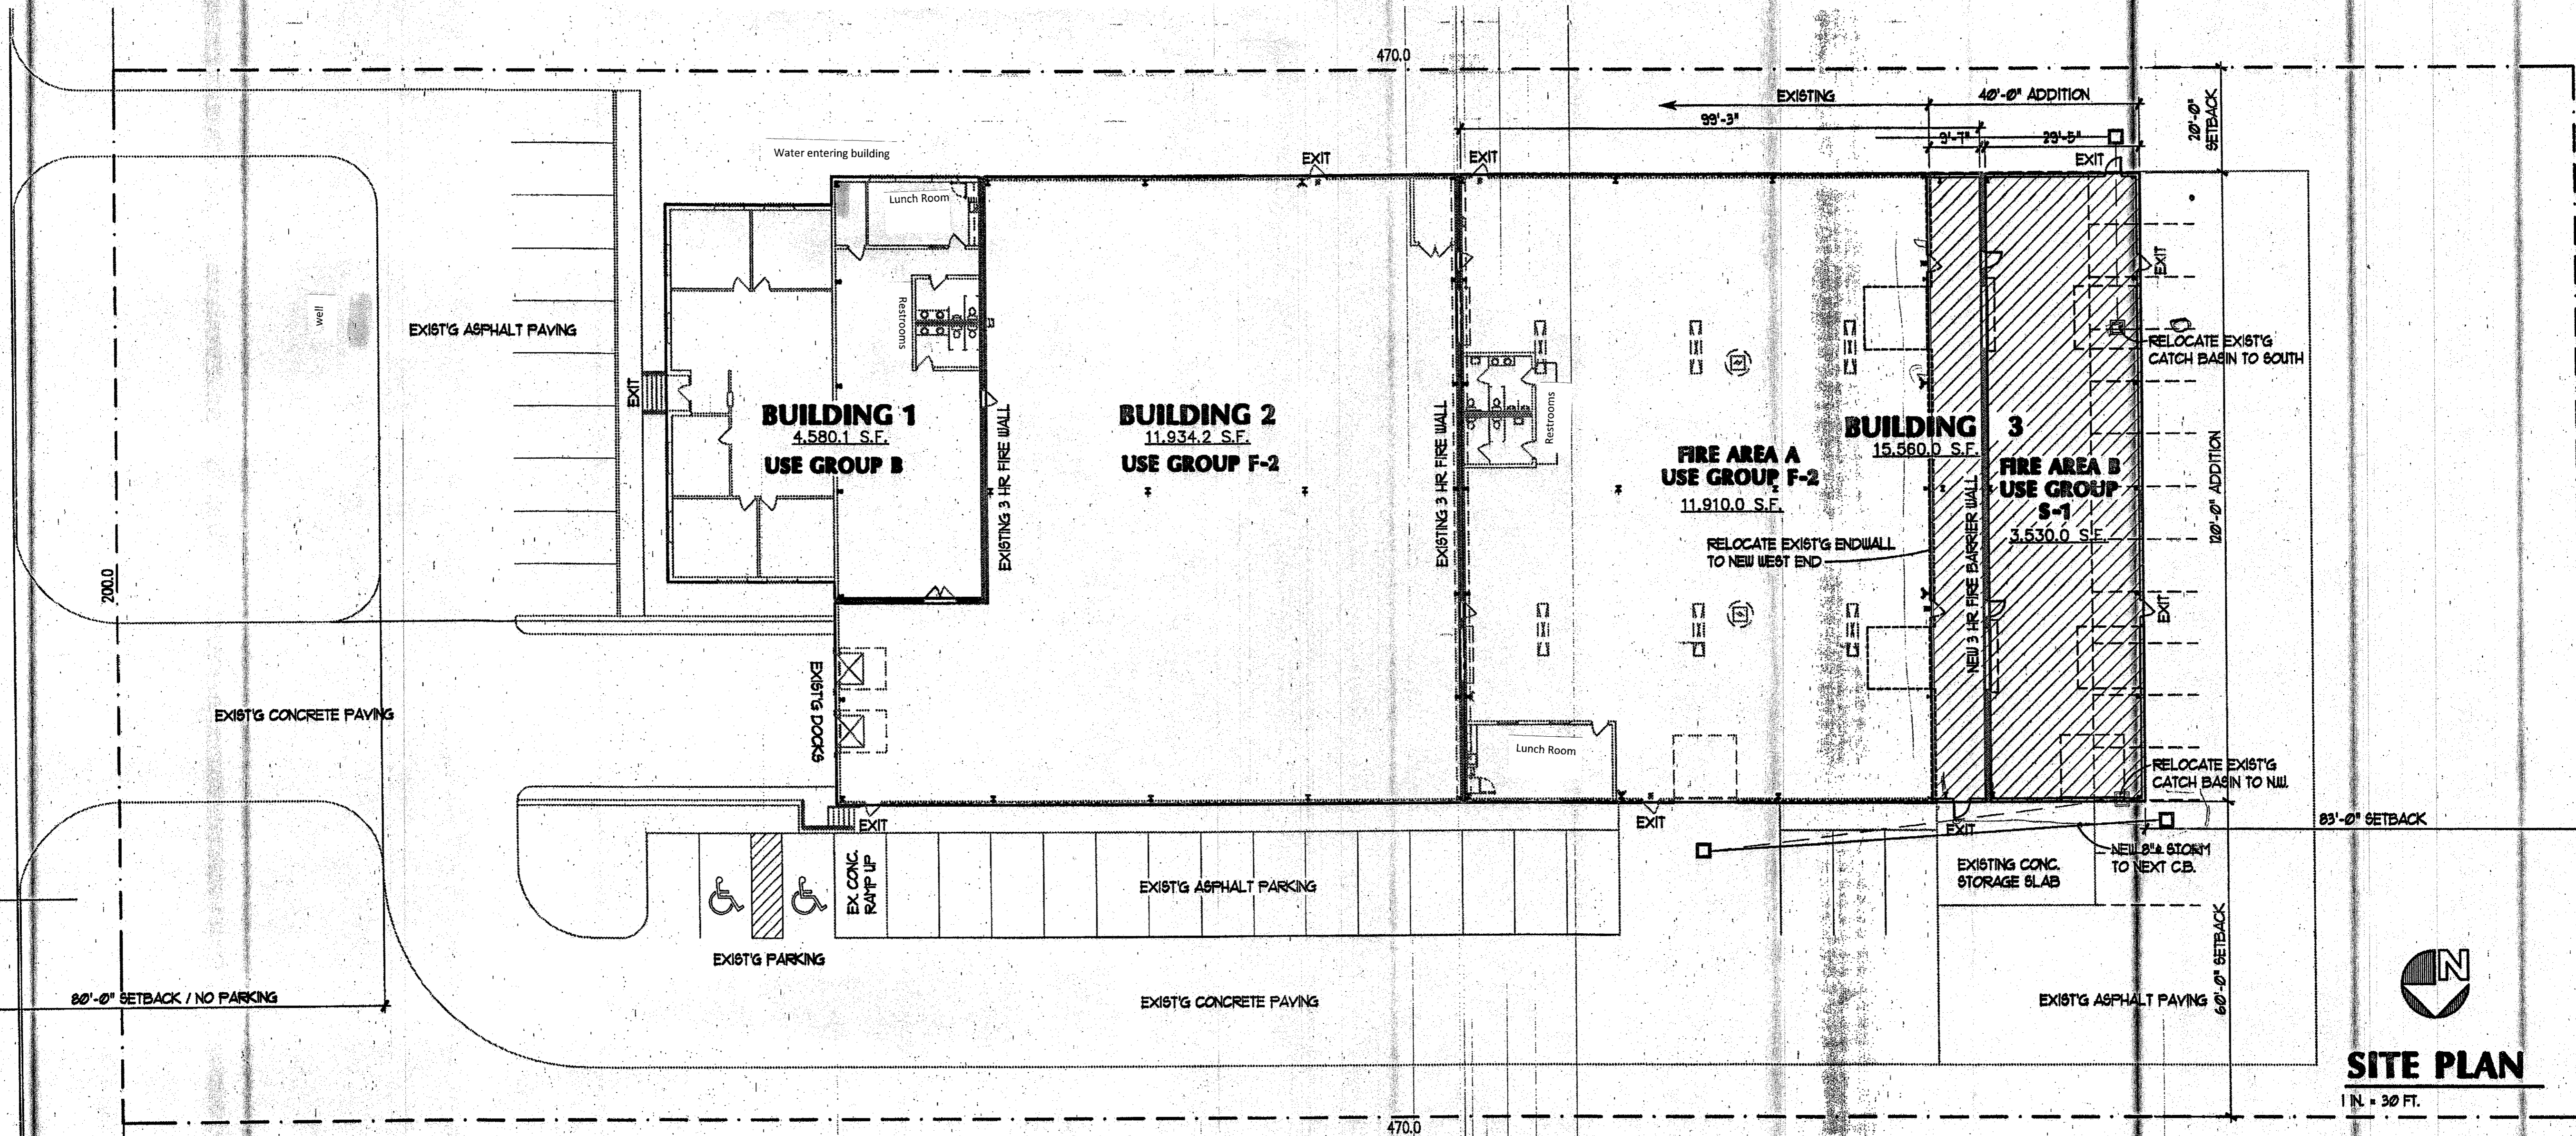

**SITE PLAN**  
 1 IN. = 30 FT.