



NOTES:

1. PARK OFFICE CONSTRUCTED IN EARLY 1980s. SERVICE LINE AND INTERIOR PLUMBING ARE COPPER.
2. RESIDENCE CONSTRUCTION DATE UNKNOWN. SERVICE LINE AND INTERIOR PLUMBING ARE COPPER.

The Blue Non-Lead Water Lines on the Map that I have seen have been PVC. I also talked to the operators before me and they said it is PVC. I have seen Blue PVC and white PVC. The service lines that I have seen and repaired have been the Black Polyethylene Pipe 3/4".

The buildings are the only places I am aware of that have lead. The buildings all have copper pipe and given the age of the buildings they could contain lead solder. I have not seen or heard of any lead pipes. The buildings are all colored yellow on the map.

Proshop 1983
Golfcourse 1983
Lodge 1980
Cabins 1980
Campground 1972
Spray Field 1974
Park Office 1984

LEGEND

LEAD =
NON-LEAD =
NO INFORMATION =

DEER CREEK STATE PARK WTP
20635 STATE PARK ROAD #20
MT. STERLING, OHIO 43143-9501
(740) 513-5613
PWS ID: OH6536712




ENGINEERING
Ohio Department of Natural Resources

**DEER CREEK STATE PARK
PICKAWAY COUNTY**

DESIGNED BY:	JOB NUMBER:
DRAWN BY: TKL	SCALE: 1" = 100'
CHECKED BY:	DATE: FEBRUARY 16, 2017
APPROVED BY:	REVISED:

**WATER DISTRIBUTION
SYSTEM LEAD MAPPING**

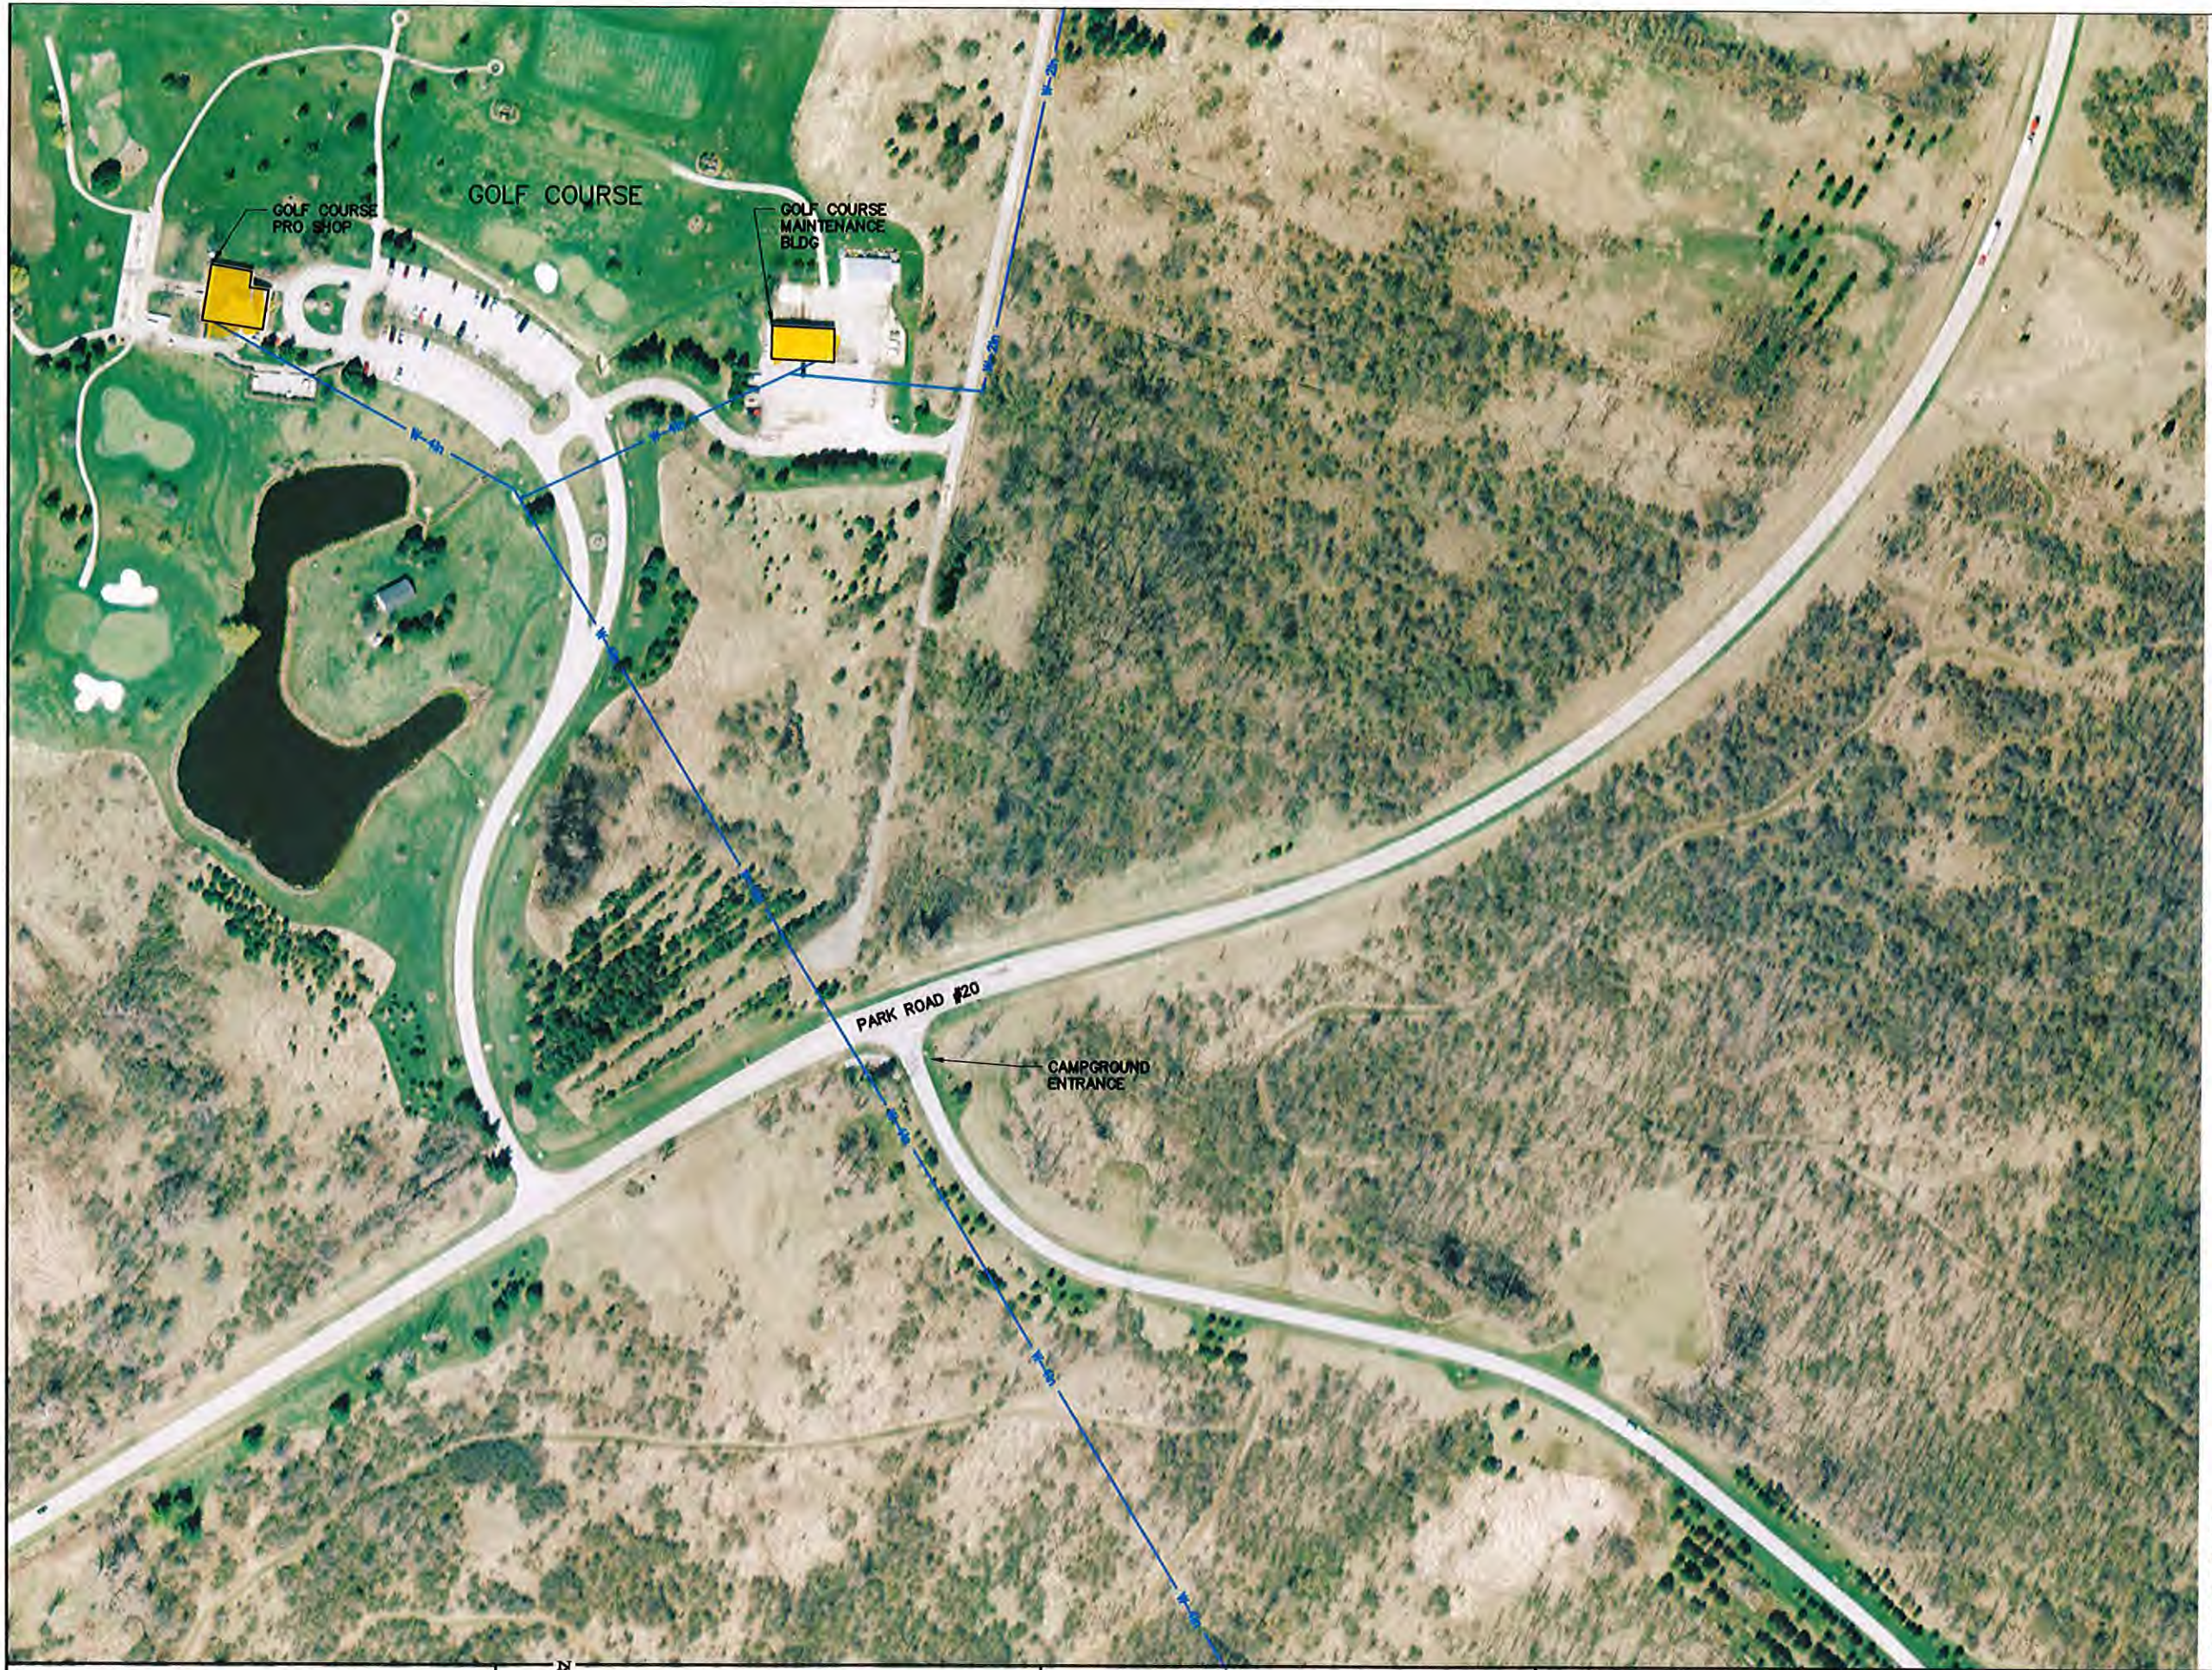

NOTES:
1. PRO SHOP AND GOLF COURSE MAINTENANCE BUILDING CONSTRUCTED IN 1981. SERVICE LINES AND INTERIOR PLUMBING ARE COPPER.

LEGEND
LEAD =
NON-LEAD =
NO INFORMATION =

DEER CREEK STATE PARK WTP
20635 STATE PARK ROAD #20
MT. STERLING, OHIO 43143-9501
(740) 513-5613
PWS ID: OH6536712



NOTES:

1. CAMPGROUND CONSTRUCTED IN 1971. SERVICE LINES AND INTERIOR PLUMBING ARE COPPER TO ALL BUILDINGS.
2. WTP CONSTRUCTED IN 1999. SERVICE LINE AND INTERIOR PLUMBING ARE COPPER.

LEGEND

- LEAD =
- NON-LEAD =
- NO INFORMATION =

DEER CREEK STATE PARK WTP
20635 STATE PARK ROAD #20
MT. STERLING, OHIO 43143-9501
(740) 513-5613
PWS ID: OH6536712




ENGINEERING
Ohio Department of Natural Resources

**DEER CREEK STATE PARK
PICKAWAY COUNTY**

DESIGNED BY:	JOB NUMBER:
DRAWN BY: TKL	SCALE: 1" = 100'
CHECKED BY:	DATE: FEBRUARY 16, 2017
APPROVED BY:	REVISED:

**WATER DISTRIBUTION
SYSTEM LEAD MAPPING**

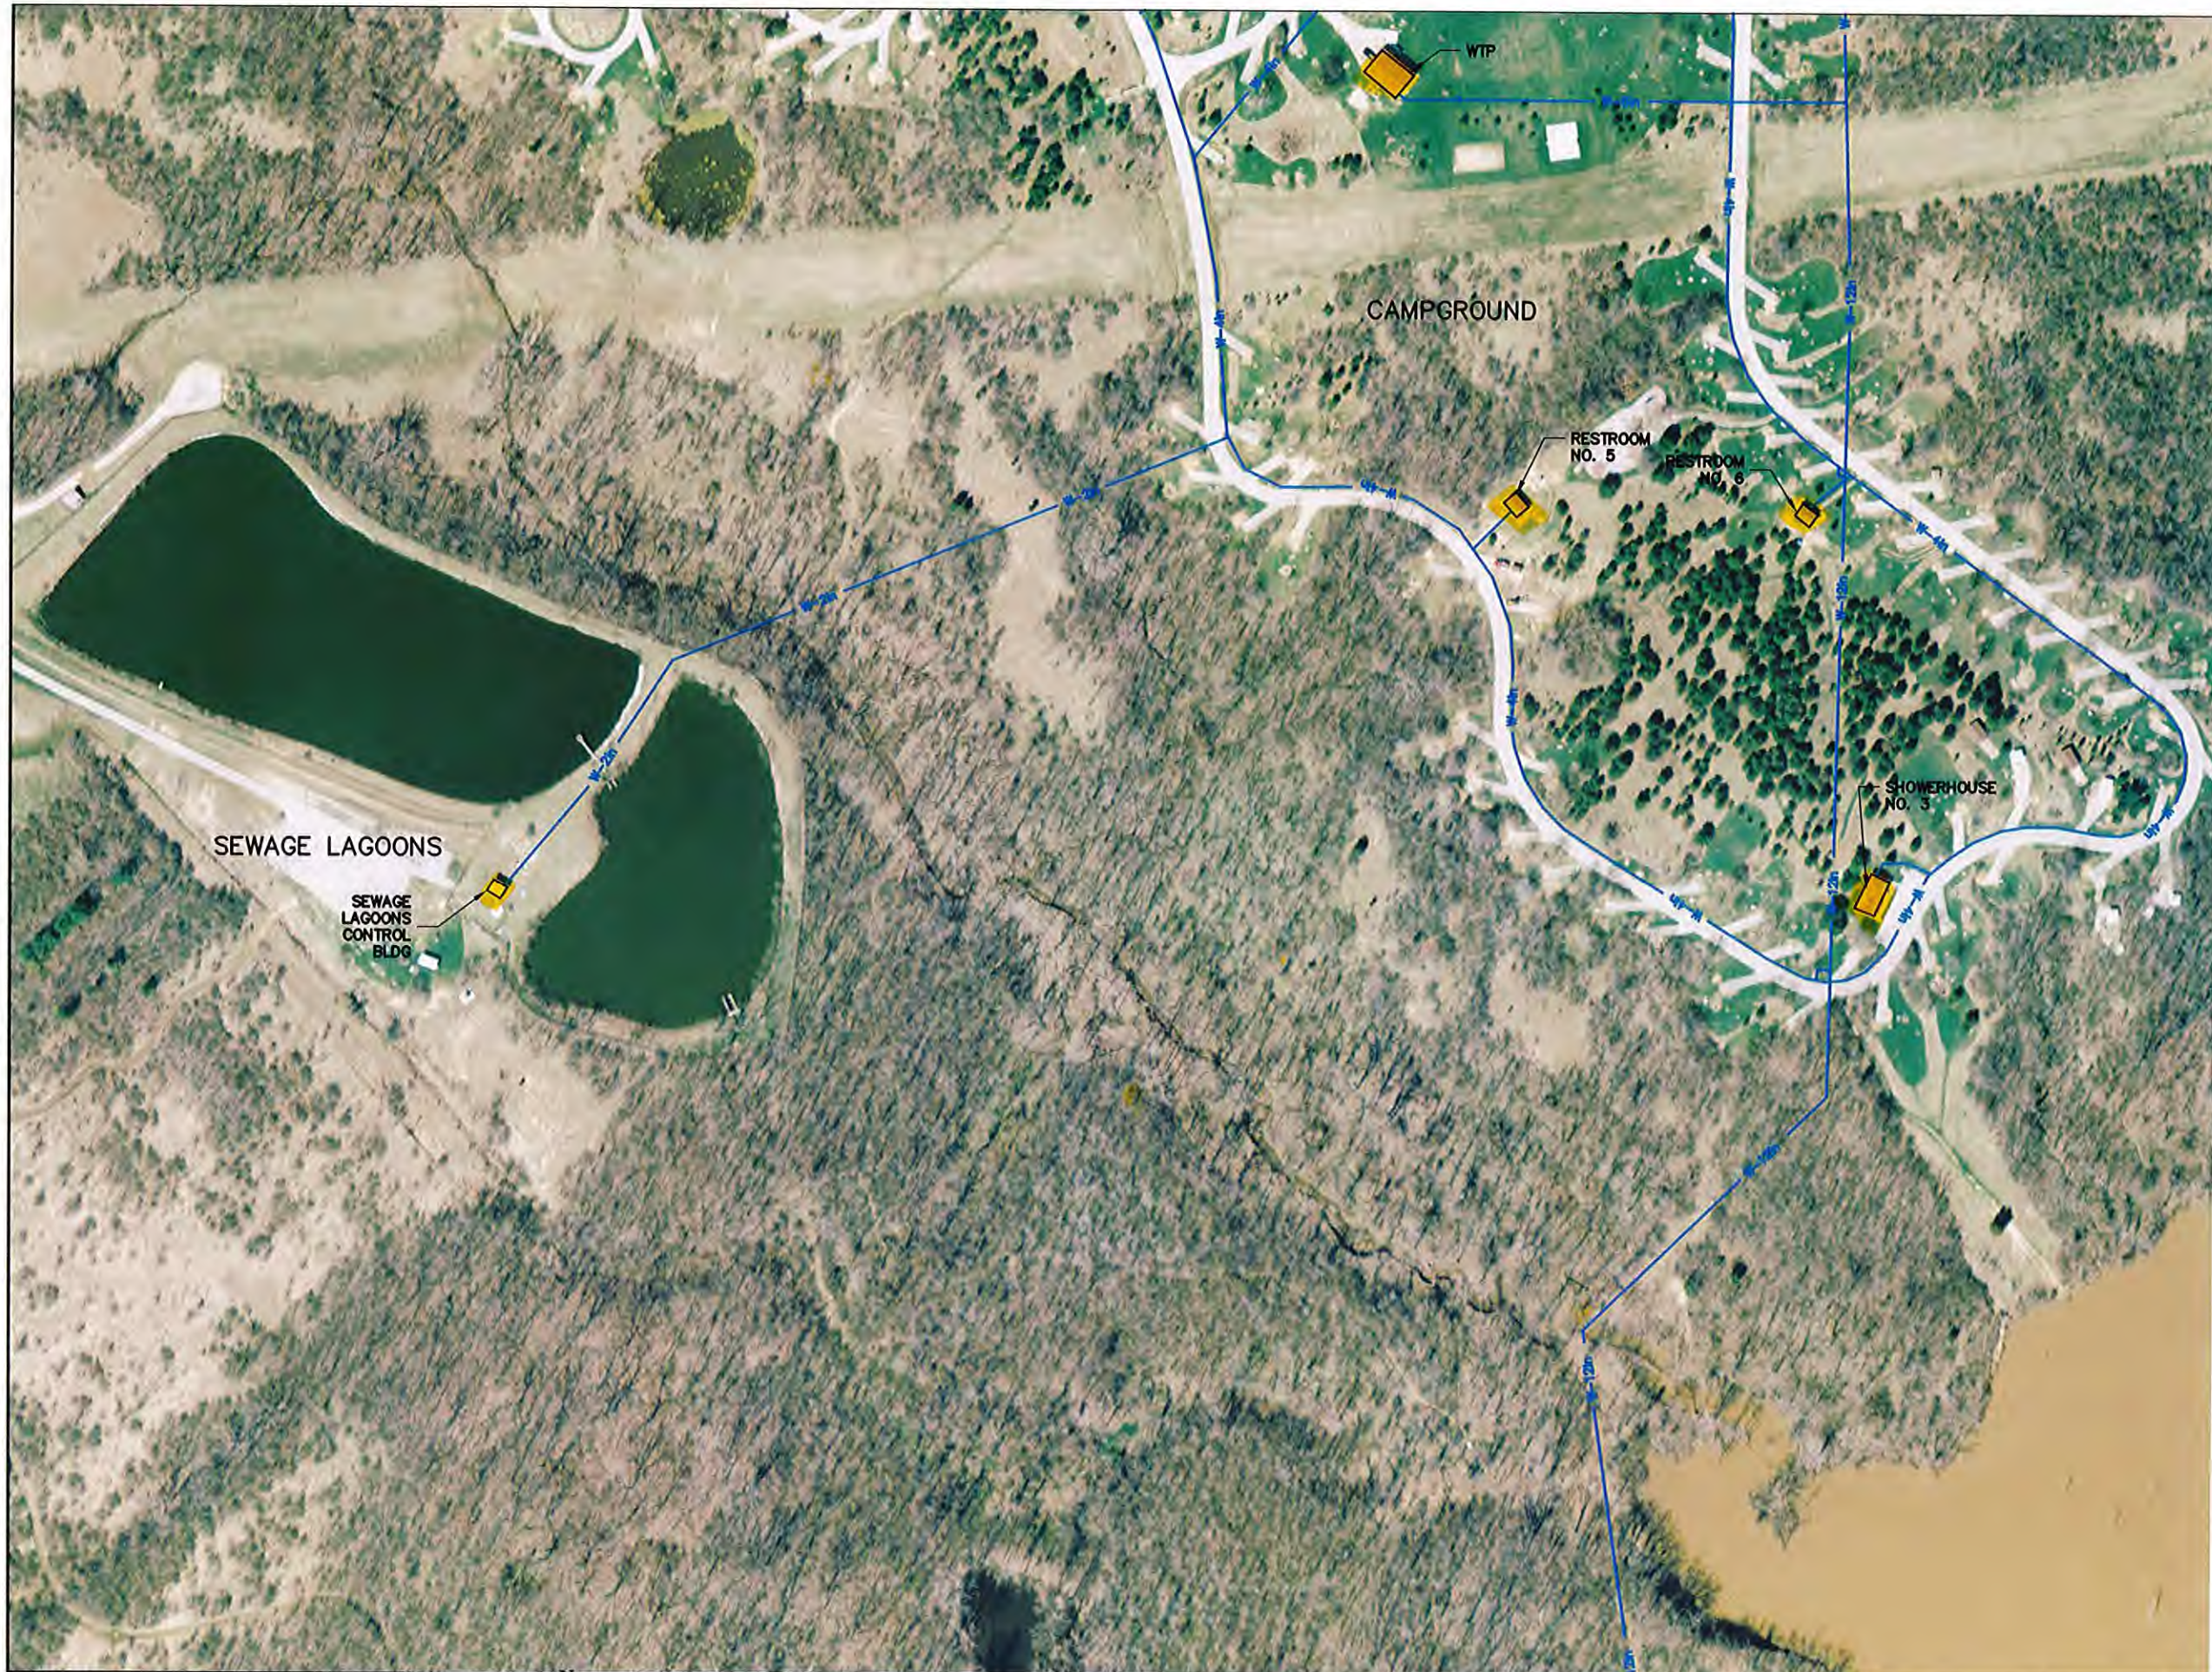

NOTES:

1. CAMPGROUND CONSTRUCTED IN 1971. SERVICE LINES AND INTERIOR PLUMBING ARE COPPER.
2. SEWAGE LAGOON CONSTRUCTED IN 1975. SERVICE LINE AND INTERIOR PLUMBING ARE COPPER.

LEGEND

- LEAD =
- NON-LEAD =
- NO INFORMATION =

DEER CREEK STATE PARK WTP
20635 STATE PARK ROAD #20
MT. STERLING, OHIO 43143-9501
(740) 513-5613
PWS ID: OH6536712



ENGINEERING
Ohio Department of Natural Resources

**DEER CREEK STATE PARK
PICKAWAY COUNTY**

DESIGNED BY:	JOB NUMBER:
DRAWN BY: TKL	SCALE: 1" = 100'
CHECKED BY:	DATE: FEBRUARY 15, 2017
APPROVED BY:	REVISED:

**WATER DISTRIBUTION
SYSTEM LEAD MAPPING**



NOTES:

1. LODGE CONSTRUCTED IN 1978. SERVICE LINE AND INTERIOR PLUMBING ARE COPPER.

LEGEND

LEAD =

NON-LEAD =

NO INFORMATION =

DEER CREEK STATE PARK WTP
20635 STATE PARK ROAD #20
MT. STERLING, OHIO 43143-9501
(740) 513-5613
PWS ID: OH6536712



ENGINEERING
Ohio Department of Natural Resources

**DEER CREEK STATE PARK
PICKAWAY COUNTY**

DESIGNED BY:
DRAWN BY: TKL
CHECKED BY:
APPROVED BY:

JOB NUMBER:
SCALE: 1" = 100'
DATE: FEBRUARY 16, 2017
REVISED:

**WATER DISTRIBUTION
SYSTEM LEAD MAPPING**



NOTES:

1. CABINS CONSTRUCTED IN 1978. SERVICE LINES AND INTERIOR PLUMBING ARE COPPER.

LEGEND

LEAD = ■

NON-LEAD = ■

NO INFORMATION = ■

DEER CREEK STATE PARK WTP
20635 STATE PARK ROAD #20
MT. STERLING, OHIO 43143-9501
(740) 513-5613
PWS ID: OH6536712



ENGINEERING
Ohio Department of Natural Resources

DEER CREEK STATE PARK
PICKAWAY COUNTY

DESIGNED BY:
DRAWN BY: TKL
CHECKED BY:
APPROVED BY:

JOB NUMBER:
SCALE: 1" = 100'
DATE: FEBRUARY 16, 2017
REVISED:

WATER DISTRIBUTION
SYSTEM LEAD MAPPING

