


LEAD COPPER SAMPLE FROM PLUMBING GROUP 1

← NORTH

RECEIVED
FEB 28 2017
Central District Office
Ohio EPA

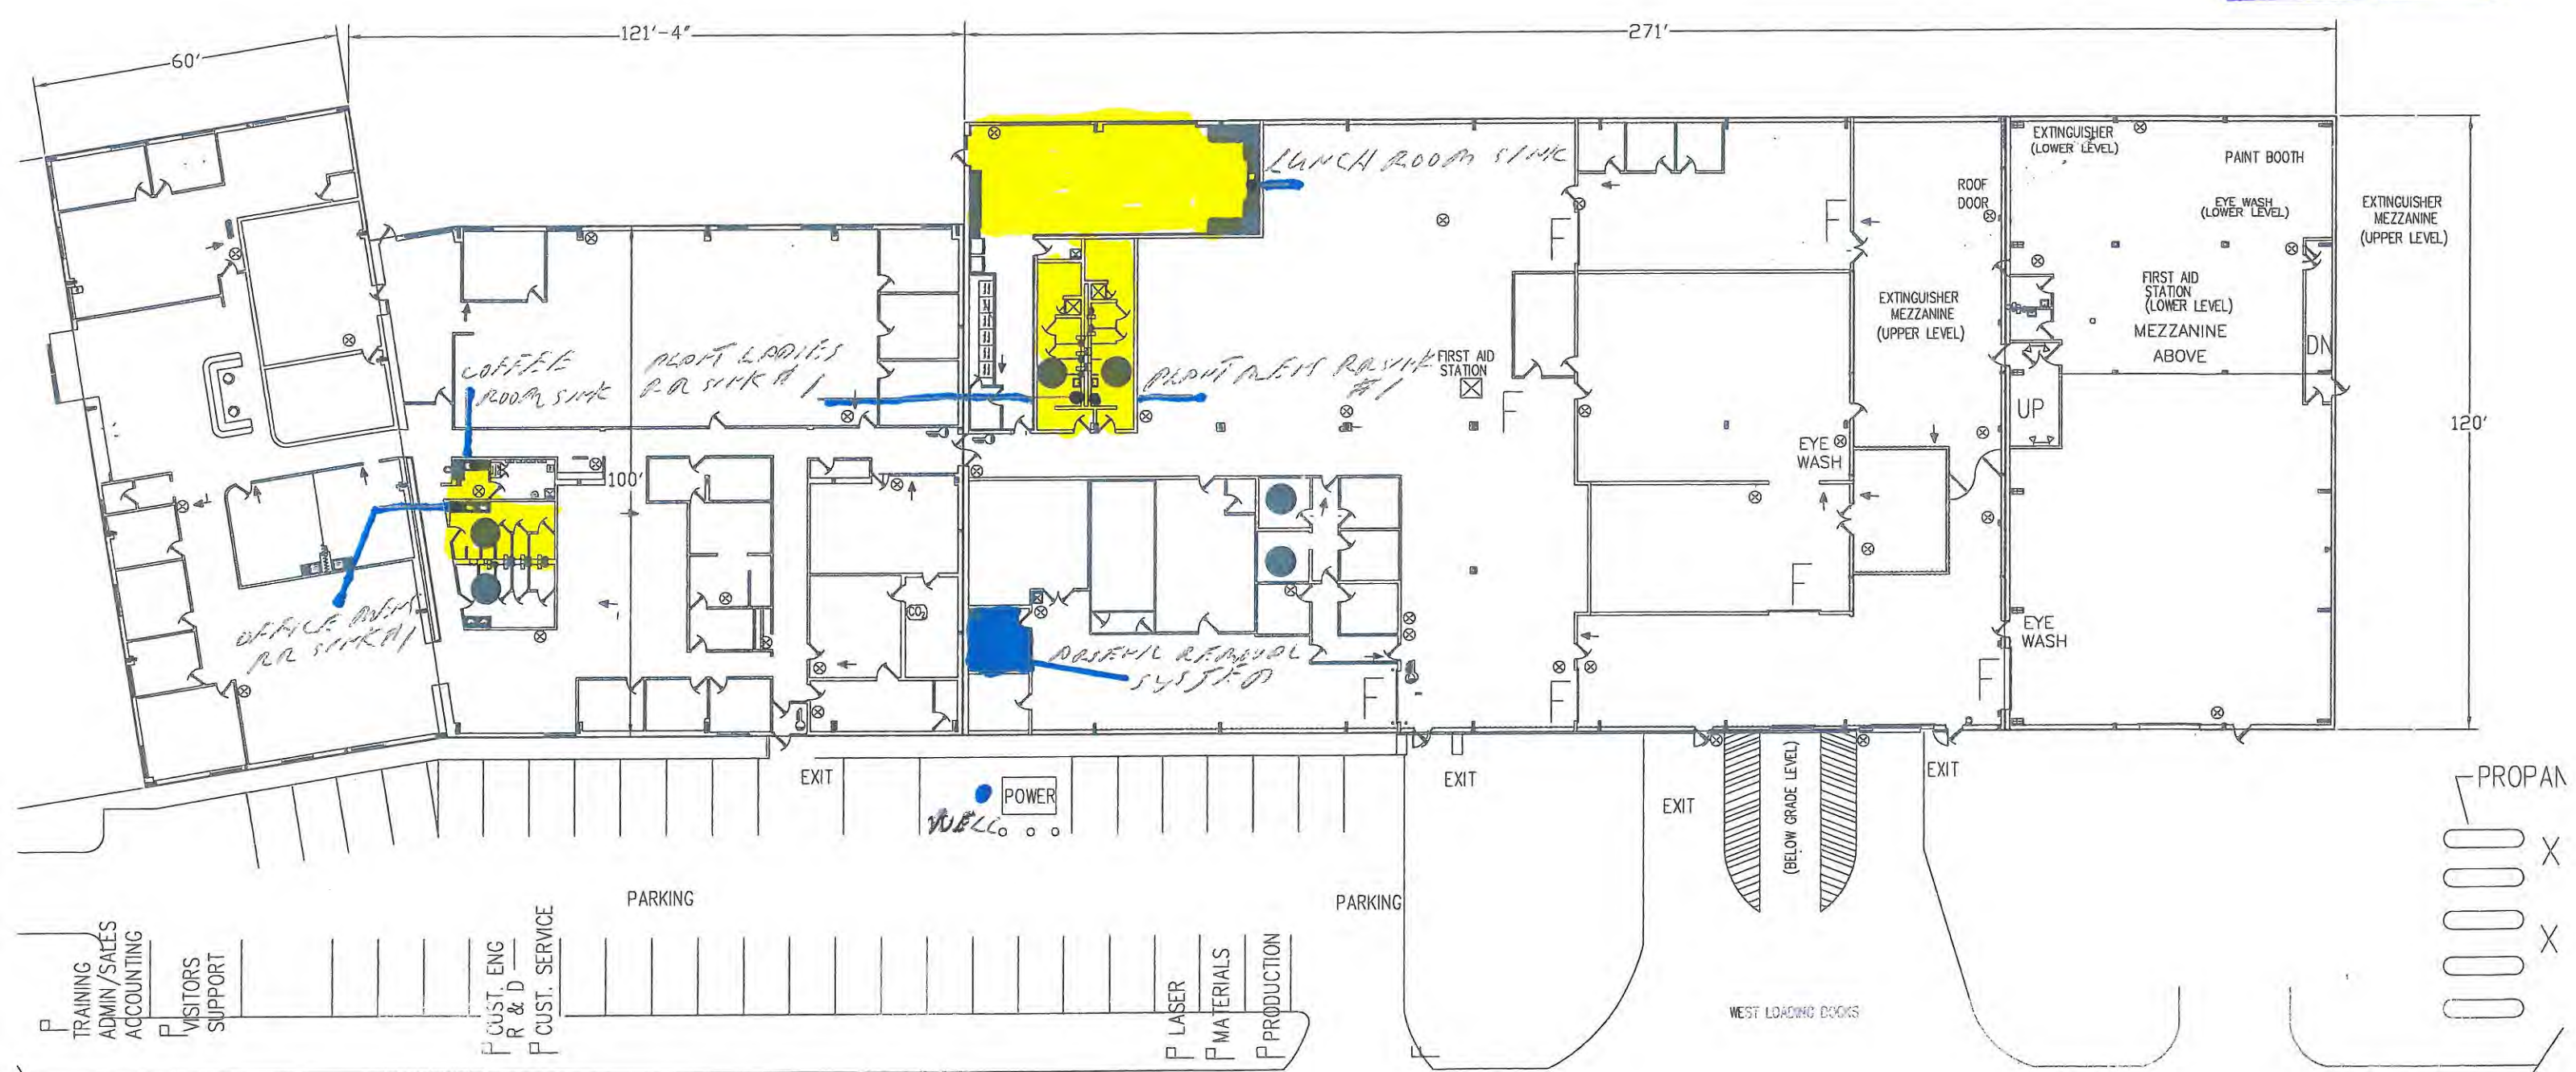

Building was constructed 1993 Revised 1994

Building is lead piping free

Distribution Line- Copper

Well PVC

Plant line to Distribution schedule 80 Piping

PWS Name Telesis Technologies

PWSID* 6539812

Type of System Nontransient Non Community

Contacts Dan George 740-477-5000 Email; dangeo@telesistech.com

Larry McFarland 740-207-7569 Email; larrym921@aol.com