


St. Louisville P.M.S.
 St. Louisville OHIO
 43071
 OH 4504012

ALL MAINS ARE PLASTIC.



- LEAD
- NON LEAD
- UNKNOWN
- SAMPLE SITES

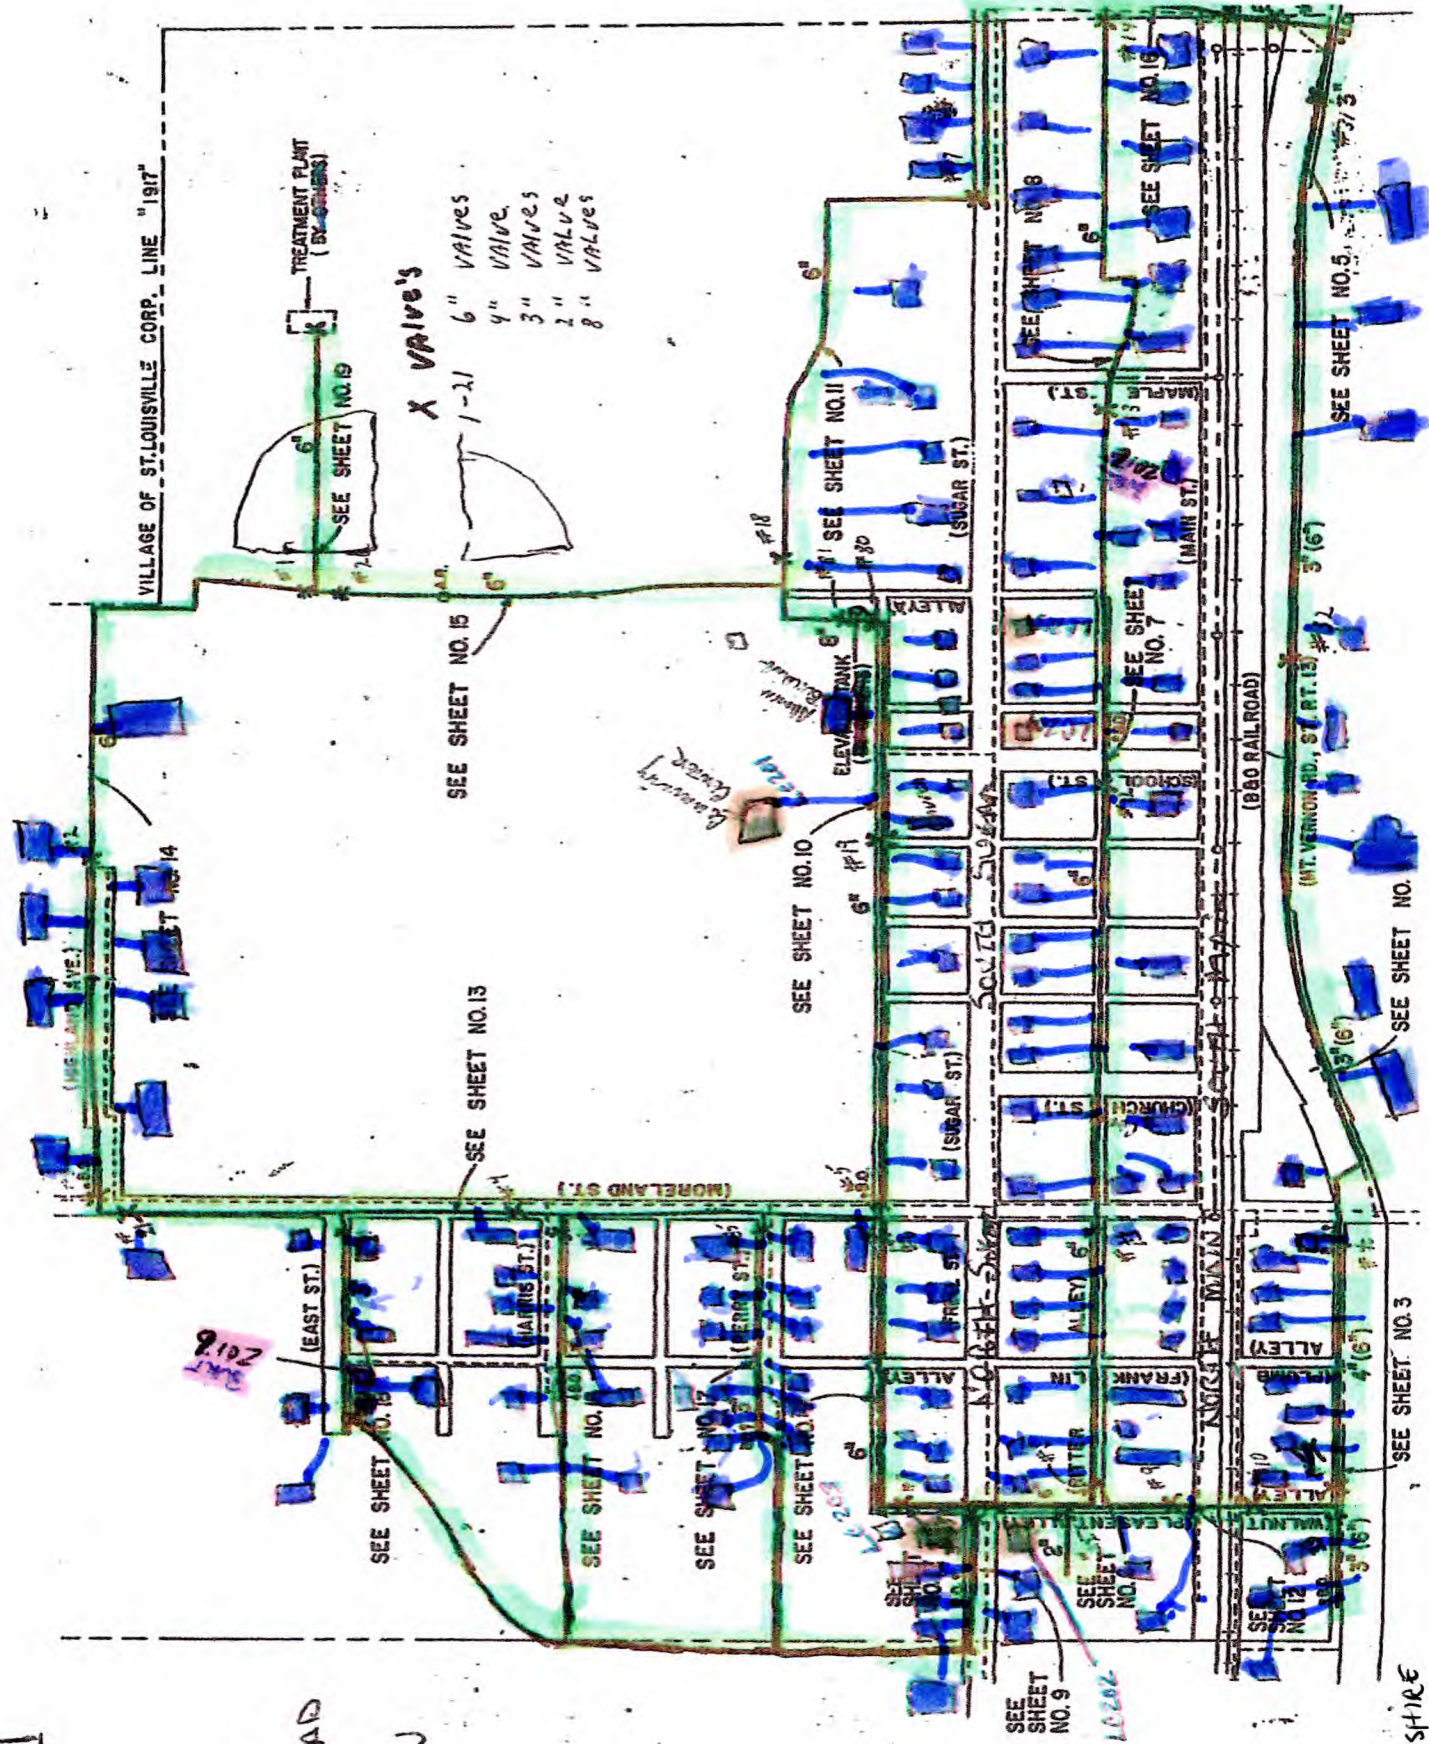

Prepared By K. Hampshire

*St. Louisville Village
Public Water System*

OH4504012

The water system was installed in 1981. All water mains installed were plastic pipe. They have been repaired with plastic. Service lines are unknown, because tap inspection cards were not mark for type of line installed. The inspection cards have size and locations. 99% of the buildings were built before 1986. Therefore, the inside plumbing is not exactly known. The other 1% was just built or rebuilt last year (2016). They were built using PEX pipe.

KEITH HAMPSHIRE

OPERATOR OF RECORD