


ALL SERVICE SAMPLE POINT ARE LOCATED AT 1181 OHLTOWN-MCDONALD RD. MINERAL RIDGE, OHIO 44440
ALL SERVICES ARE (PRIVATE SIDE PROPERTY OWNER'S RESPONSIBILITY)
PWS ID NUMBER OH7801811 WATER FACILITY STATE CODE 7859128

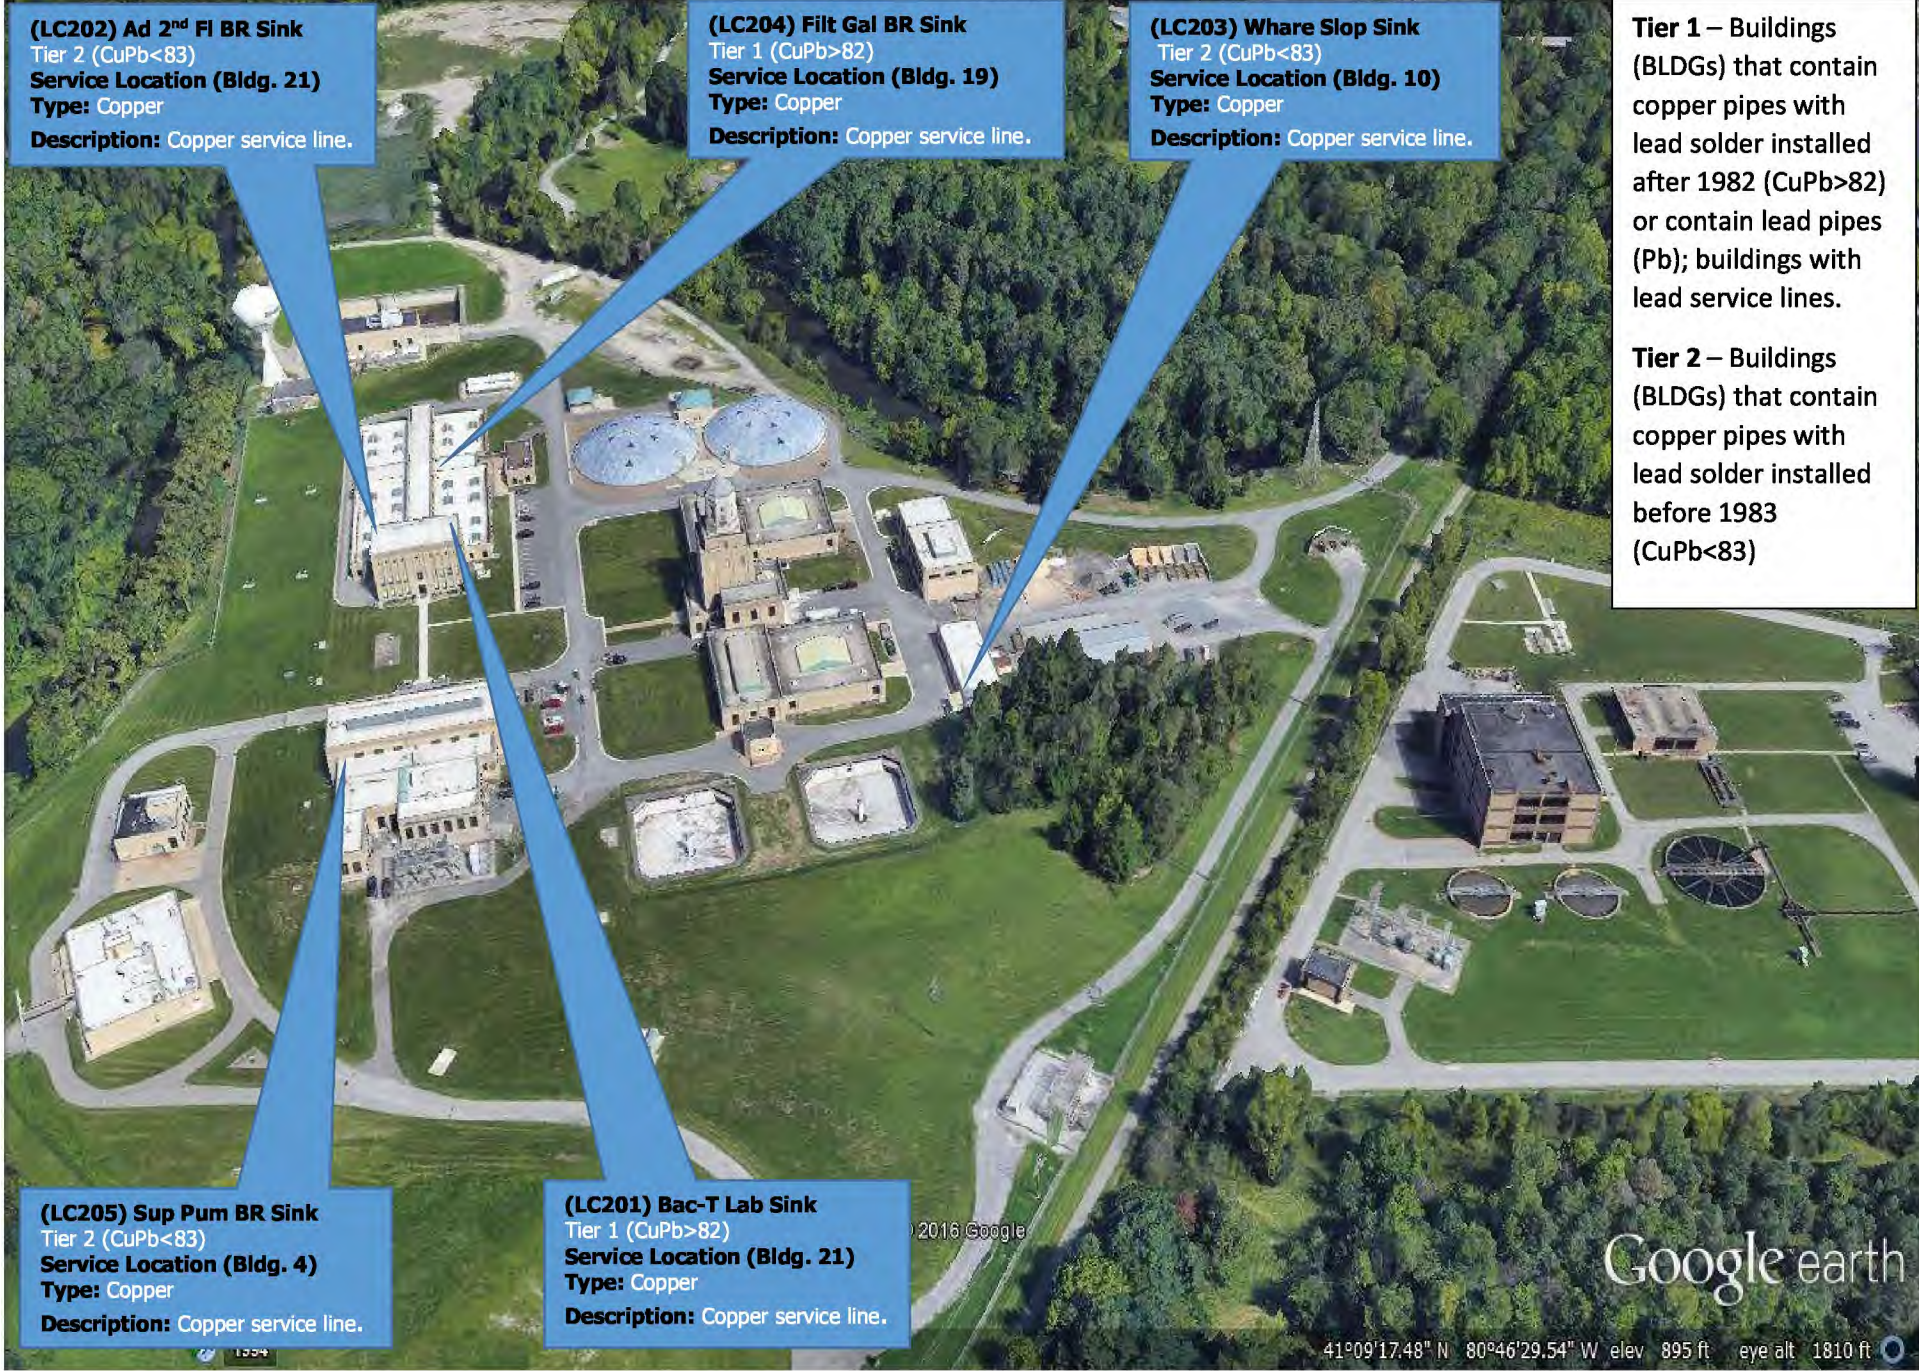

(LC202) Ad 2nd FI BR Sink
Tier 2 (CuPb<83)
Service Location (Bldg. 21)
Type: Copper
Description: Copper service line.

(LC204) Filt Gal BR Sink
Tier 1 (CuPb>82)
Service Location (Bldg. 19)
Type: Copper
Description: Copper service line.

(LC203) Whare Slop Sink
Tier 2 (CuPb<83)
Service Location (Bldg. 10)
Type: Copper
Description: Copper service line.

Tier 1 – Buildings (BLDGs) that contain copper pipes with lead solder installed after 1982 (CuPb>82) or contain lead pipes (Pb); buildings with lead service lines.

Tier 2 – Buildings (BLDGs) that contain copper pipes with lead solder installed before 1983 (CuPb<83)

(LC205) Sup Pum BR Sink
Tier 2 (CuPb<83)
Service Location (Bldg. 4)
Type: Copper
Description: Copper service line.

(LC201) Bac-T Lab Sink
Tier 1 (CuPb>82)
Service Location (Bldg. 21)
Type: Copper
Description: Copper service line.