
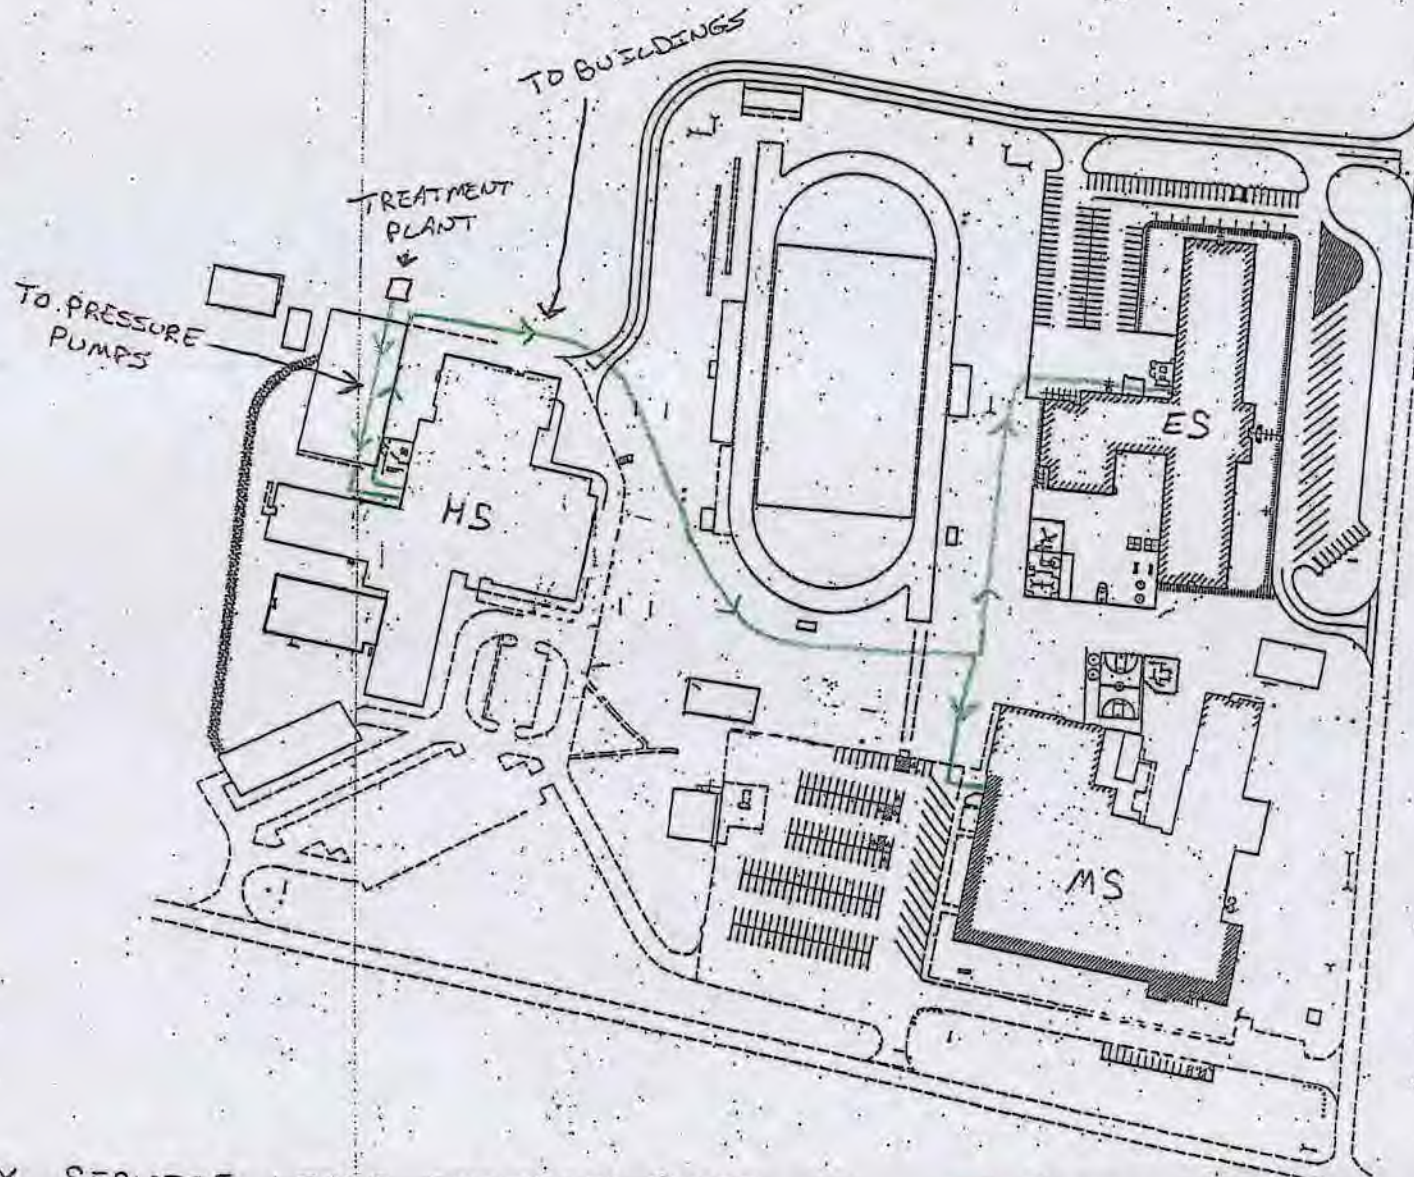


RE: Crestview Local Schools
Report
Drinking Water Program
Richland County
PWS ID: OH7049412

CRESTVIEW LOCAL SCHOOLS

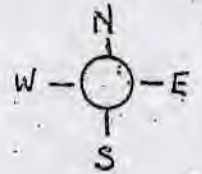

* SERVICE LINES INSTALLED 2005
USING PLASTIC PIPE

- SERVICE LINES
- COLD
- HOT


RECEIVED
MAR 02 2017
DDAGW - NWDO




CRESTVIEW MIDDLE SCHOOL

RECEIVED
MAR 02 2017
DDAGW - NWDO

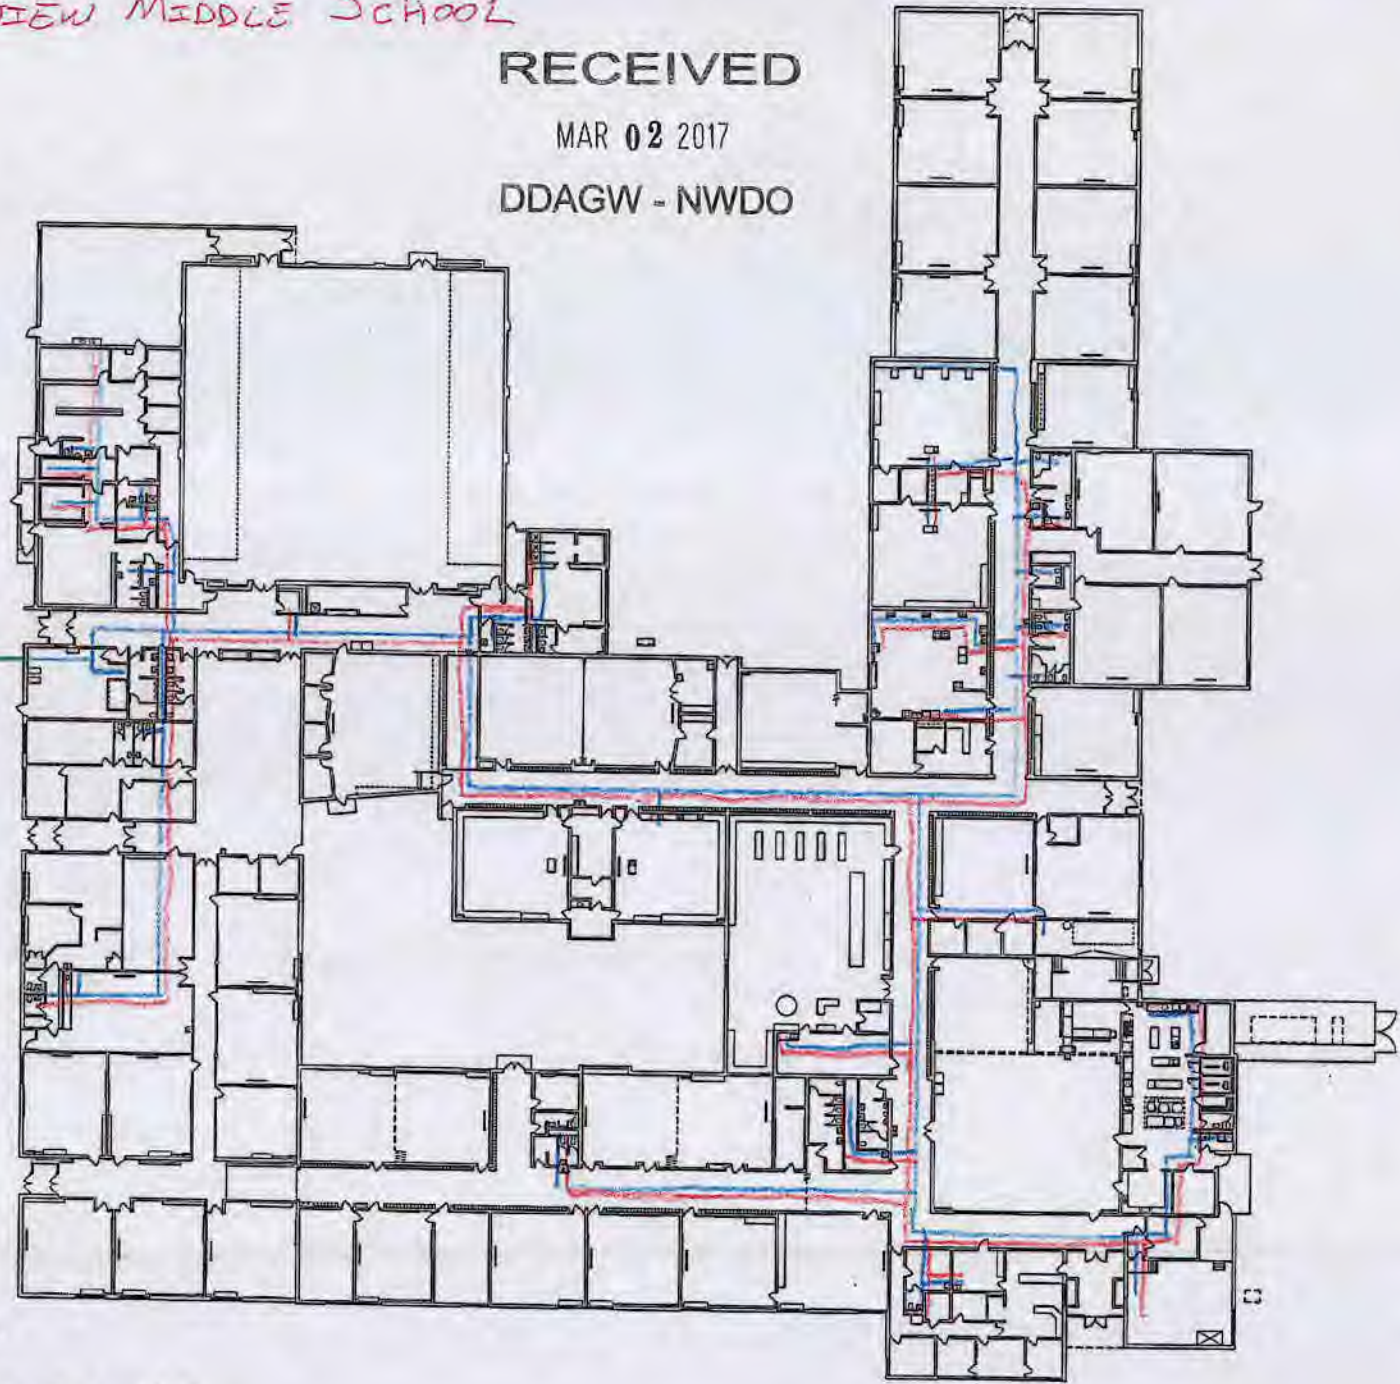

FROM TREATMENT
PLANT




-  = COLD
-  = HOT
-  = SERVICE LINE

BUILDING WAS CONSTRUCTED IN 1963, 1970, AND 1993 WITH
HOT AND COLD WATER LINES REPLACED IN 2005 WITH
COPPER PIPE AND SOLDER JOINTS

CRESTVIEW ELEMENTARY

N →

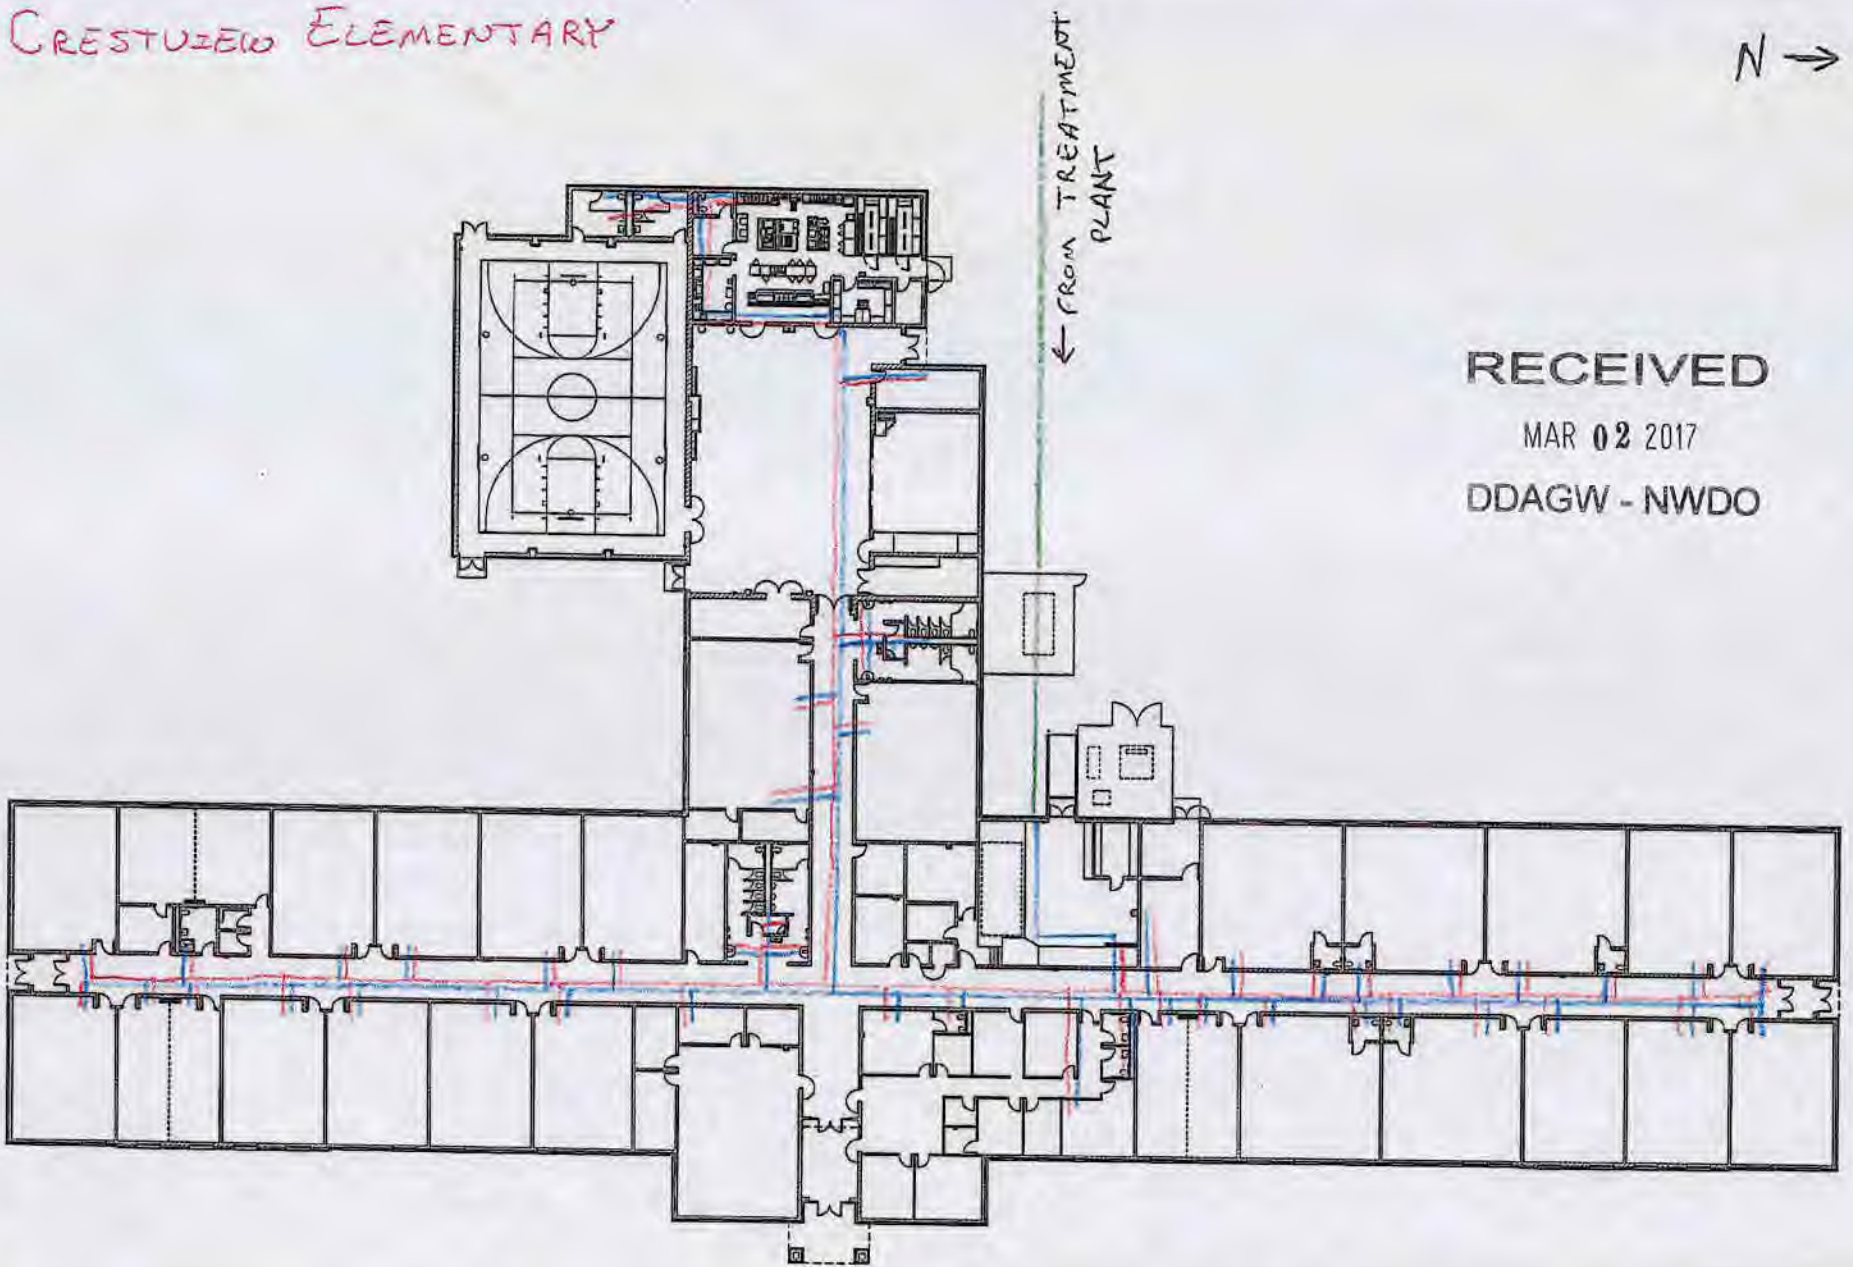

RECEIVED

MAR 02 2017

DDAGW - NWDO

- = COLD
- = HOT
- = SERVICE LINE


BUILDING WAS CONSTRUCTED IN 2005 WITH COPPER PIPE AND SOLDER JOINTS

CRESTVIEW HIGH SCHOOL N →

RECEIVED

MAR 02 2017

DDAGW - NWDO

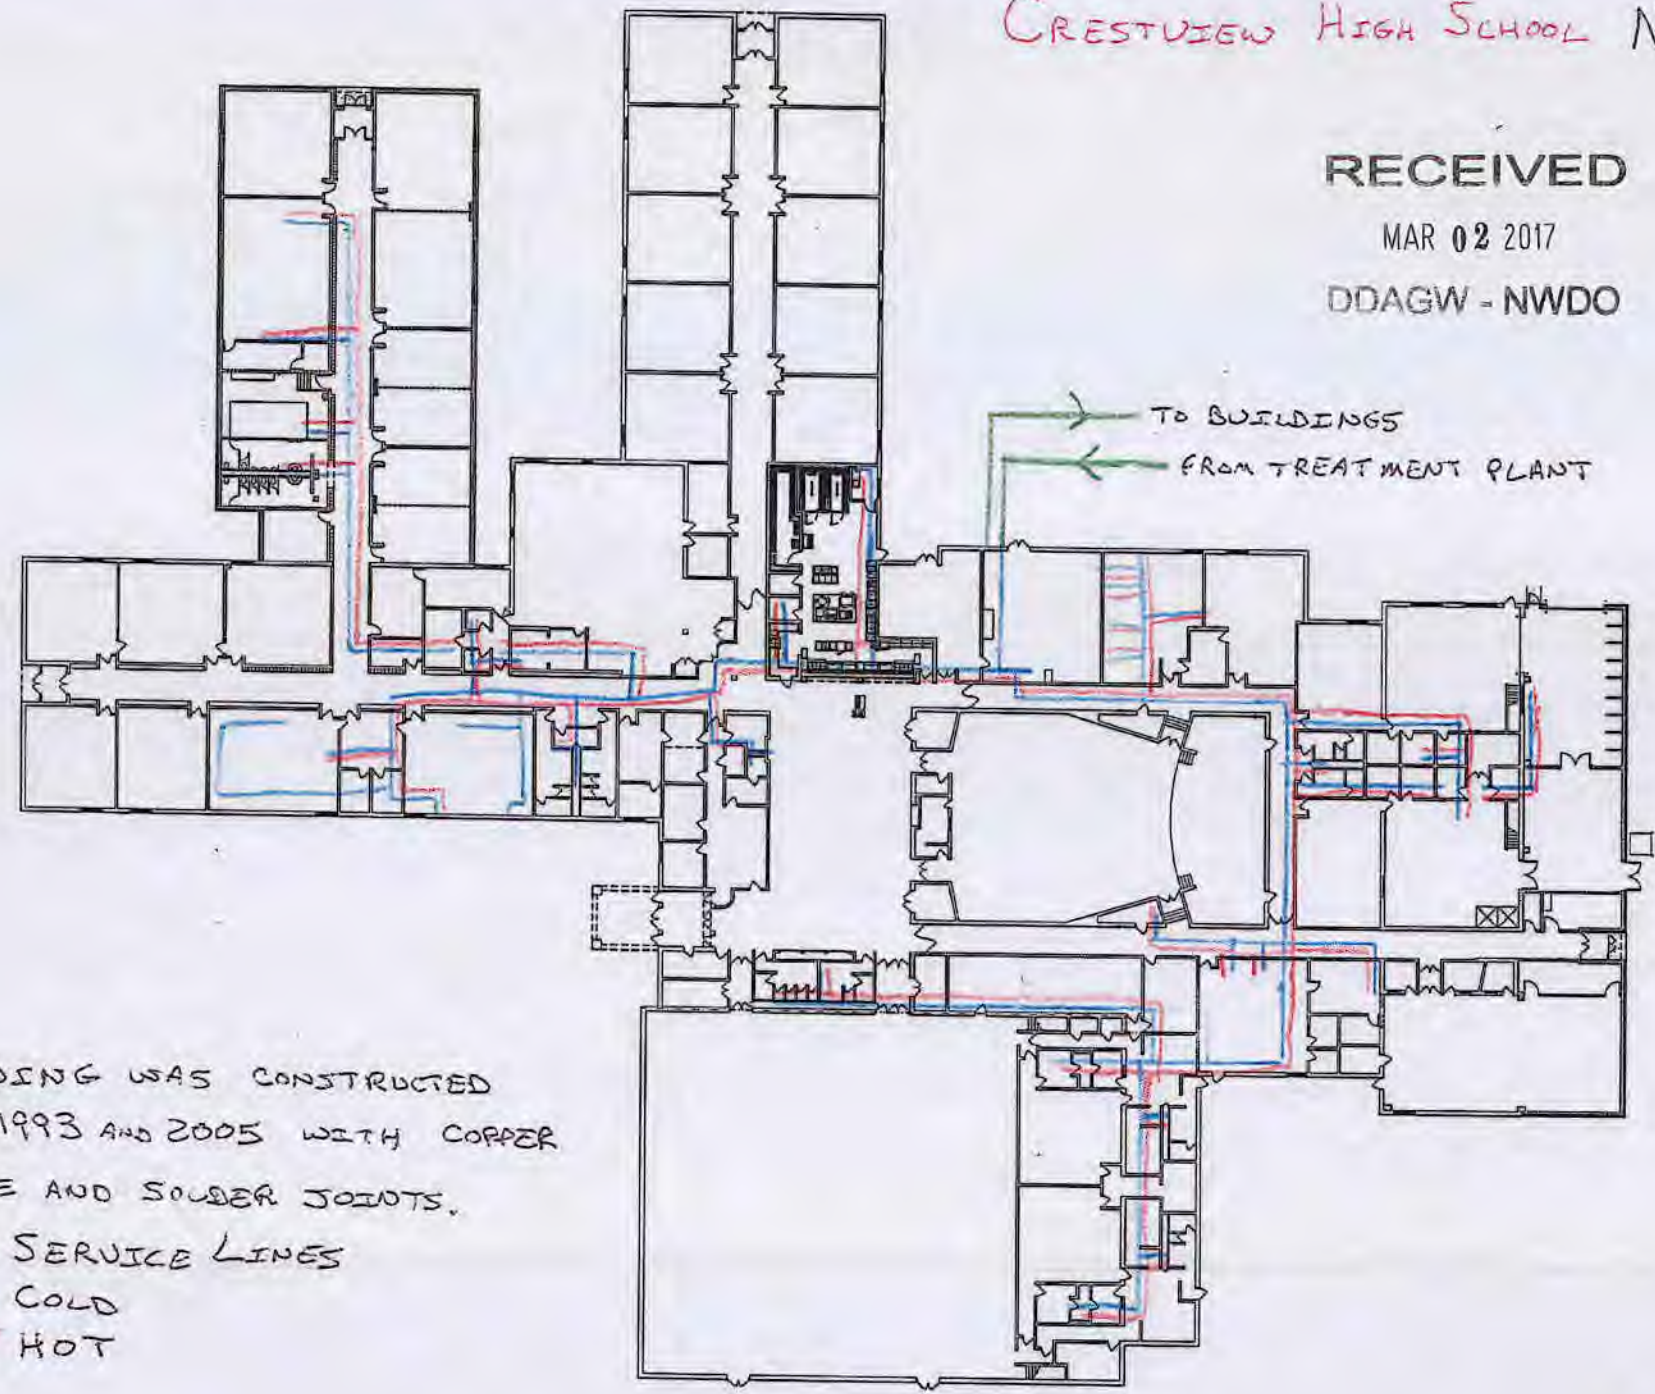

TO BUILDINGS
FROM TREATMENT PLANT

BUILDING WAS CONSTRUCTED
IN 1993 AND 2005 WITH COPPER
PIPE AND SOLDER JOINTS.

- SERVICE LINES
- COLD
- HOT