

RE: Willard MHP
Report
Drinking Water Program
Huron County
PWS ID: OH3901612

RECEIVED

MAR 03 2017

DDAGW - NWDO

LEAD AND COPPER SAMPLE SITES:

- ① LC201 - LOT # 1 - VICKIE FOREMAN
- ② LC202 - LOT # 31 - MARTHA PALMISON
- ③ LC203 - LOT # 33 - LOIS LUNA
- ④ LC204 - LOT # 45 - ROBERT HALE
- ⑤ LC205 - LOT # 54 - THOMAS ALBRIGHT



LEGEND


- GALVANIZED WATER MAINS AND/OR WATER SERVICE CONNECTIONS
- LEAD AND COPPER SAMPLE SITES

NOTE:

WILLARD MHP WAS CONSTRUCTED AFTER 1965.

NOTE:

BUILDINGS IN OHIO BUILT PRIOR TO 1998 OR THAT USE PLUMBING MATERIAL OR SOLDER MANUFACTURED BEFORE 1998 MAY HAVE MATERIALS WITH GREATER THAN 8% LEAD AND ARE AT A HIGHER RISK OF CONTRIBUTING LEAD TO THE DRINKING WATER THAN MATERIALS MANUFACTURED AFTER 1998. IN ADDITION, BUILDINGS BUILT AND PLUMBING MATERIALS MANUFACTURED AFTER 2014 WERE REQUIRED TO HAVE LESS THAN 0.25% LEAD BY WEIGHT AND HAVE THE LOWEST RISK FOR CONTRIBUTING LEAD TO THE DRINKING WATER. IT SHOULD BE NOTED HOWEVER THAT, ALTHOUGH PROHIBITED, SOME USE OF LEADED SOLDER OR LEADED COMPONENTS MAY HAVE OCCURRED AFTER THE PROHIBITIONS BECAME EFFECTIVE.

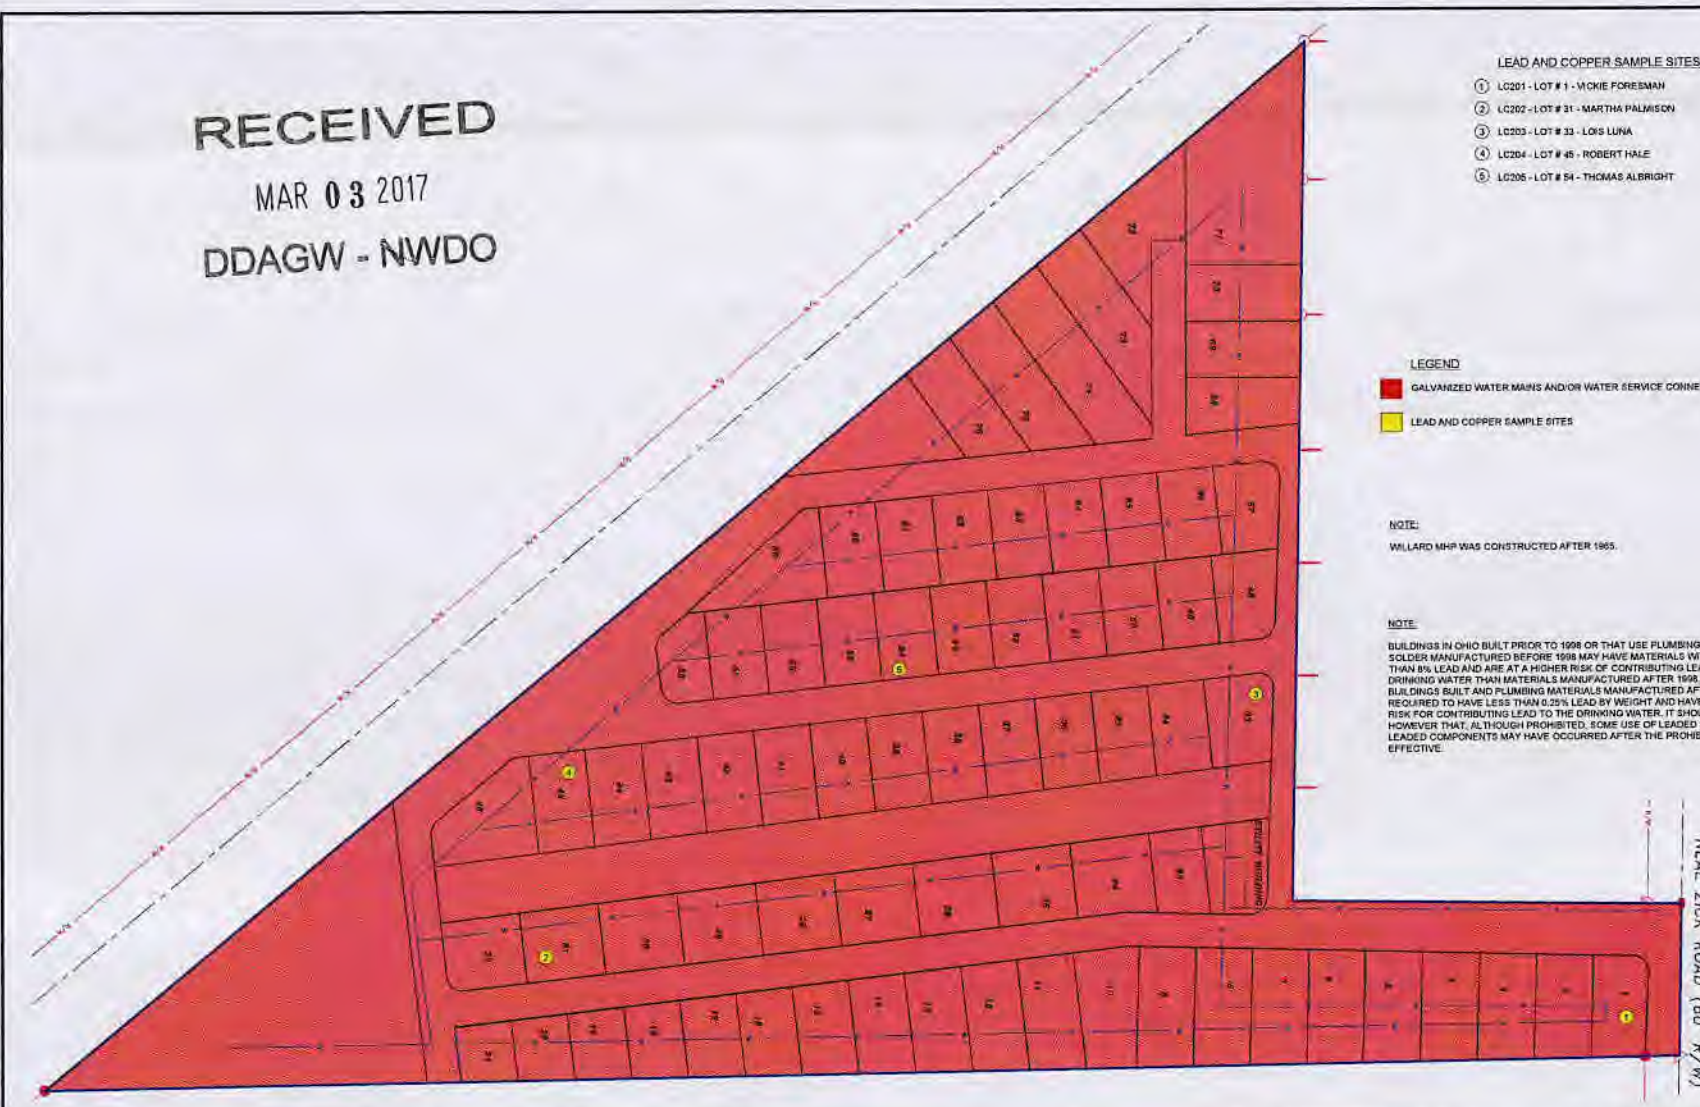

EASEMENT REFERENCE		
City's No.	County Recorder's Volume Page	Contractor

REVISIONS		
No.	Description	Approval Date
	AS BUILT	



LEAD MAPPING IN DISTRIBUTION SYSTEM
PWS ID: OH3901612

ENG. FILE NO.	
IMP. ACCT. NO.	
CONTRACT NO.	
COMPLETION DATE	
CONTRACTOR	

WILLARD MHP
3265 NEAL ZICK RD
WILLARD, OHIO 44890

Scale - Horiz = AS NOTED
Vert = AS NOTED
Original Sheet Size = 24" x 36"
Original Date = 03/02/2017

Sheet No. = 1 OF 1
S:\2013\10\04\005
Sug. No. = 2013-024-005

FRBW PROPERTIES LTD DBA WILLARD MHP

OH 3901612