


LEAD MONITORING TEST POINTS \* 3 DOWNSTAIRS 2 UPSTAIRS

CHILLICOTHE RD. - CHESTER TOWN CENTER

2ND FLOOR OFFICES - ALL VACANT

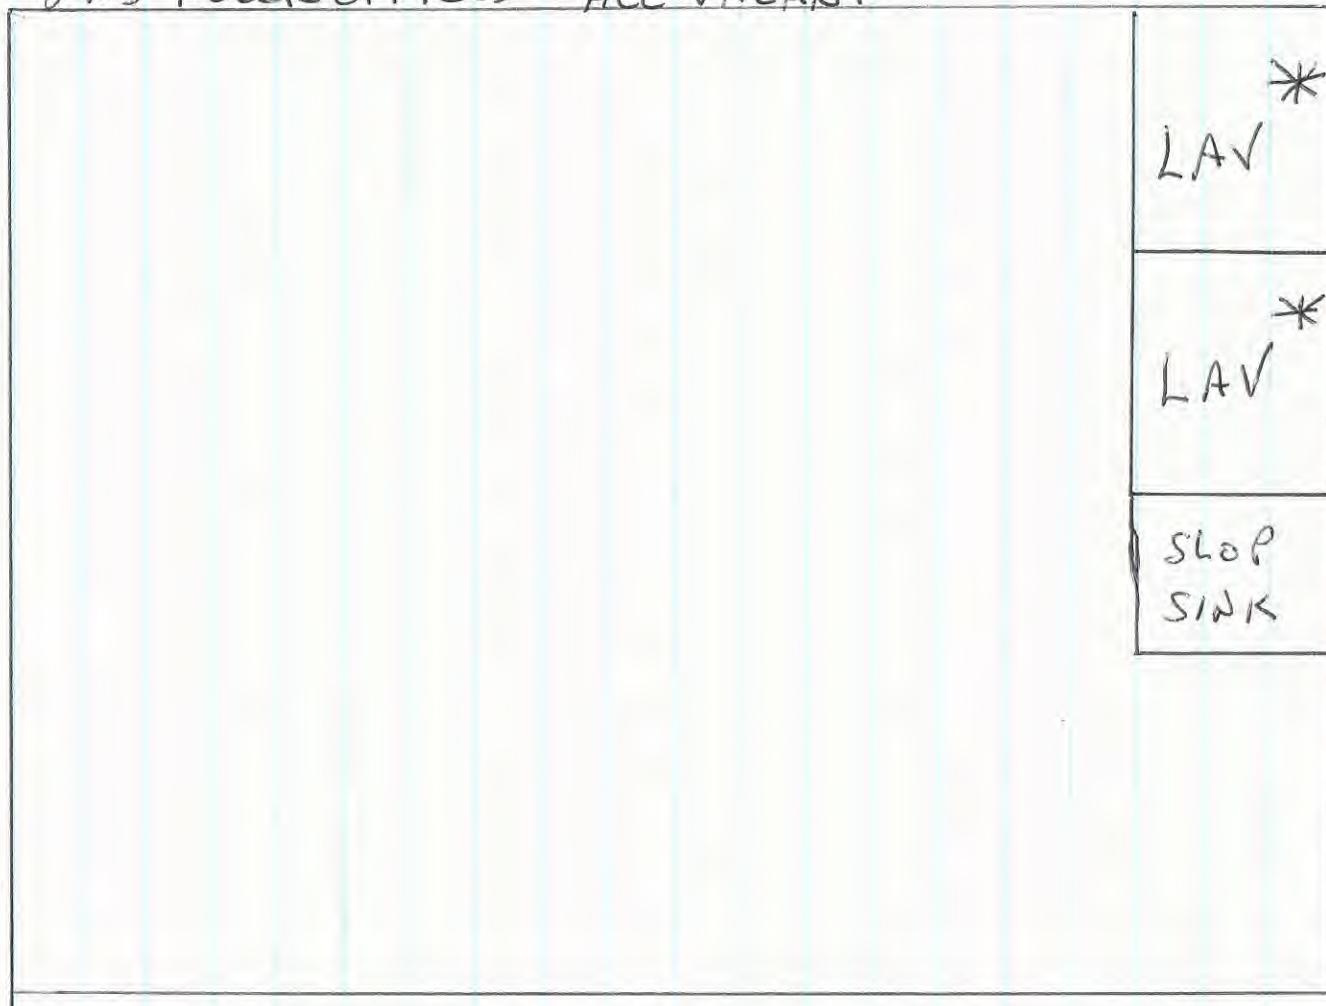

CHILLICOTHE RD. CHESTER TOWN CENTER