

FIRST FLOOR


**Lead Mapping 3-2-17
Hambden Elementary
School**

PWS ID 2853212
**Dates of Construction: 1922,
addition 1949, addition 1964**
Copper Piping


- (R) Restroom
- (K) Kitchen
- (SS) Sample Site
- (S) Sink
- (DF) Drinking Fountain

CHARDON LOCAL SCHOOLS
HAMBDEN ELEMENTARY
13871 G.A.R. Highway
CHARDON OHIO 44024
FIRST FLOOR
Ohio Facility Construction Commission

IRN	014060
Building telephone number	440-286-7503
Emergency Telephone Number	440-856-6274

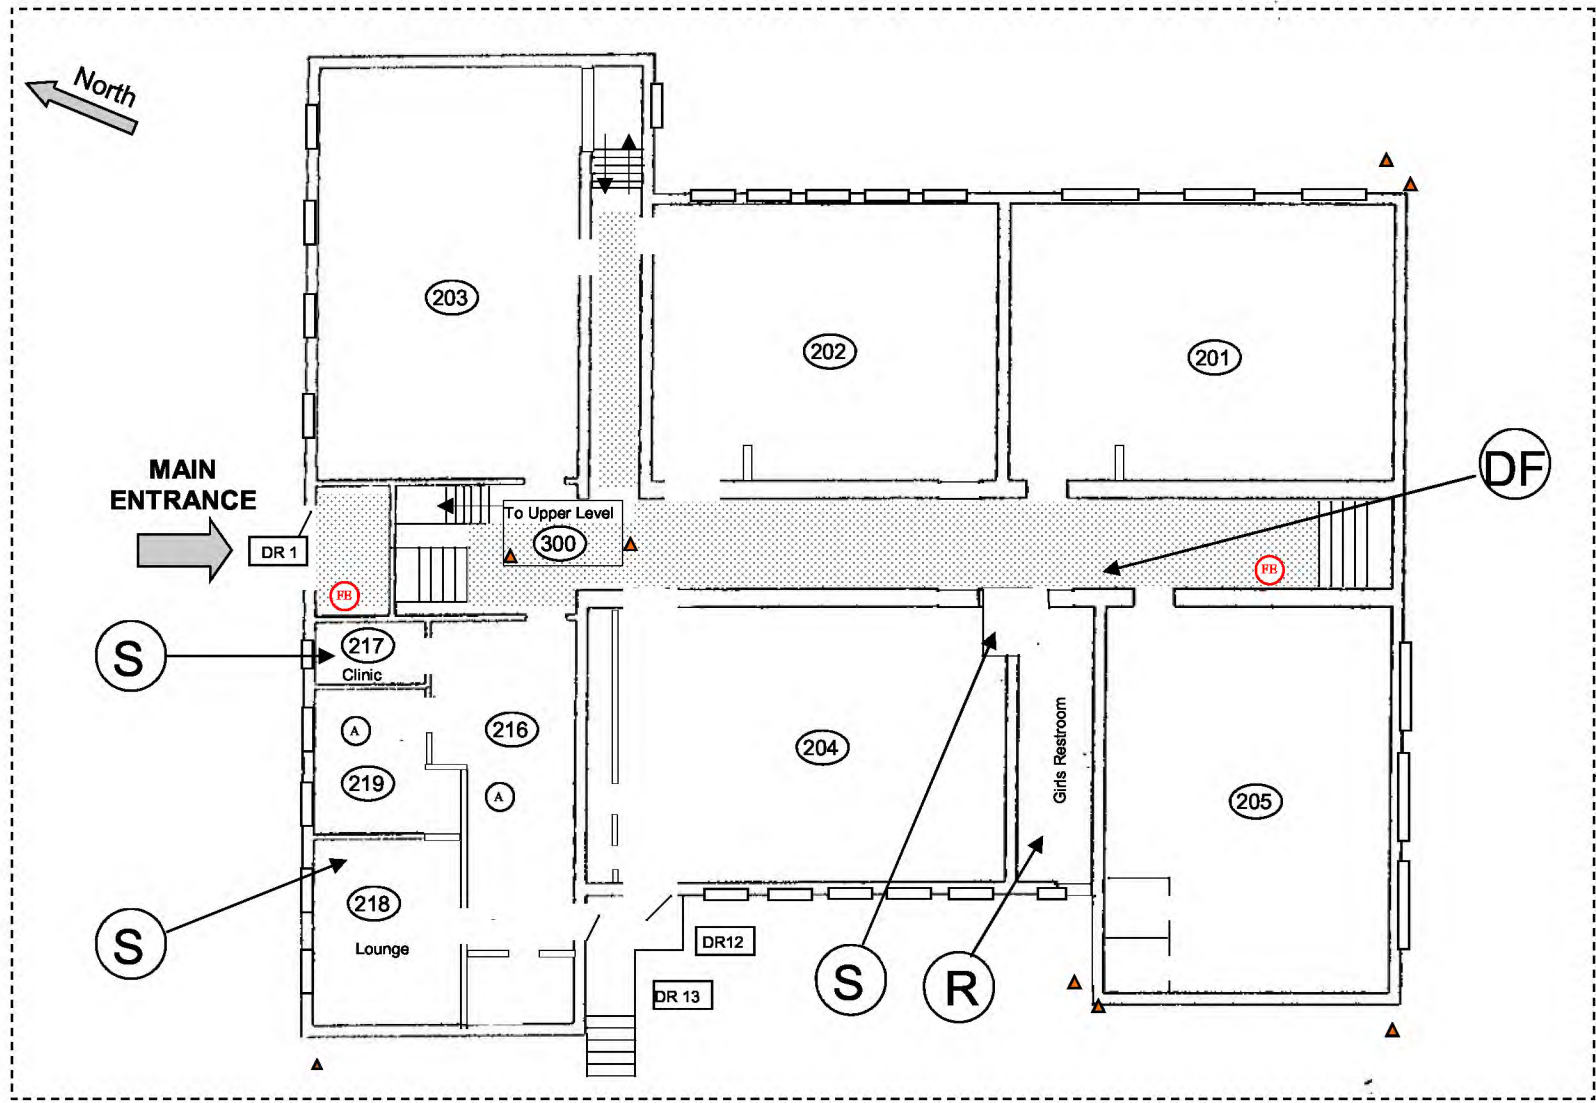

**MAIN
ENTRANCE**

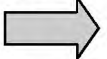

DR 1

To Upper Level
300

(S)

217
Clinic

(A)

216

219

(A)

218
Lounge

(S)

DR12

DR 13

204

(S)

(R)

Girls Restroom

205

(DF)

1922

Entrance Drive
At
G.A.R Highway



SECOND FLOOR

**Lead Mapping 3-2-17
Hambden Elementary
School**

PWS ID 2853212
Dates of Construction: 1922,
addition 1949, addition 1964
Copper Piping

- (R) Restroom
- (K) Kitchen
- (SS) Sample Site
- (S) Sink
- (DF) Drinking Fountain

CHARDON LOCAL SCHOOLS
HAMB DEN ELEMENTARY
13871 G.A.R. Highway
CHARDON OHIO 44024
SECOND FLOOR
Ohio Facility Construction Commission

IRN	014060
Building telephone number	440-286-7503
Emergency Telephone Number	440-856-6274