



**LICENSE TO OPERATE OR MAINTAIN
A PUBLIC WATER SYSTEM**

THE OHIO EPA, PURSUANT TO SECTION 6109.21 OF THE OHIO REVISED CODE, HEREBY ISSUES THIS
LICENSE TO OPERATE OR MAINTAIN A PUBLIC WATER SYSTEM TO

**HOLDEN ARBORETUM
PWS ID: OH4337419**

THE LICENSEE IS OBLIGATED TO ENSURE THAT THE PUBLIC WATER SYSTEM IS OPERATED AND
MAINTAINED IN ACCORDANCE WITH THE REQUIREMENTS OF CHAPTER 6109 OF THE OHIO REVISED
CODE, ALL OTHER APPLICABLE STATUTES AND THE ADMINISTRATIVE RULES ADOPTED THEREUNDER.

THIS LICENSE WILL EXPIRE ON JANUARY 30, 2018

APPLICATION FOR RENEWAL IS REQUIRED TO BE SUBMITTED TO THE OHIO EPA AT LEAST THIRTY
DAYS PRIOR TO THIS DATE.


EFFECTIVE DATE: **JANUARY 1, 2017**

EXPIRATION DATE: **JANUARY 30, 2018**

LICENSE NUMBER: **4337419-1114860-2017**

A handwritten signature in dark ink, reading "Craig W. Butler", is positioned above a horizontal line. The signature is written in a cursive, flowing style.

Craig W. Butler, Director

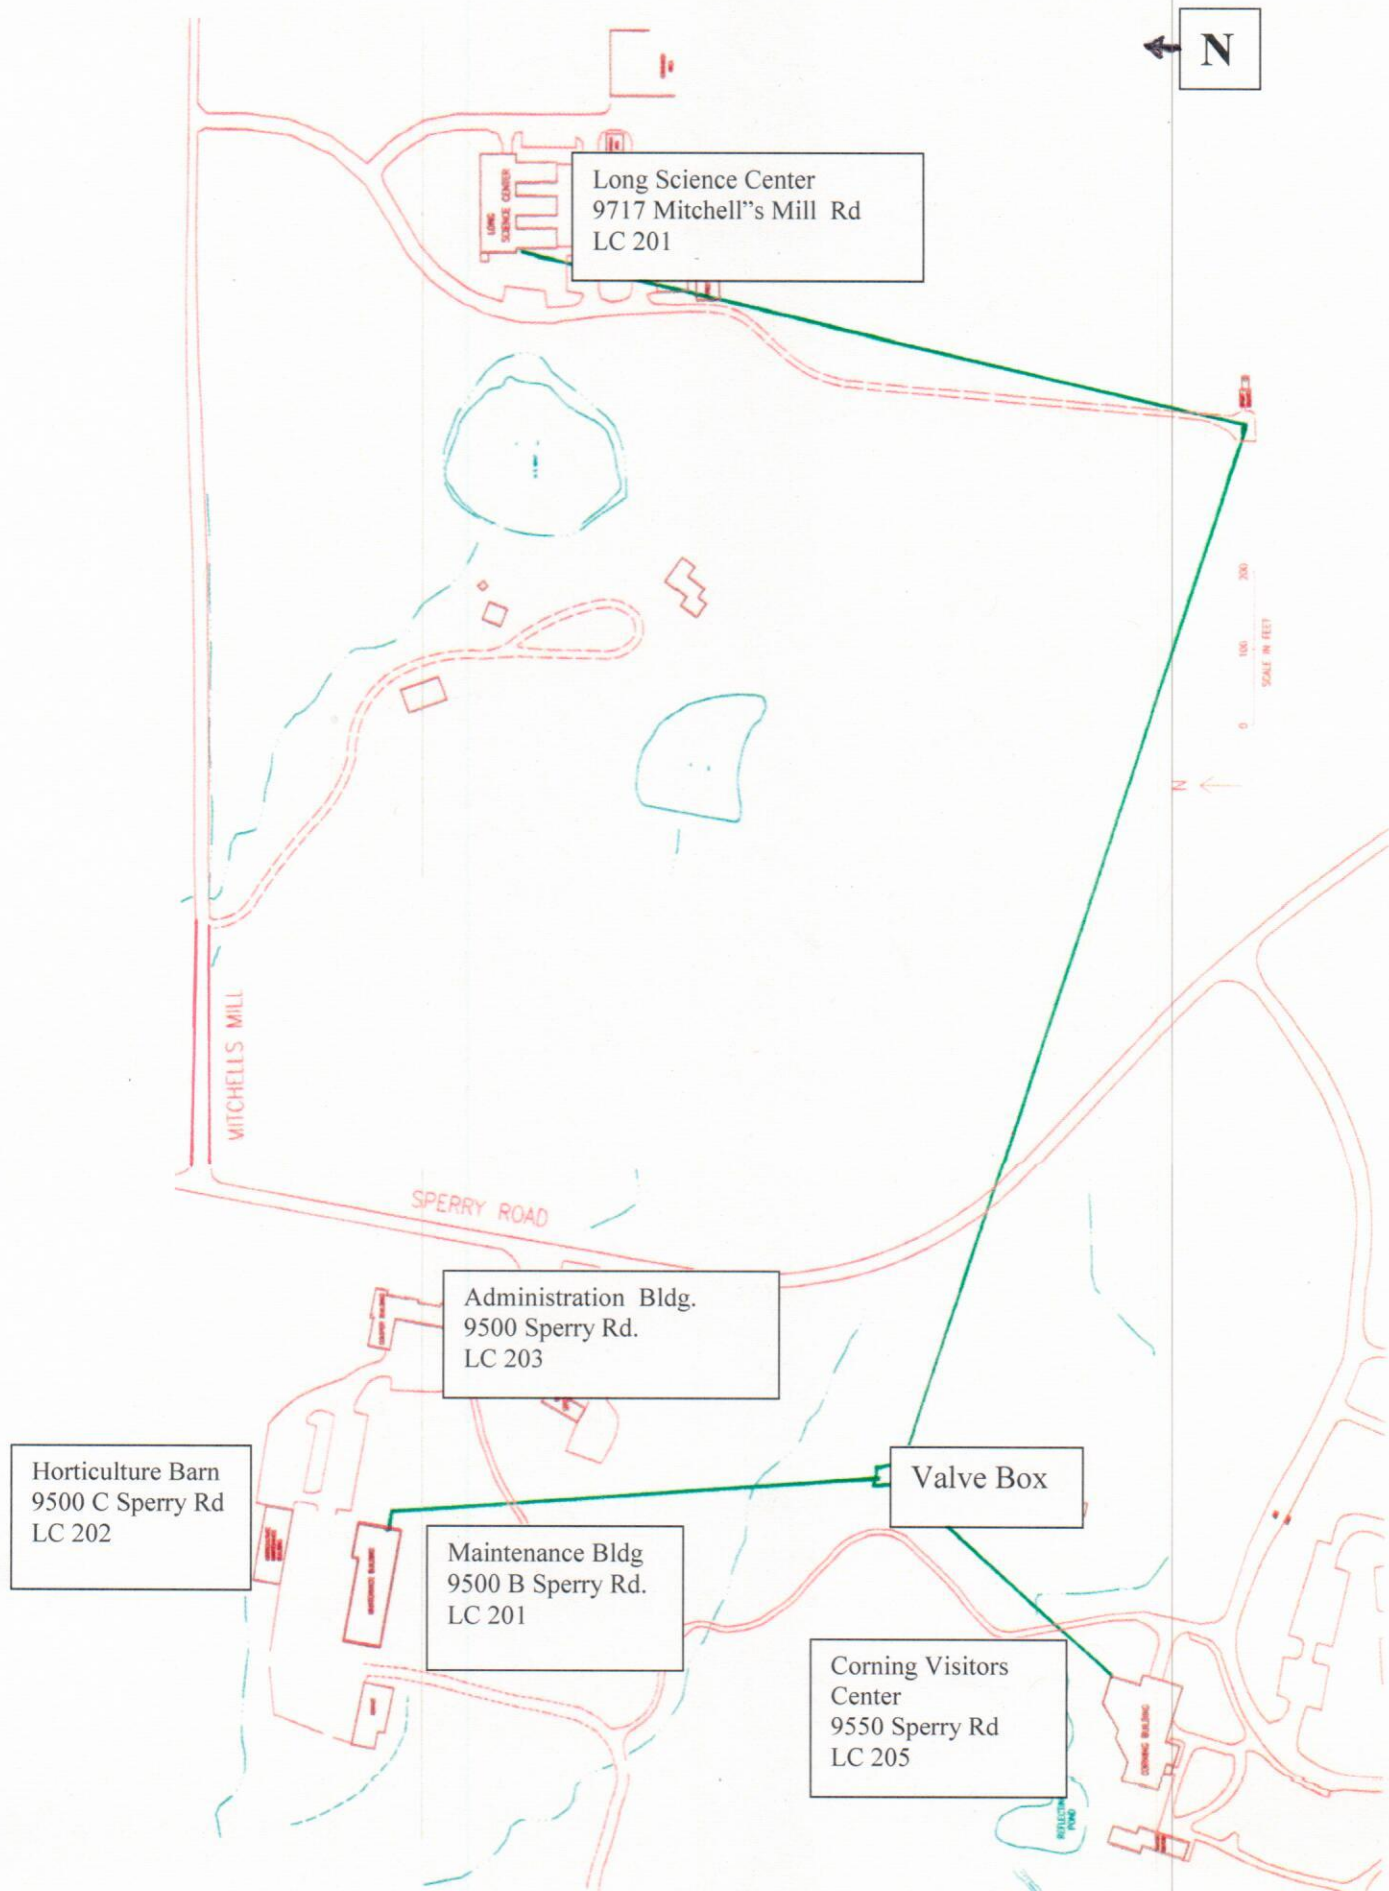

The Holden Arboretum – Water Distribution Map


9500 B Sperry Rd. Kirtland, Ohio SMP #1



Imagery ©2017 Google, Map data ©2017 Google 10 ft

Holden Maintenance/Horticon Building. 9500 B Sperry Rd, Kirtland, Ohio 44094 LC 201
Constructed 2012. Function: Equipment/Building Maintenance. Horticulture Offices, Conservation Offices
Plumbing Fixtures. Urinals, Toilets, Lunchroom Sink, Slop Sinks, Janitor Station

Holden Maintenance/Horticon Building. 9500 Sperry Rd. Kirtland, Ohio SMP #1

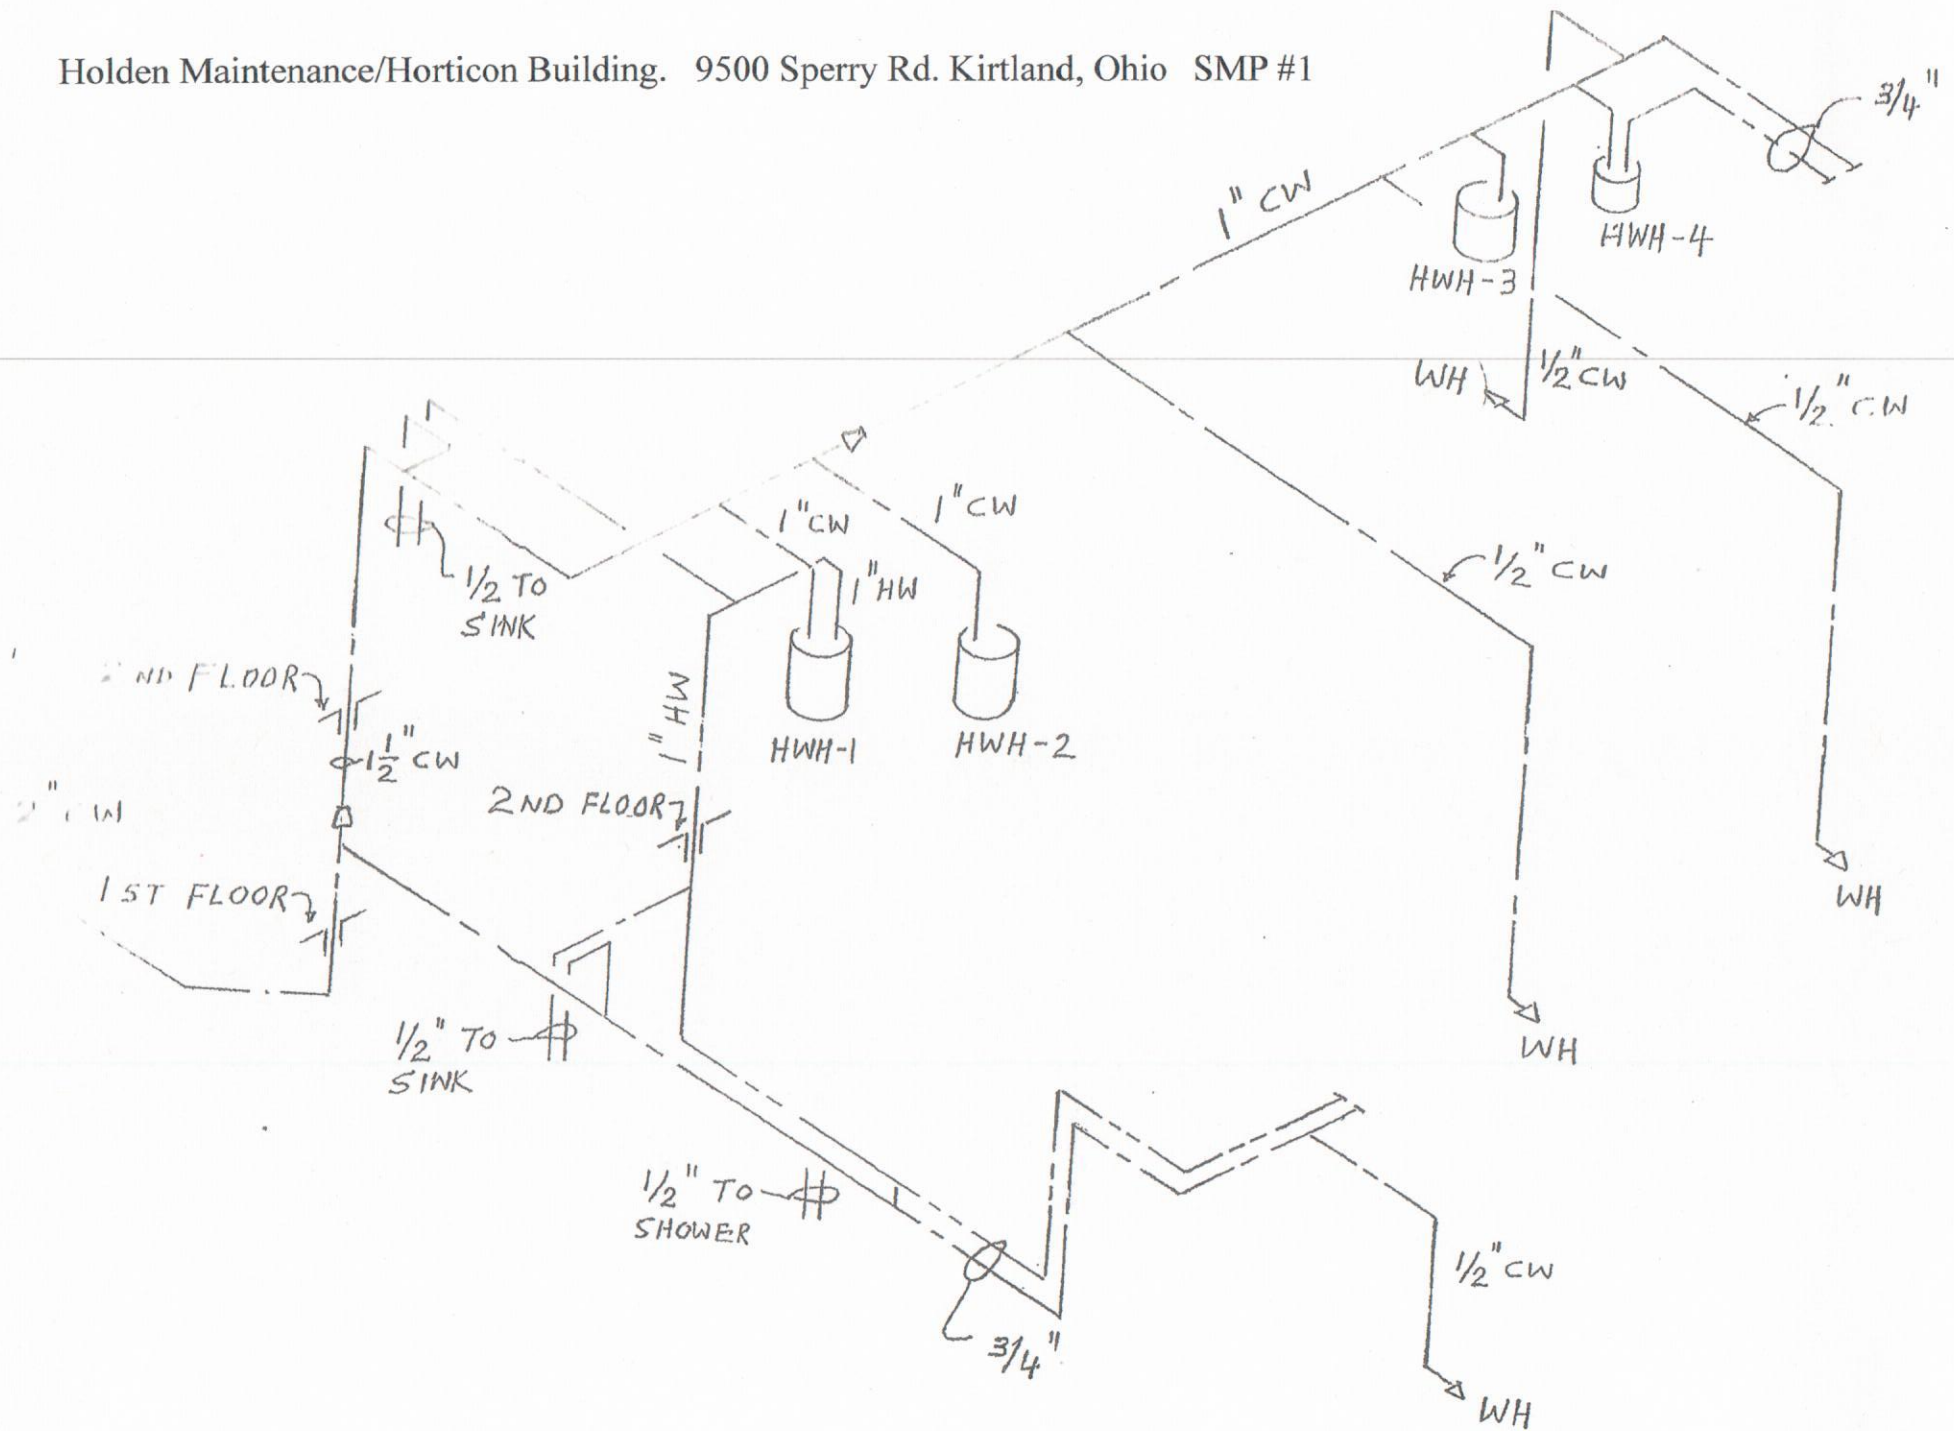


9500 C Horticulture Barn SMP #2




Imagery ©2017 Google, Map data ©2017 Google 10 ft

Horticulture Barn. 9500 C Sperry Rd. Kirtland, Ohio 44094 **LC 202**
Constructed 1980. Function: Small equipment repair. Storage
Plumbing Fixtures. Urinals, Toilets, Slop Sink. Janitor Station

Horticulture Barn. 9500C Sperry Rd. Kirtland, Ohio SMP # 2

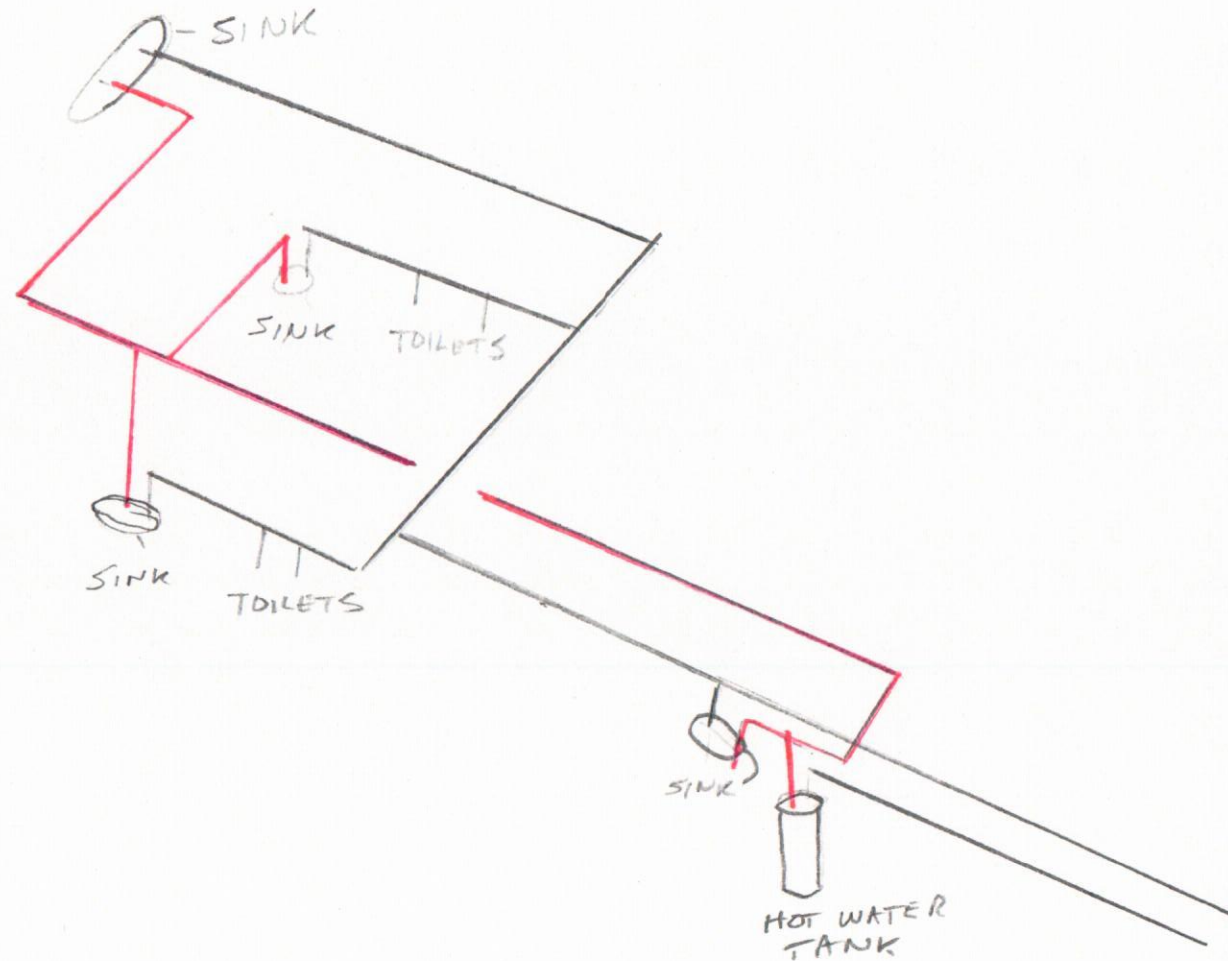

9500 Sperry Rd. Kirtland, Ohio SMP #3

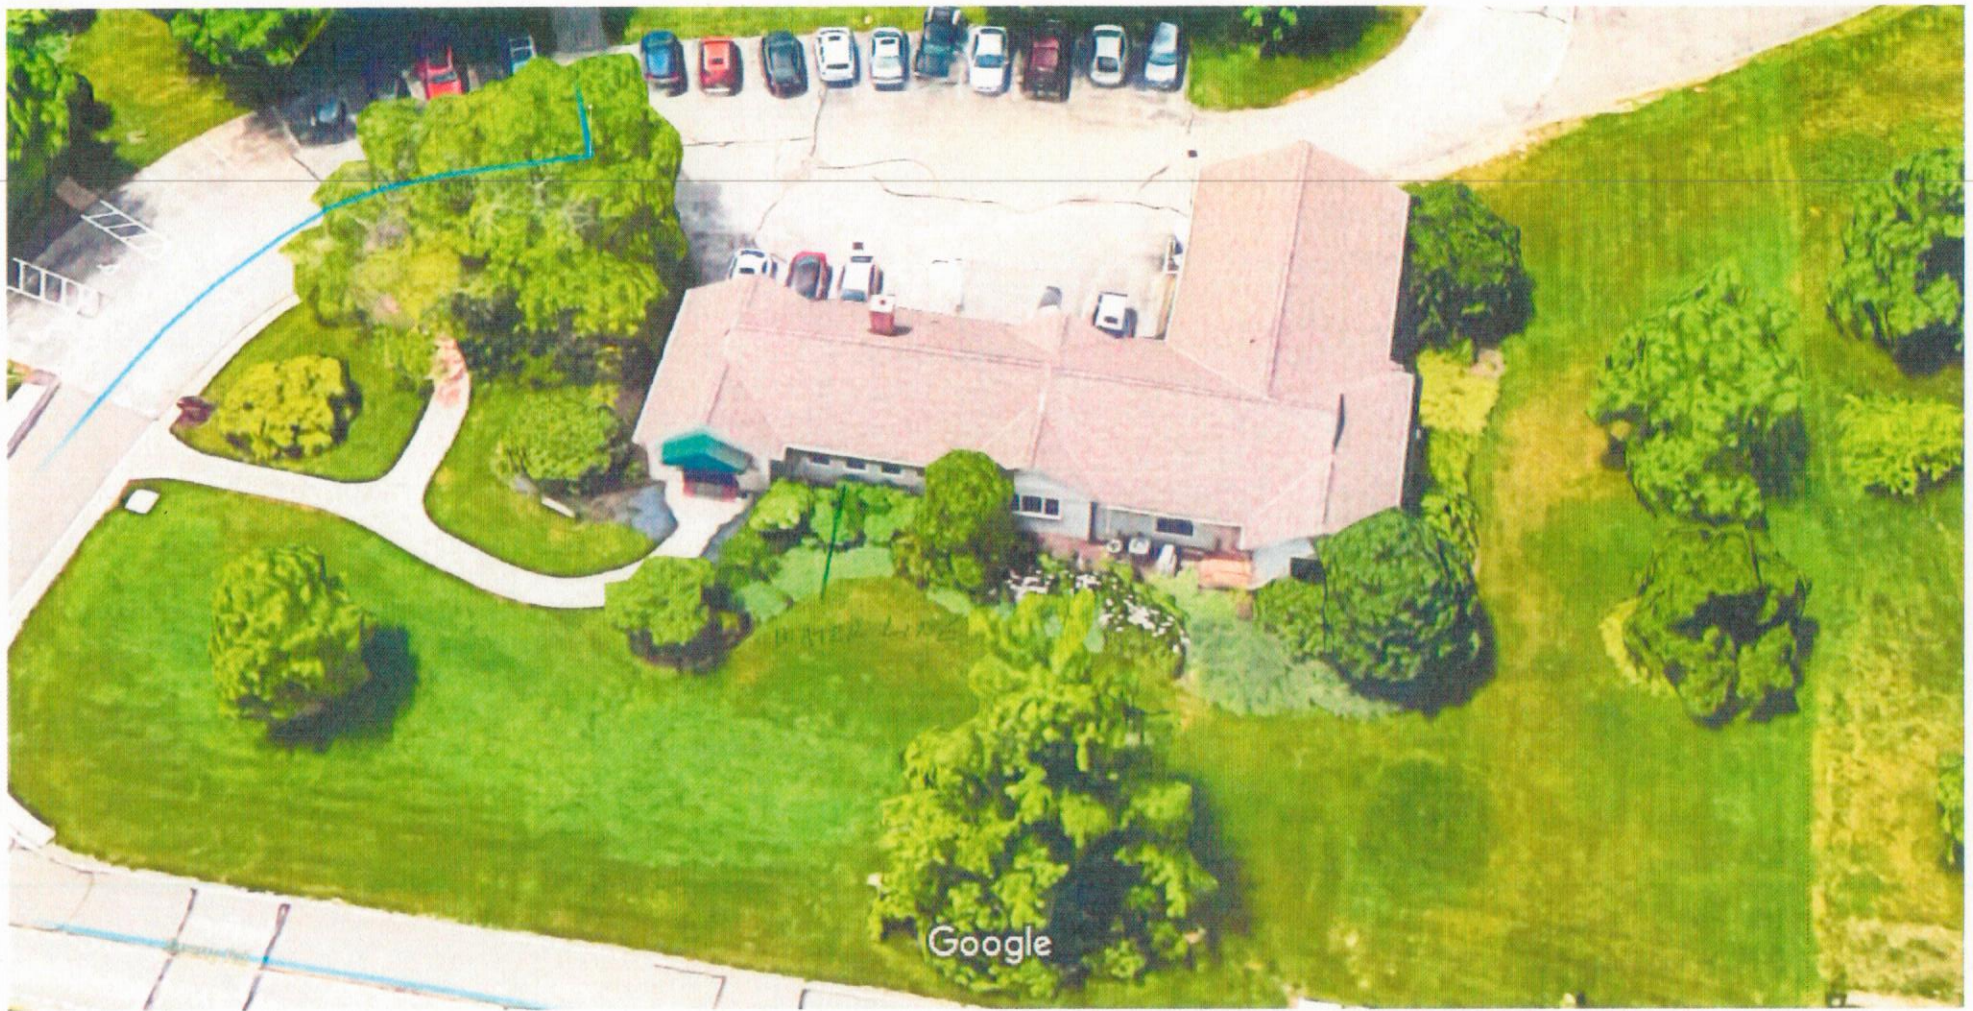

Imagery ©2017 Google, Map data ©2017 Google 10 ft

Cooper Administration Building. 9500 Sperry Rd. Kirtland, Ohio 44094 LC 203
Constructed 1953. Function: Administrative Office Building
Plumbing Fixtures: Toilets, Lunchroom Sink, Janitor Station

9717 Mitchell's Mills Rd. Chardon Township, Ohio SMP # 4



Imagery ©2017 Google, Map data ©2017 Google 10 ft

Long Science Center, 9717 Mitchell's Mill Rd. Chardon Township LC 204
Constructed 1994. Function: Plant and Tree Research, Nursery/Greenhouse
Plumbing Fixtures: Urinals, Toilets, Showers, Lab Sinks, Lunch Room Sink, Janitor Station.

9550 Sperry Rd. Kirtland, Ohio SMP # 5



Imagery ©2017 Google, Map data ©2017 Google 10 ft

Corning Visitor Center. 9550 Sperry Rd. Kirtland, Ohio 44094. **LC 205**
Constructed 1980. Function: Meeting Rooms, Retail space, Library
Plumbing Fixtures: Urinals, Toilets Bathroom Sinks, Food Prep Sink, Janitor Station

Corning Visitor Center. 9559 Sperry Rd. Kirtland, Ohio SMP # 5

