
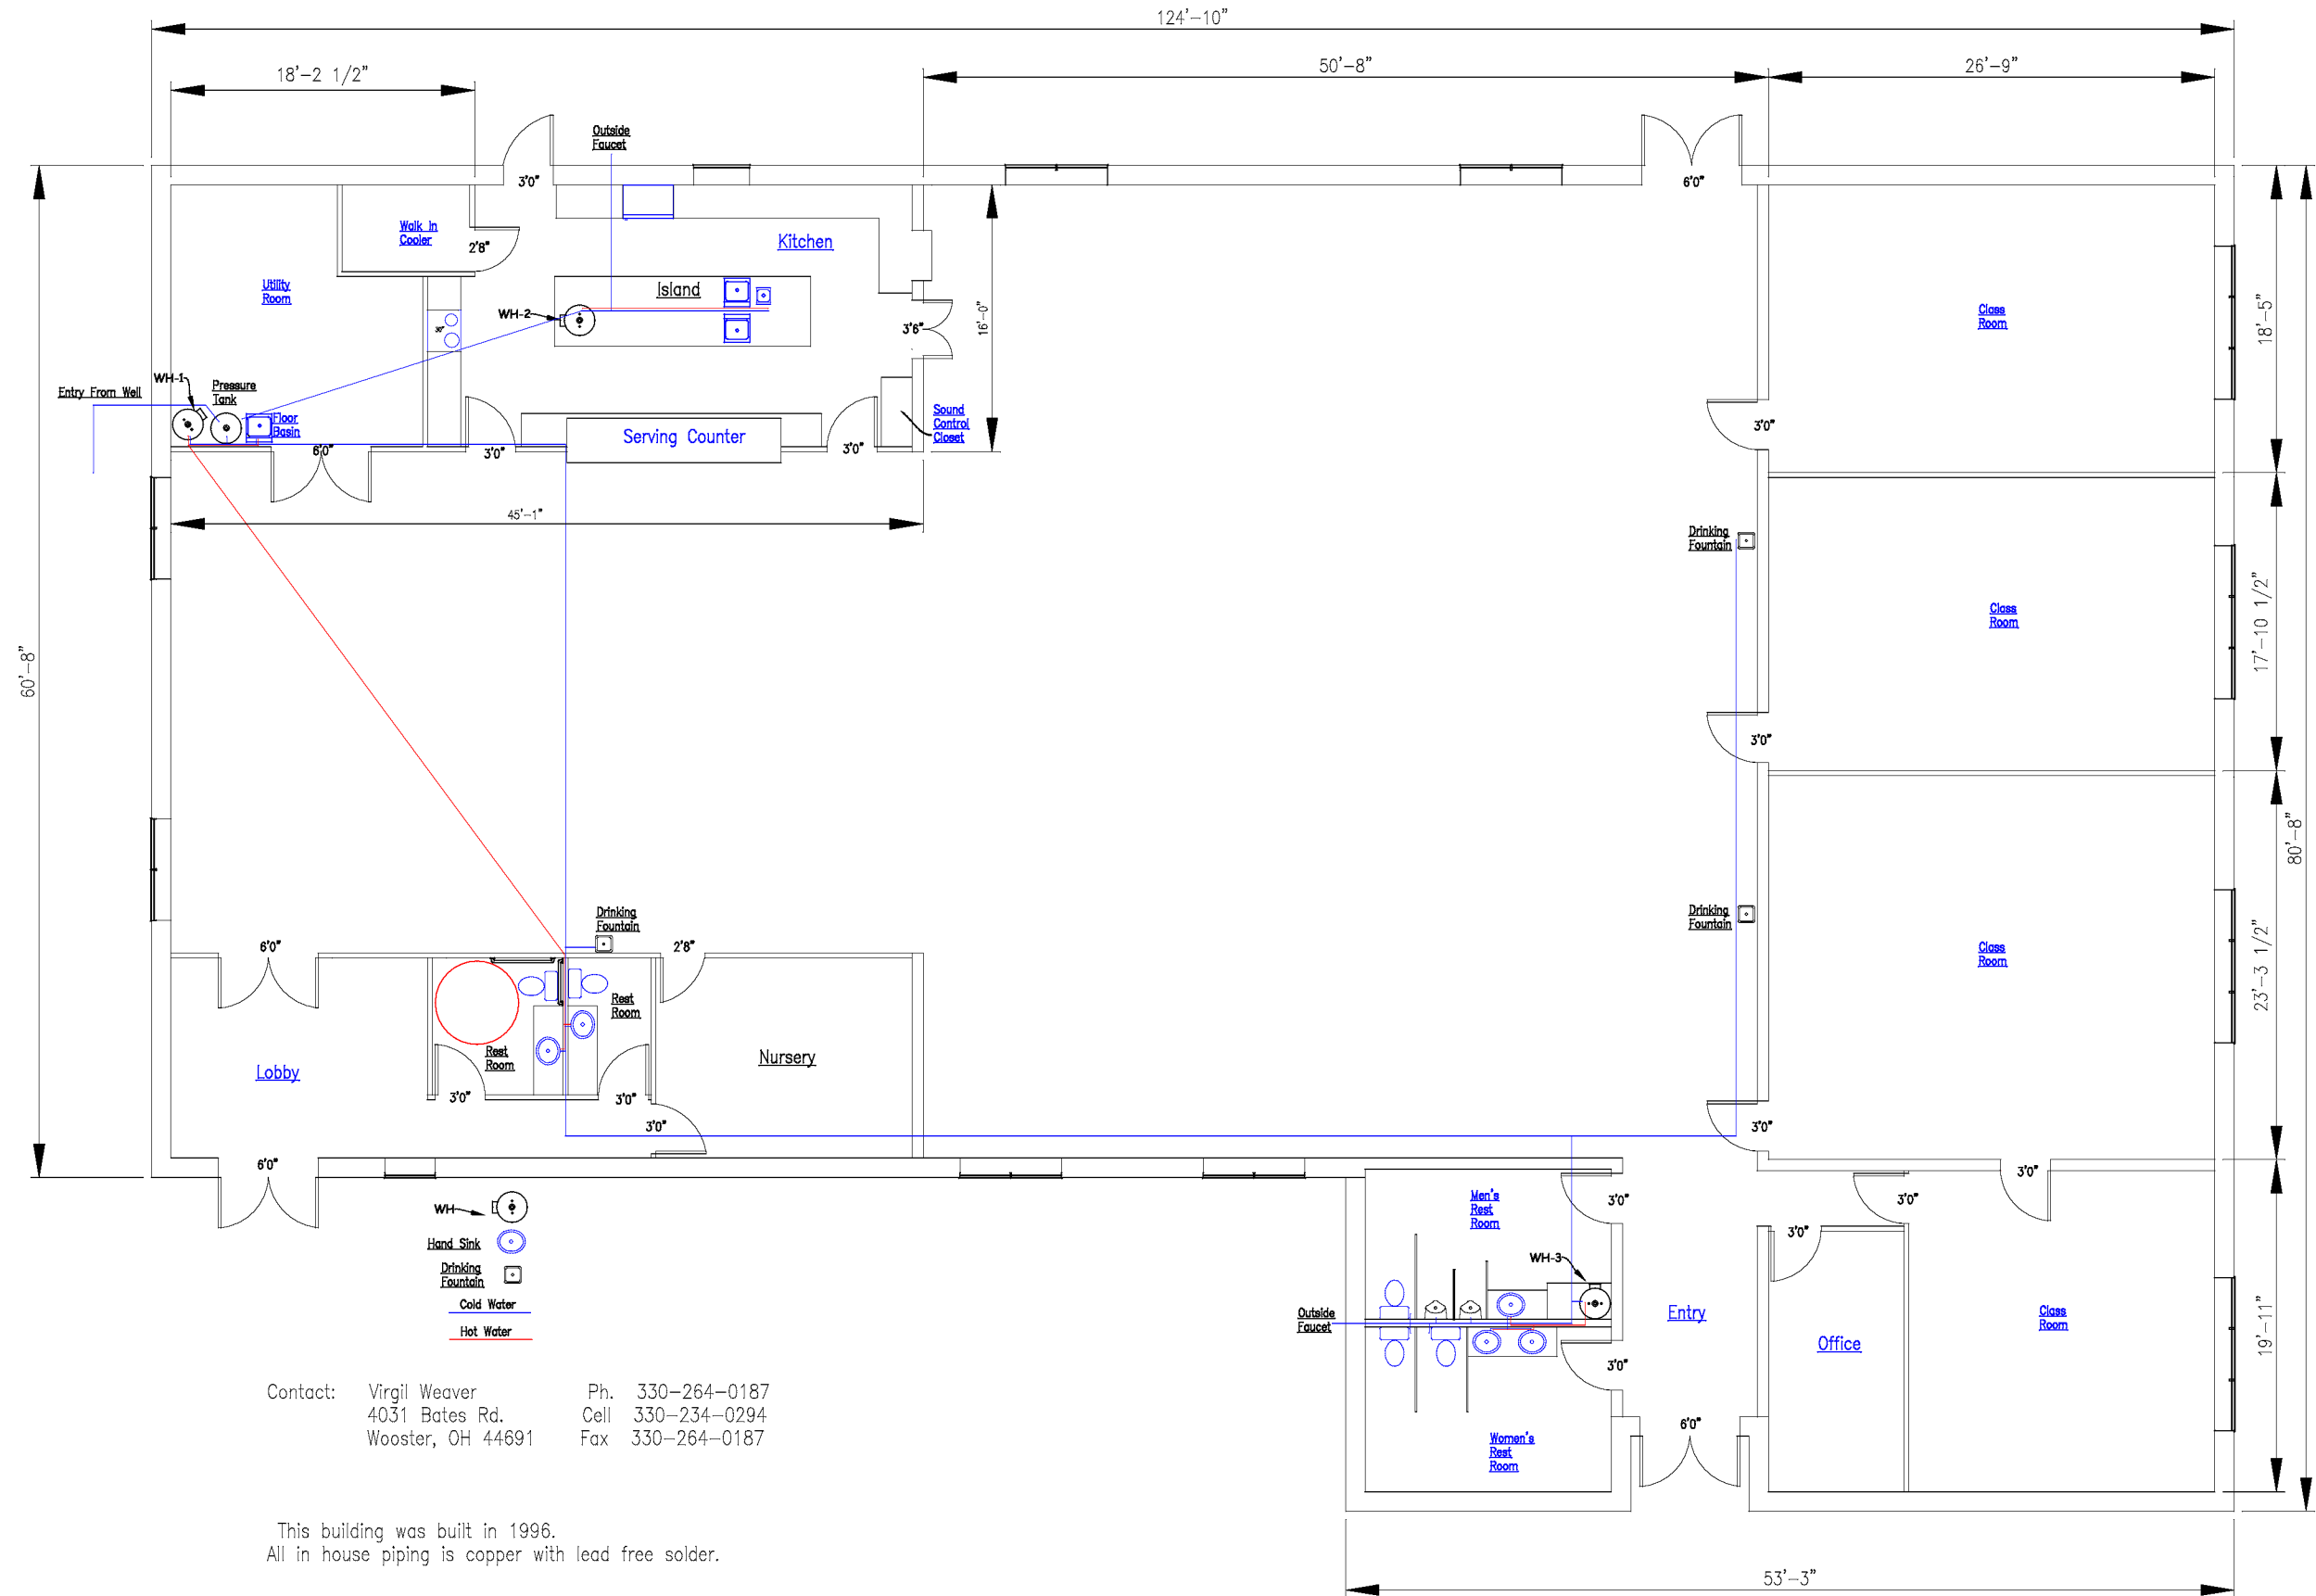


To Ohio Environmental Protection Agency
Division of Drinking and Ground Water

The following Four Pages are concerning the Mapping Lead Plumbing from the Pine View Christian School, and the Chester Mennonite Church, which the School Well supplies Water to.

Drawn by: WLH
Date: 2/23/17
Water Line Routing Plan 11x17
Scale: 3/32" = 1'



Pine View Christian School
4730 Rutt Rd.
Wooster, OH 44691

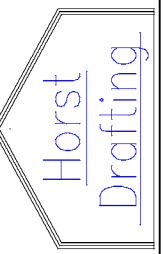

Contact: Virgil Weaver Ph. 330-264-0187
4031 Bates Rd. Cell 330-234-0294
Wooster, OH 44691 Fax 330-264-0187

This building was built in 1996.
All in house piping is copper with lead free solder.

EET

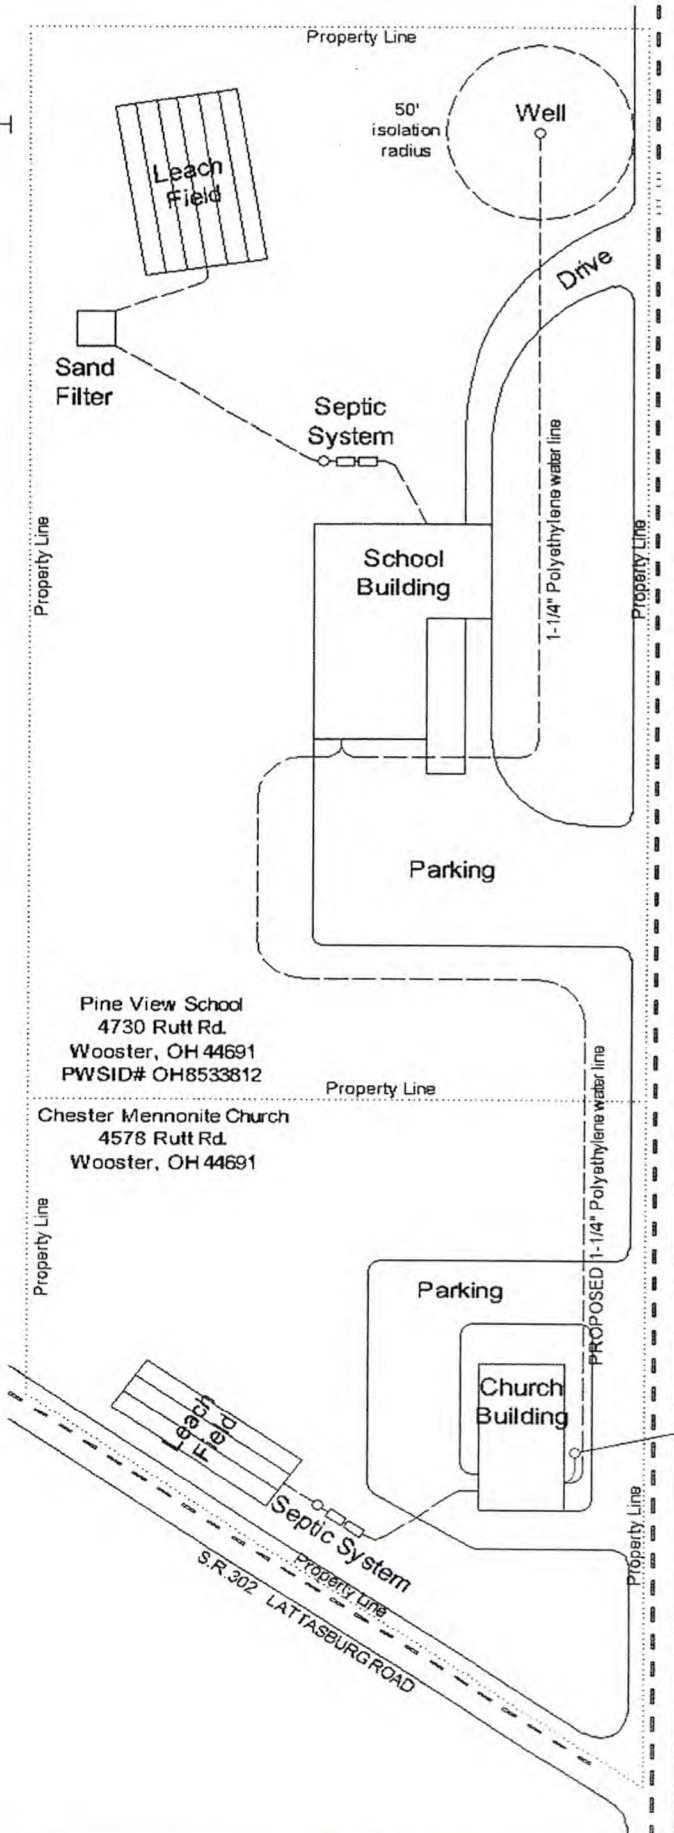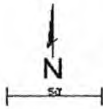

Pine View School
 4730 Rutts Rd.
 Wooster, OH 44691
 PWSID# OH8533812

Chester Mennonite Church
 4578 Rutts Rd.
 Wooster, OH 44691


XXXXXXXXXXXXXXXXXXXXXXXXXXXX
 X WATER SUPPLY X
 X APPROVED X
 X OHIO ENVIRONMENTAL PROTECTION AGENCY X
 X AS EVIDENCED BY COPY OF X
 X LETTER OF APPROVAL X
 XXXXXXXXXXXXXXXXXXXXXXXXXXXX

RECEIVED
 NOV 09 2015
 OHIO EPA-DPAGW


SITE MAP

Contact: Virgil Weaver Ph. 330-264-0187
 4031 Bates Rd. Cell 330-234-0294
 Wooster, OH 44691 Fax 330-264-0187

This building was built in 1973.
 All water lines are copper except approx. 12" before and leaving pressure tank which are PVC.
 The solder and fixture types, and material and lead content is unknown.
 NOTE: This building no longer meets the criteria for a Public Building.

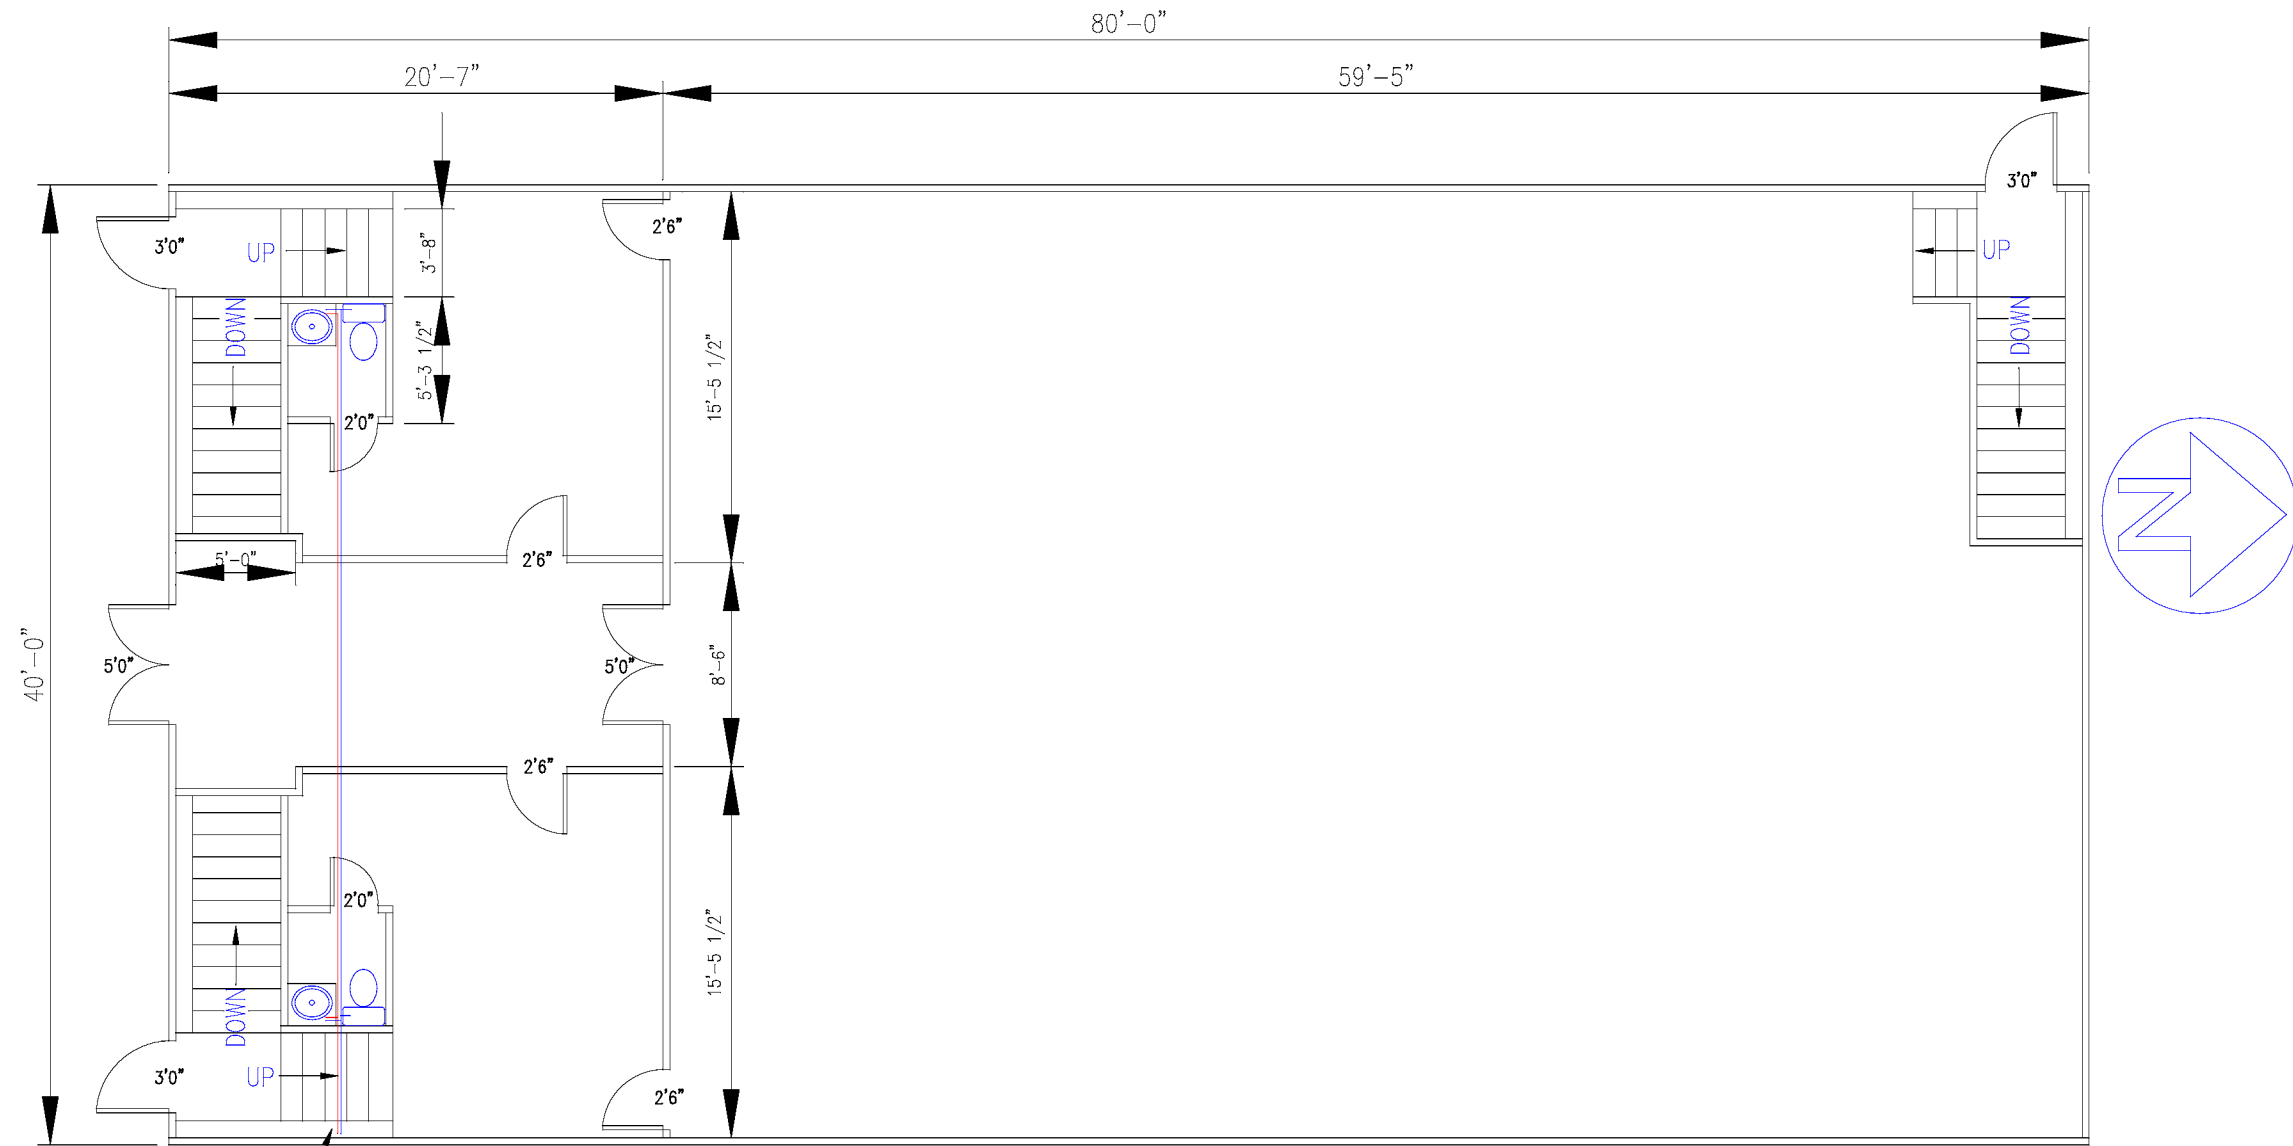


Hot And Cold Water Lines
 Come From The Basement
 At this Point

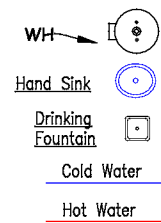

1	
Drawn by: WLH Date: 2/23/17 Water Line Routing Plan-1st Floor 11x17 Scale: 1/8" = 1'	Chester Mennonite Church 4578 Rutt Rd. Wooster, OH 44691

Contact: Virgil Weaver Ph. 330-264-0187
 4031 Bates Rd. Cell 330-234-0294
 Wooster, OH 44691 Fax 330-264-0187

This building was built in 1973.
 All water lines are copper except approx. 12" before and leaving pressure tank which are PVC.
 The solder and fixture types, and material and lead content is unknown.
 NOTE: This building no longer meets the criteria for a Public Building.

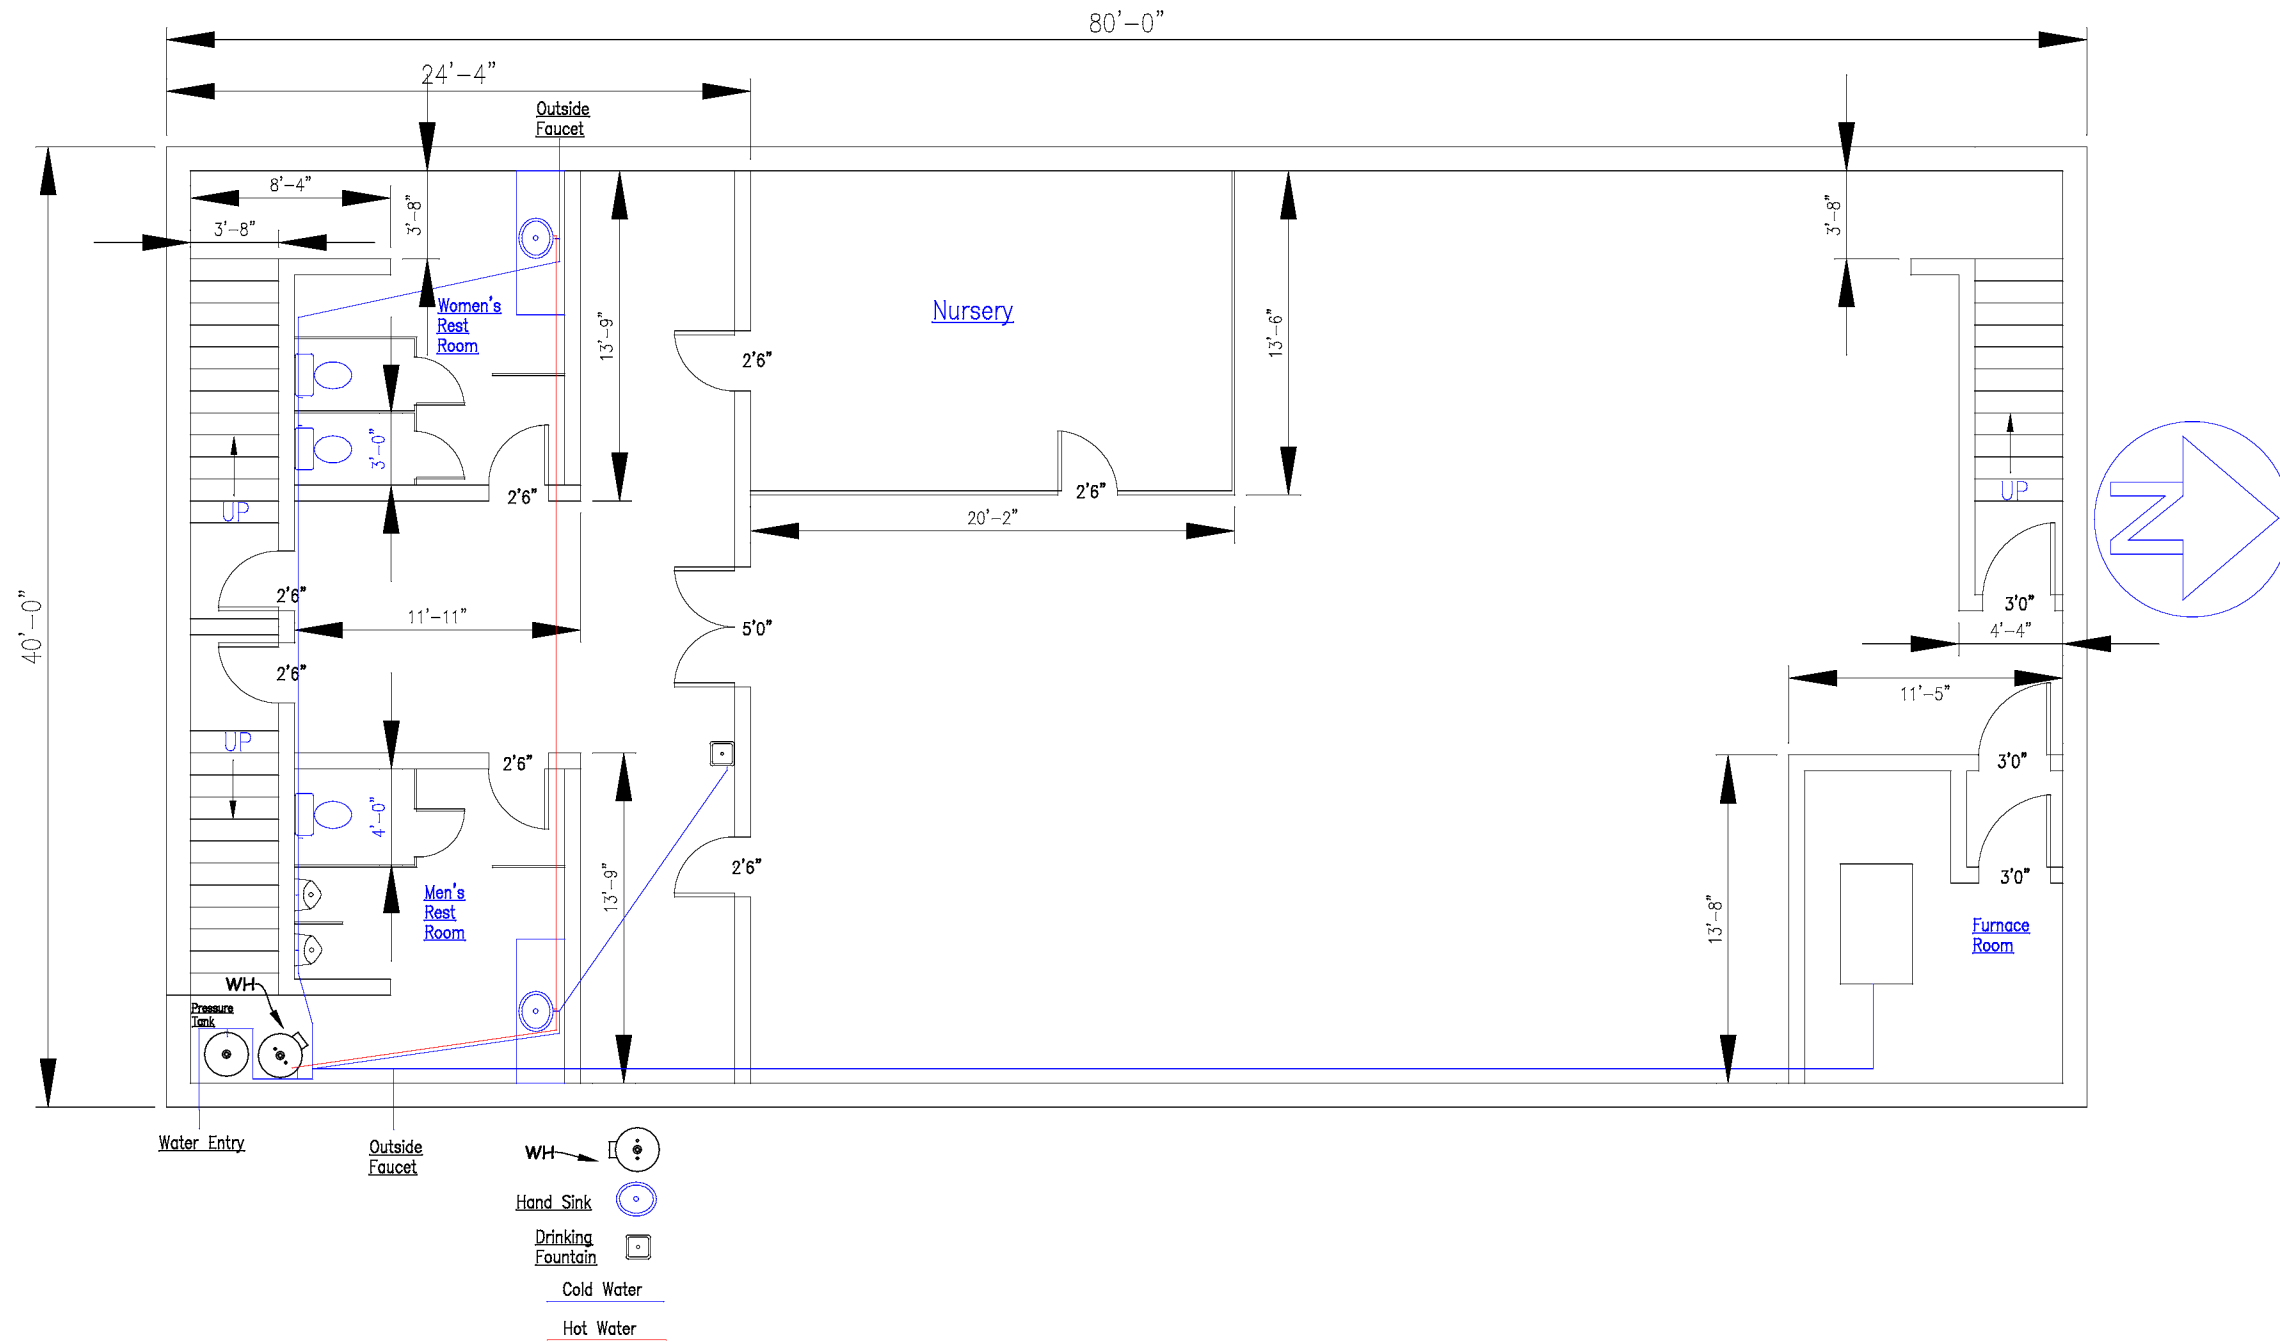

1	
Drawn by: WLH	
Date: 2/23/17	
Water Line Routing Plan-Basement 11x17	
Scale: 1/8" = 1'	
Chester Mennonite Church 4578 Rutt Rd. Wooster, OH 44691	
