


MAPPING Lead Plumbing + Fixtures

WARE House

- None Lead
 - Other -----
 - Lead
- ALL COPPER PIPING
FIXTURE MATERIAL
UNKNOWN

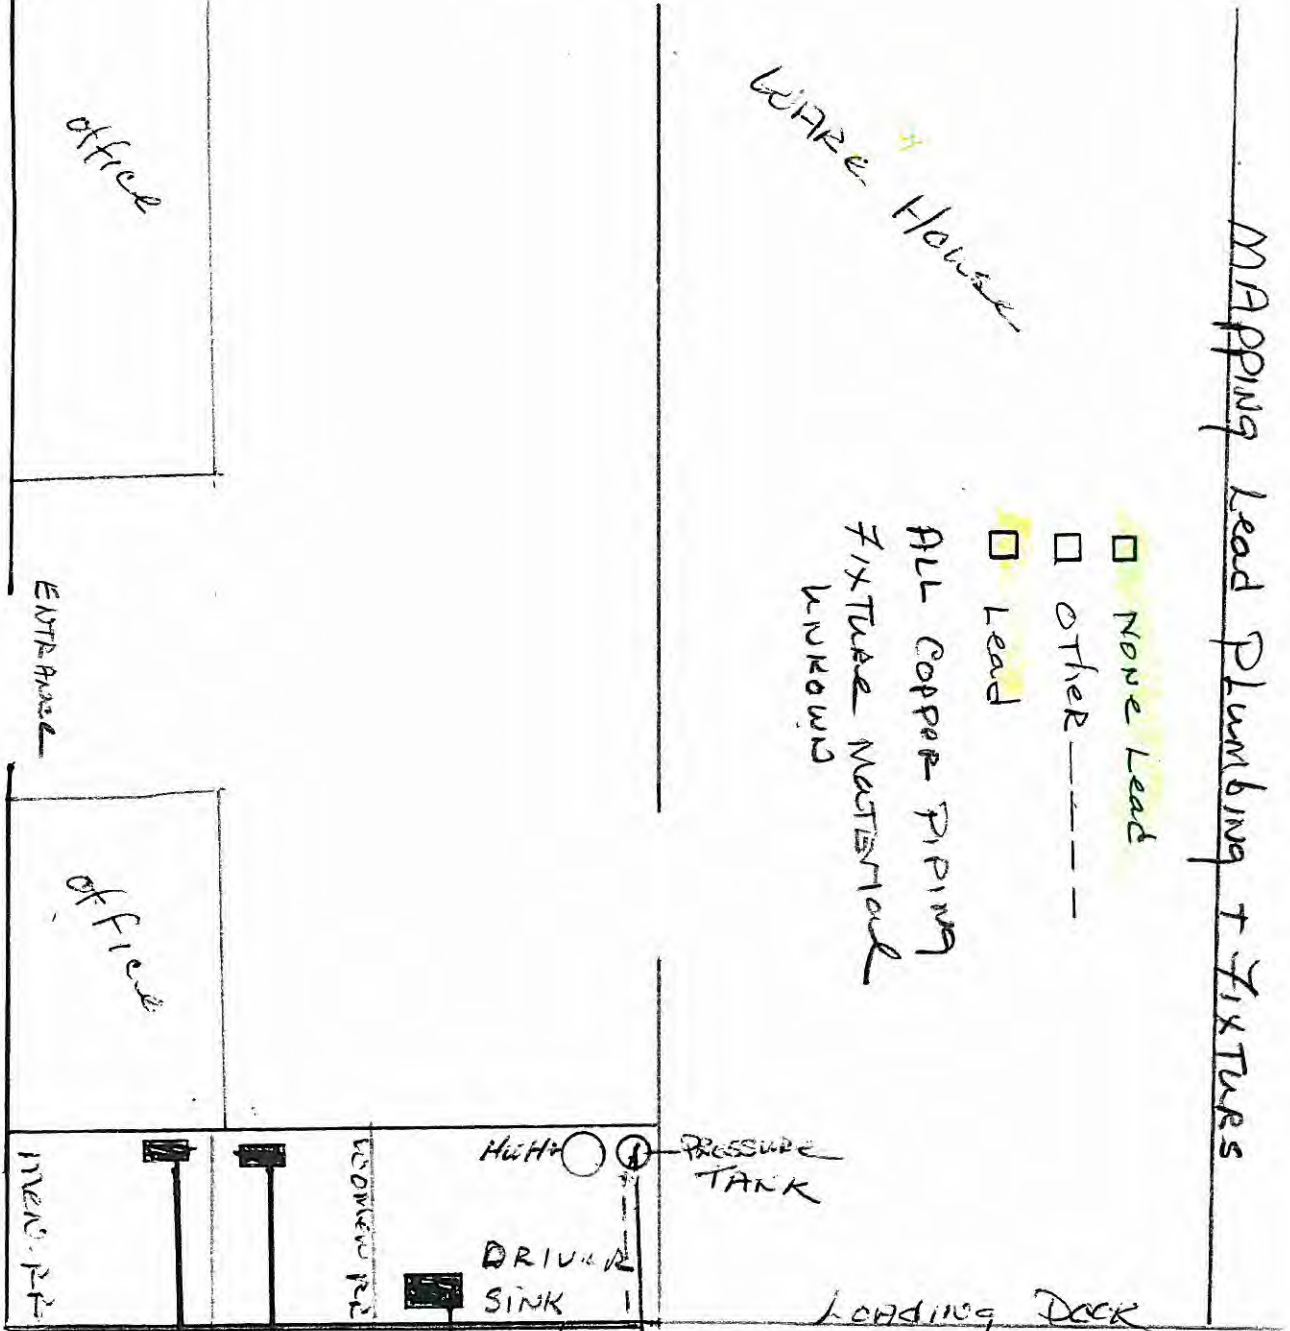

Entity: USF Holland
 Doc Type: Report
 Doc Subtype: _____
 Program: DDAW
 County: SUMMIT
 Secondary ID: OH 7787112
 EDC in color

USF HOLLAND PUS-7787112
 5140 MISSISSIPPI RD 330-6415 6100
 APOAOWD 44312

MISSISSIPPI ROAD

