
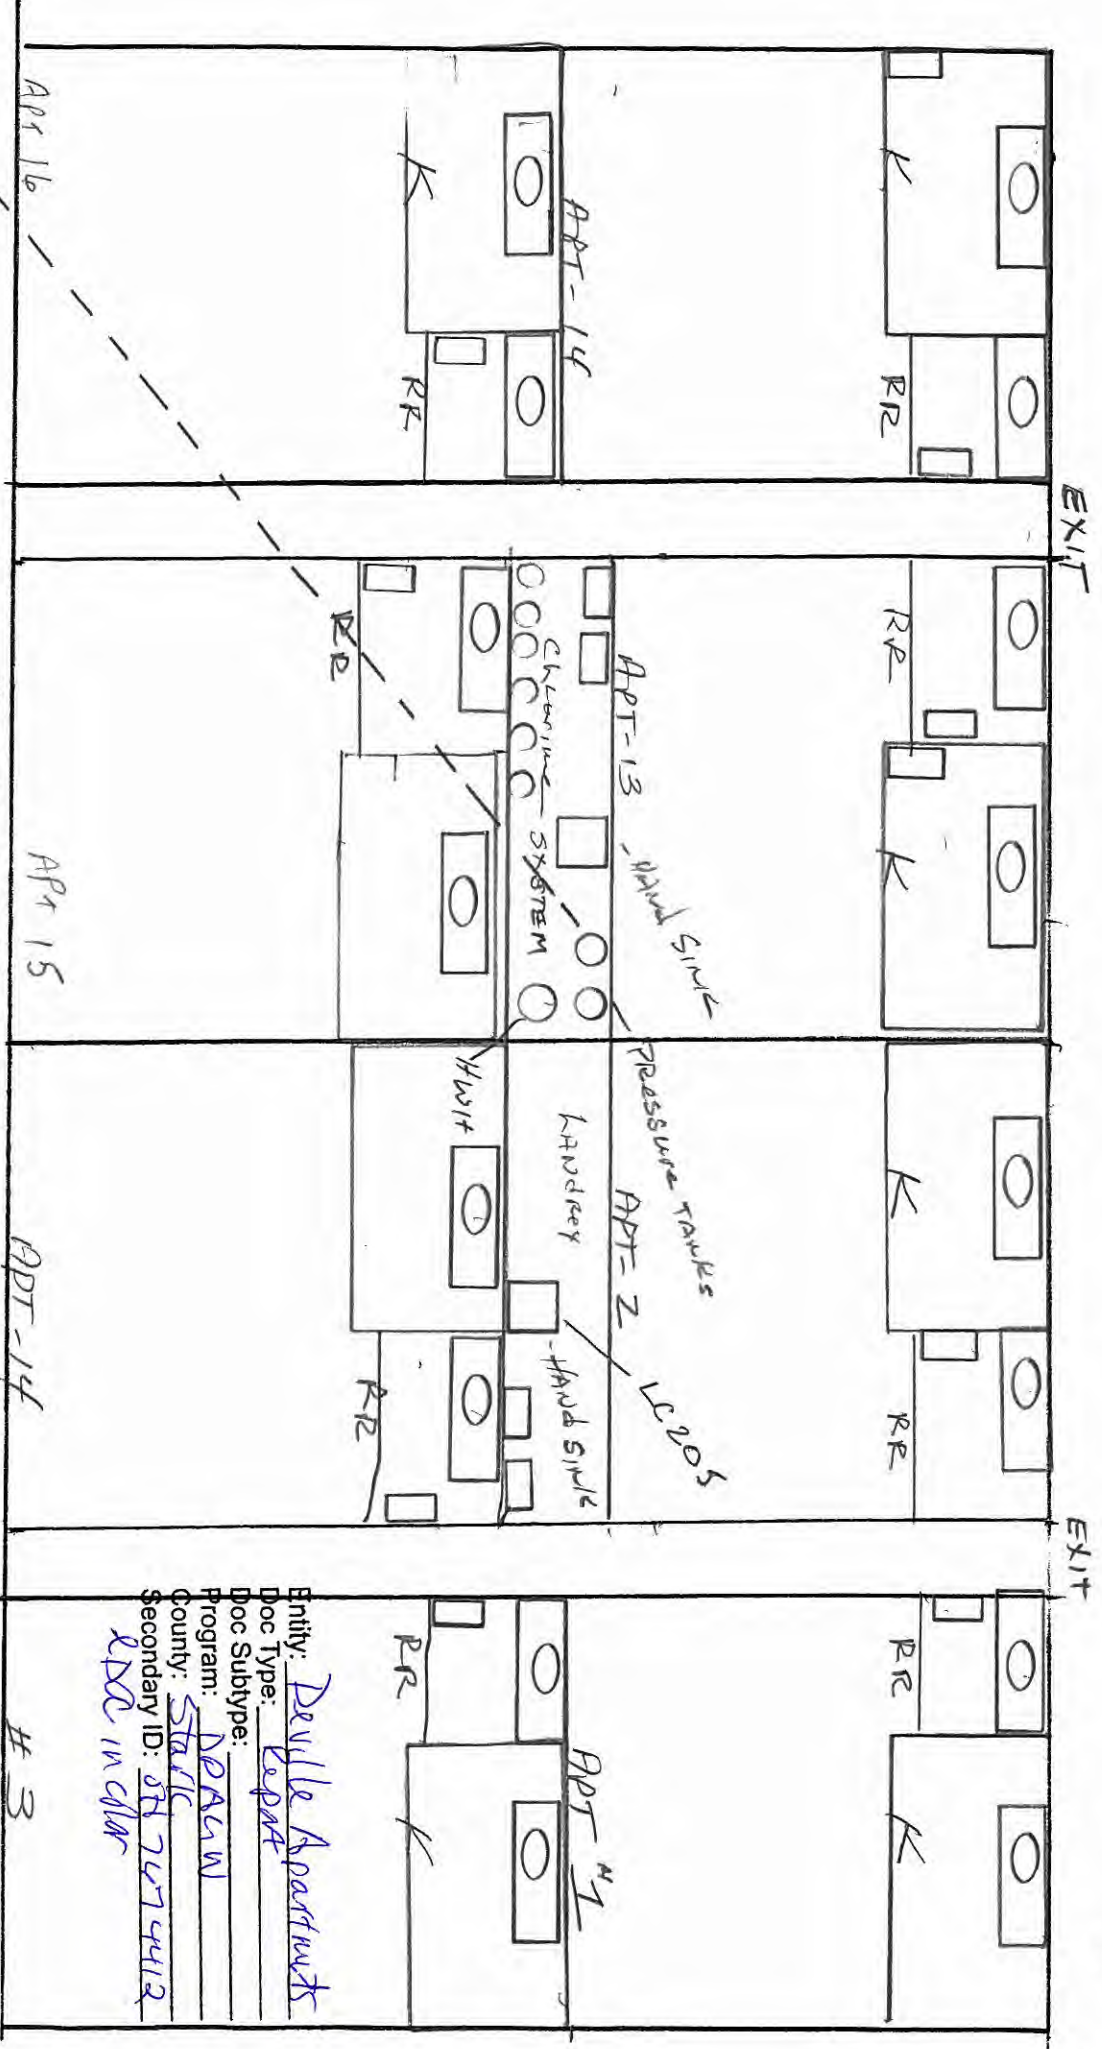


- None Lead
- Other -----
- Lead

MAPPING Lead Plumbing + Fixture

COPPER PIPING-FIXTURE MATERIAL UNKNOWN

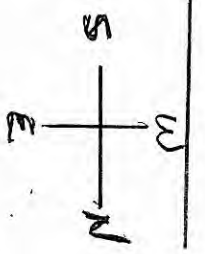

WATER WELL

DEVILLE APARTMENTS
 4200 MIDDLEBEND AVE. NE
 CANTON OH 44705
 330-492-0629 04767412

FIRST FLOOR

Entity: Deville Apartments
 Doc Type: Report
 Doc Subtype:
 Program: DPACW
 County: Stark
 Secondary ID: 04767412
RDR in color



#3

N

- NONE Lead
- ▣ Other -----
- Lead

Mapping Lead Plumbing + Fixture

Copper PIPING-FIXTURE MATERIAL UNKNOWN

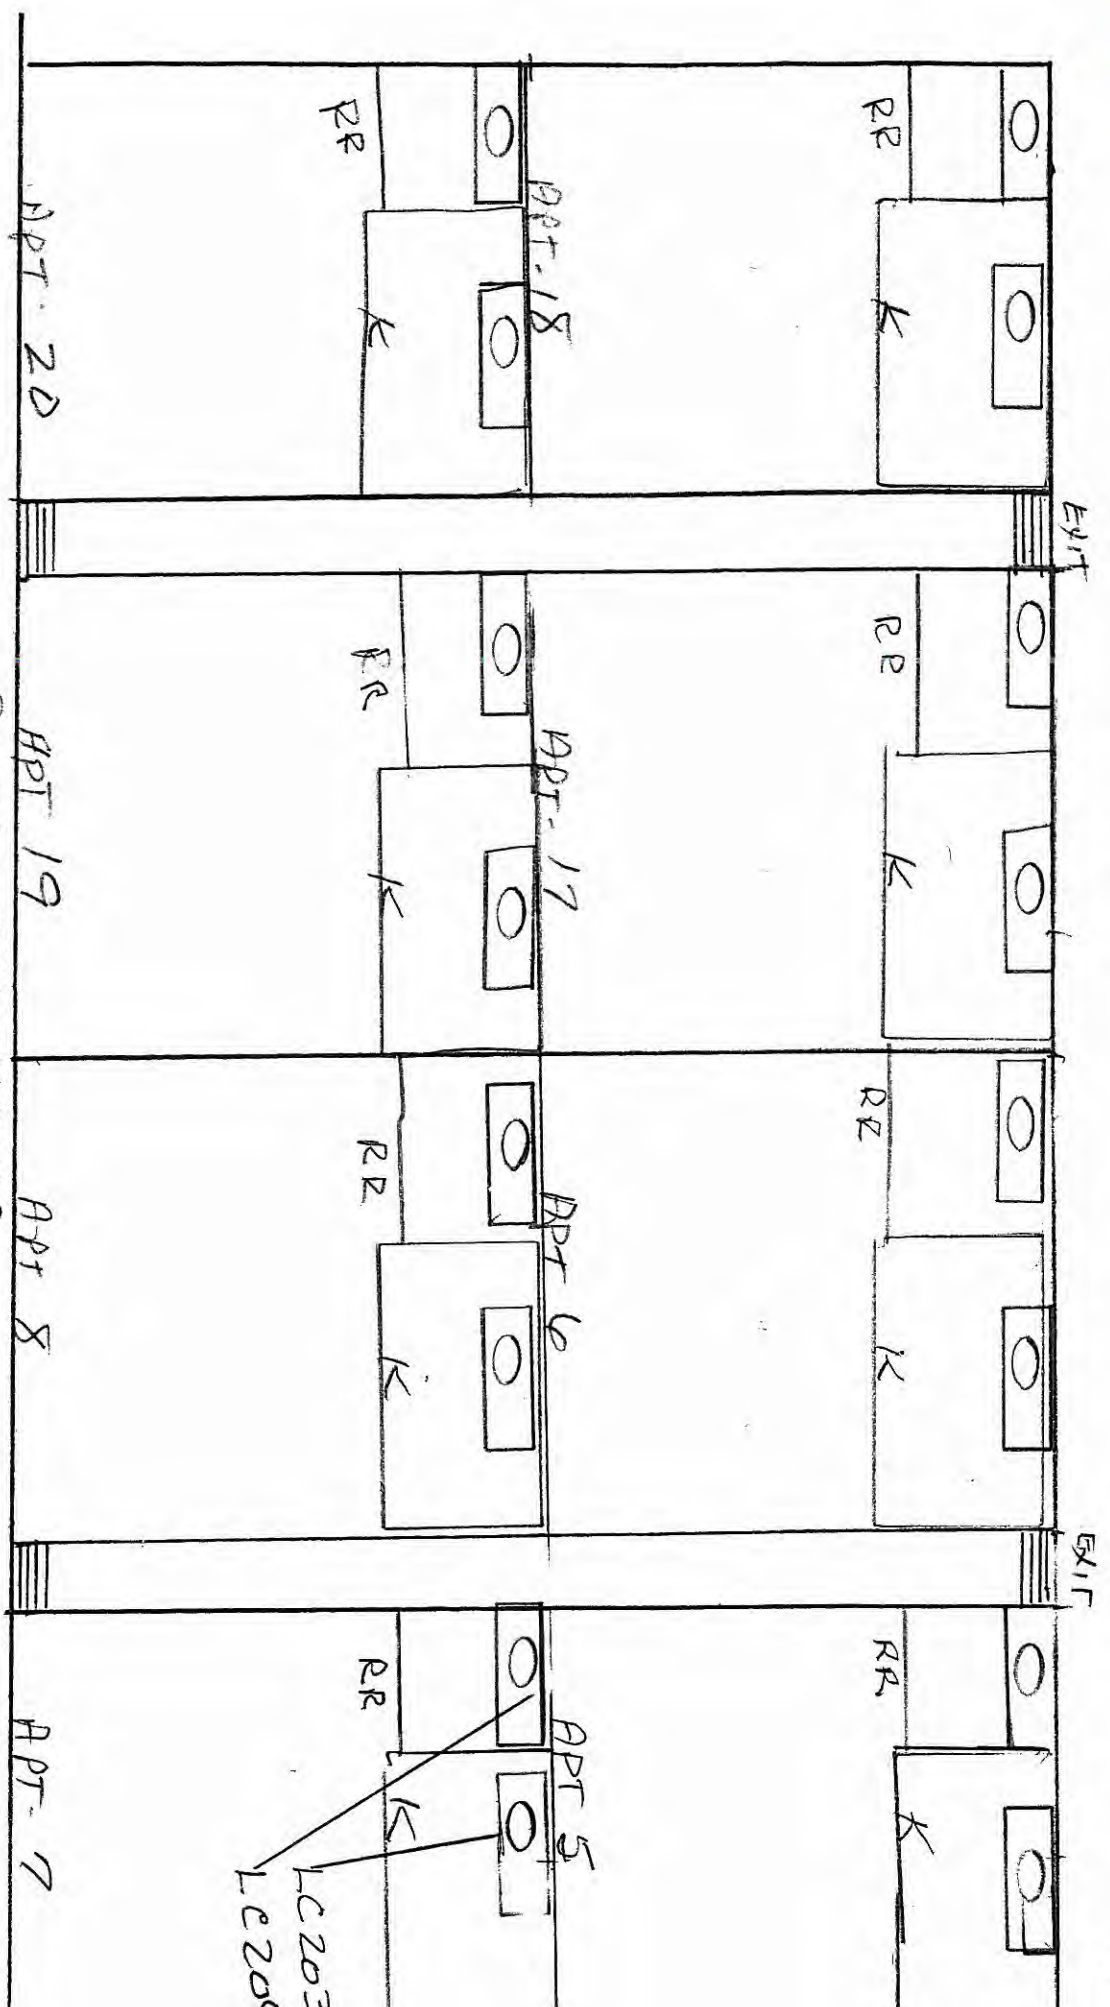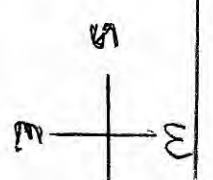

LC203
LC204

APT. 20
APT. 19
APT 8
APT. 7



DEVILLE APARTMENTS
4200 MIDDLEBAND AVE.
CAMDEN NJ 08105
330-492-0629

2
FLOOR

MAPPING Lead Plumbing + Fixture

- None Lead
- Other ----
- Lead

COPPER PIPING-FIXTURE MATERIAL UNKNOWN

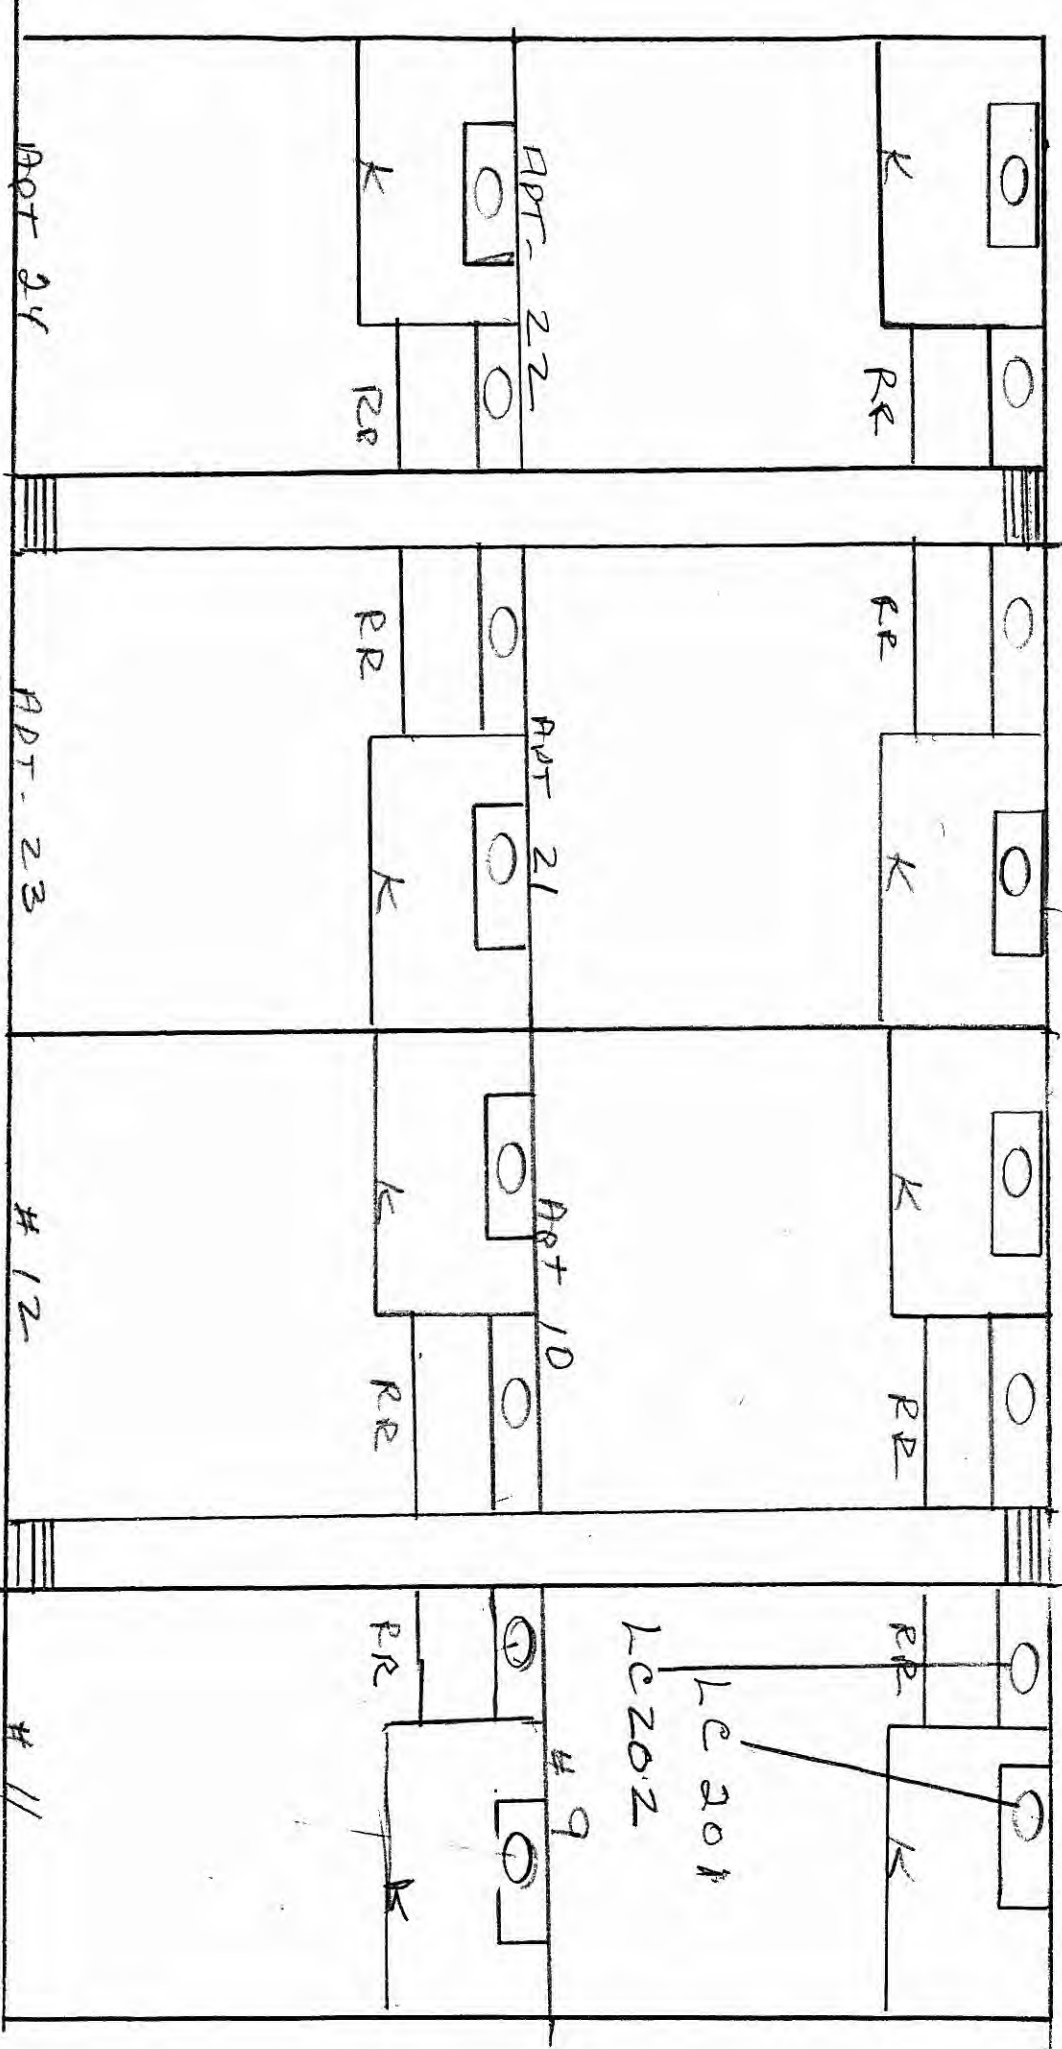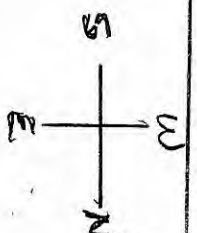

APT-24

APT-23

APT-22

APT-21

APT-10

#12

#11

DEVILLE APARTMENTS
4200 MIDDLEBROOK. RD
CANTON OH 44705
330-492-0629

3
FLOOR