

FEB 23 2017

1

OHIO EPA NEDO

Parcel Search

Parcel Search Tools

Find a Parcel Parcel Details

Search Parcels by: Parcel # 5001082

+ 5001081

Owest streetsboro 4340 W. Streetsboro

Search

Refine parcel search by graphic

Select Parcels by:

Grid of selection boxes

Search/Selection Results: 0

Clear

Mailing Labels

Parcel # Address Owner

OH 7741512
Richfield
United Church of
Christ

44286

Entity: Richfield United Church of Christ
Doc Type: Report
Doc Subtype:
Program: DRAGW
County: Summit
Secondary ID: OH 7741512
EPA in color

5001587

300.13
W STREETSBORO RD 247.5

Bldg A Built 1952
Lead solder used
in all potable piping
1st Floor

1 - Kitchen
2 - 2 Bathrooms + Janitor
Sink



2

Parcel Search

Parcel Search Tools

Find a Parcel Parcel Details

Search Parcels by: Parcel #

Lowest streetsboro

Search

Refine parcel search by graphic

Select Parcels by:




Search/Selection Results: 0

Clear

Mailing Labels

Parcel # Address Owner

5001587

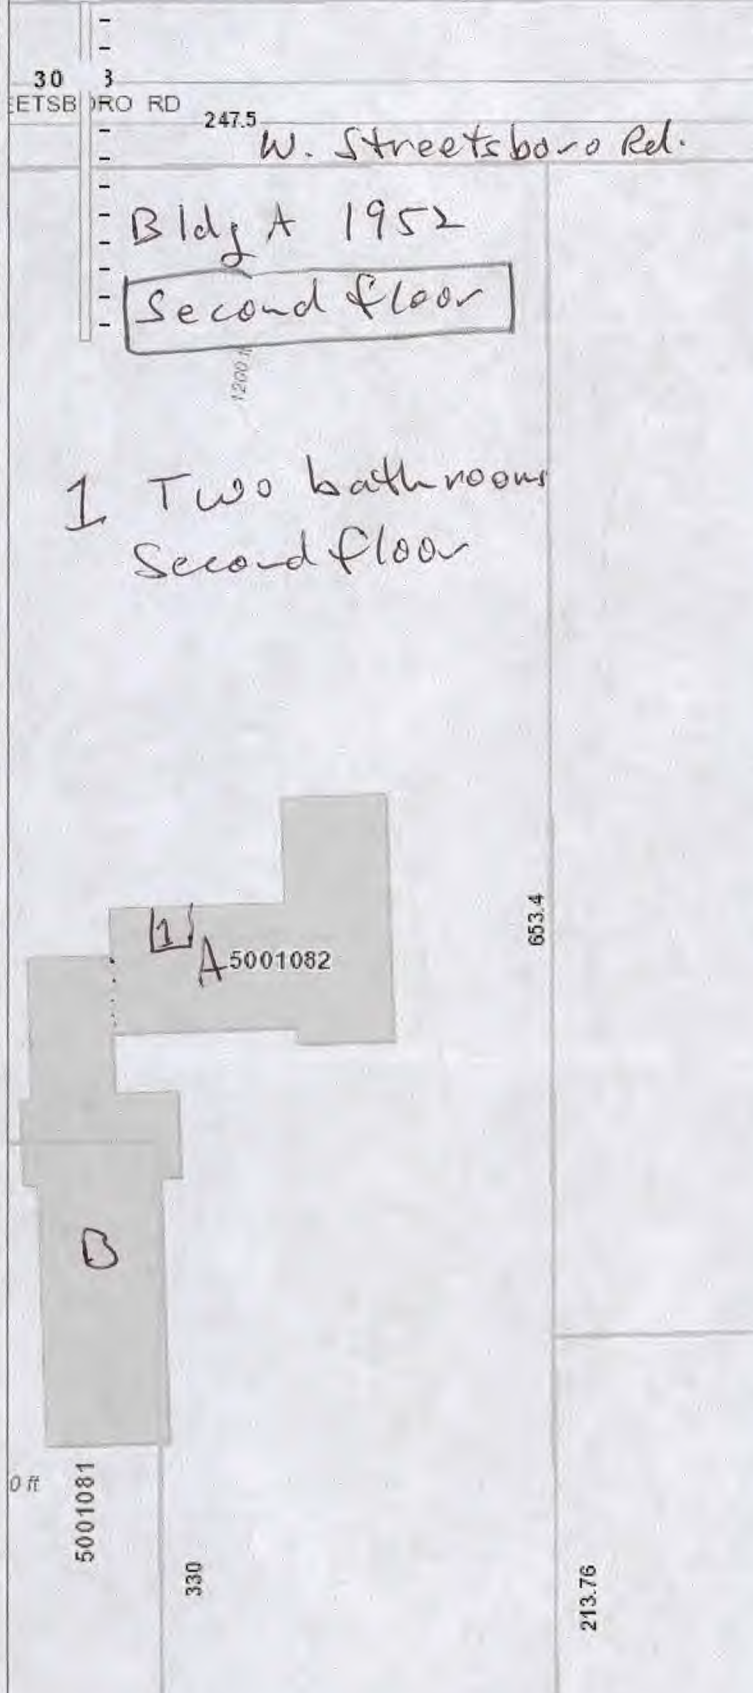

3

Parcel Search

Parcel Search Tools

Find a Parcel Parcel Details

Search Parcels by: Parcel #

Owest streetsboro

Search

Refine parcel search by graphic

Select Parcels by:



Search/Selection Results: 0

Clear

Mailing Labels


Parcel #	Address	Owner

5001587

300.13
ETSBORO RD 247.5 W. Streetsboro Rd.

Bldg B
Built 1962
Lead solder in all
locations

1 - Small kitchen
1 sink
2 - 1/2 bath
3 - Pump room
4 - 1/2 bath
5 - 1/2 bath

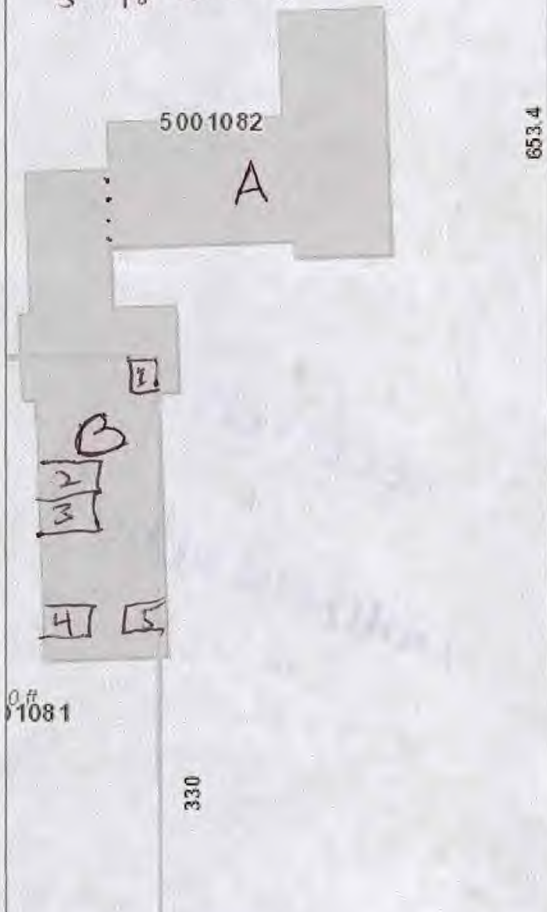

Note:

Pump room/boiler room has two water taps for janitor. Pressure tank and softener.