


FIRST FLOOR

Eagle Wings Academy  
 9100 Jacksonville Rd.  
 Jacksonville, OH 43030  
 Phone (740) 323-4063  
 PWSID - OH 4533512  
 School built 1918  
 Front East Wing built 1954

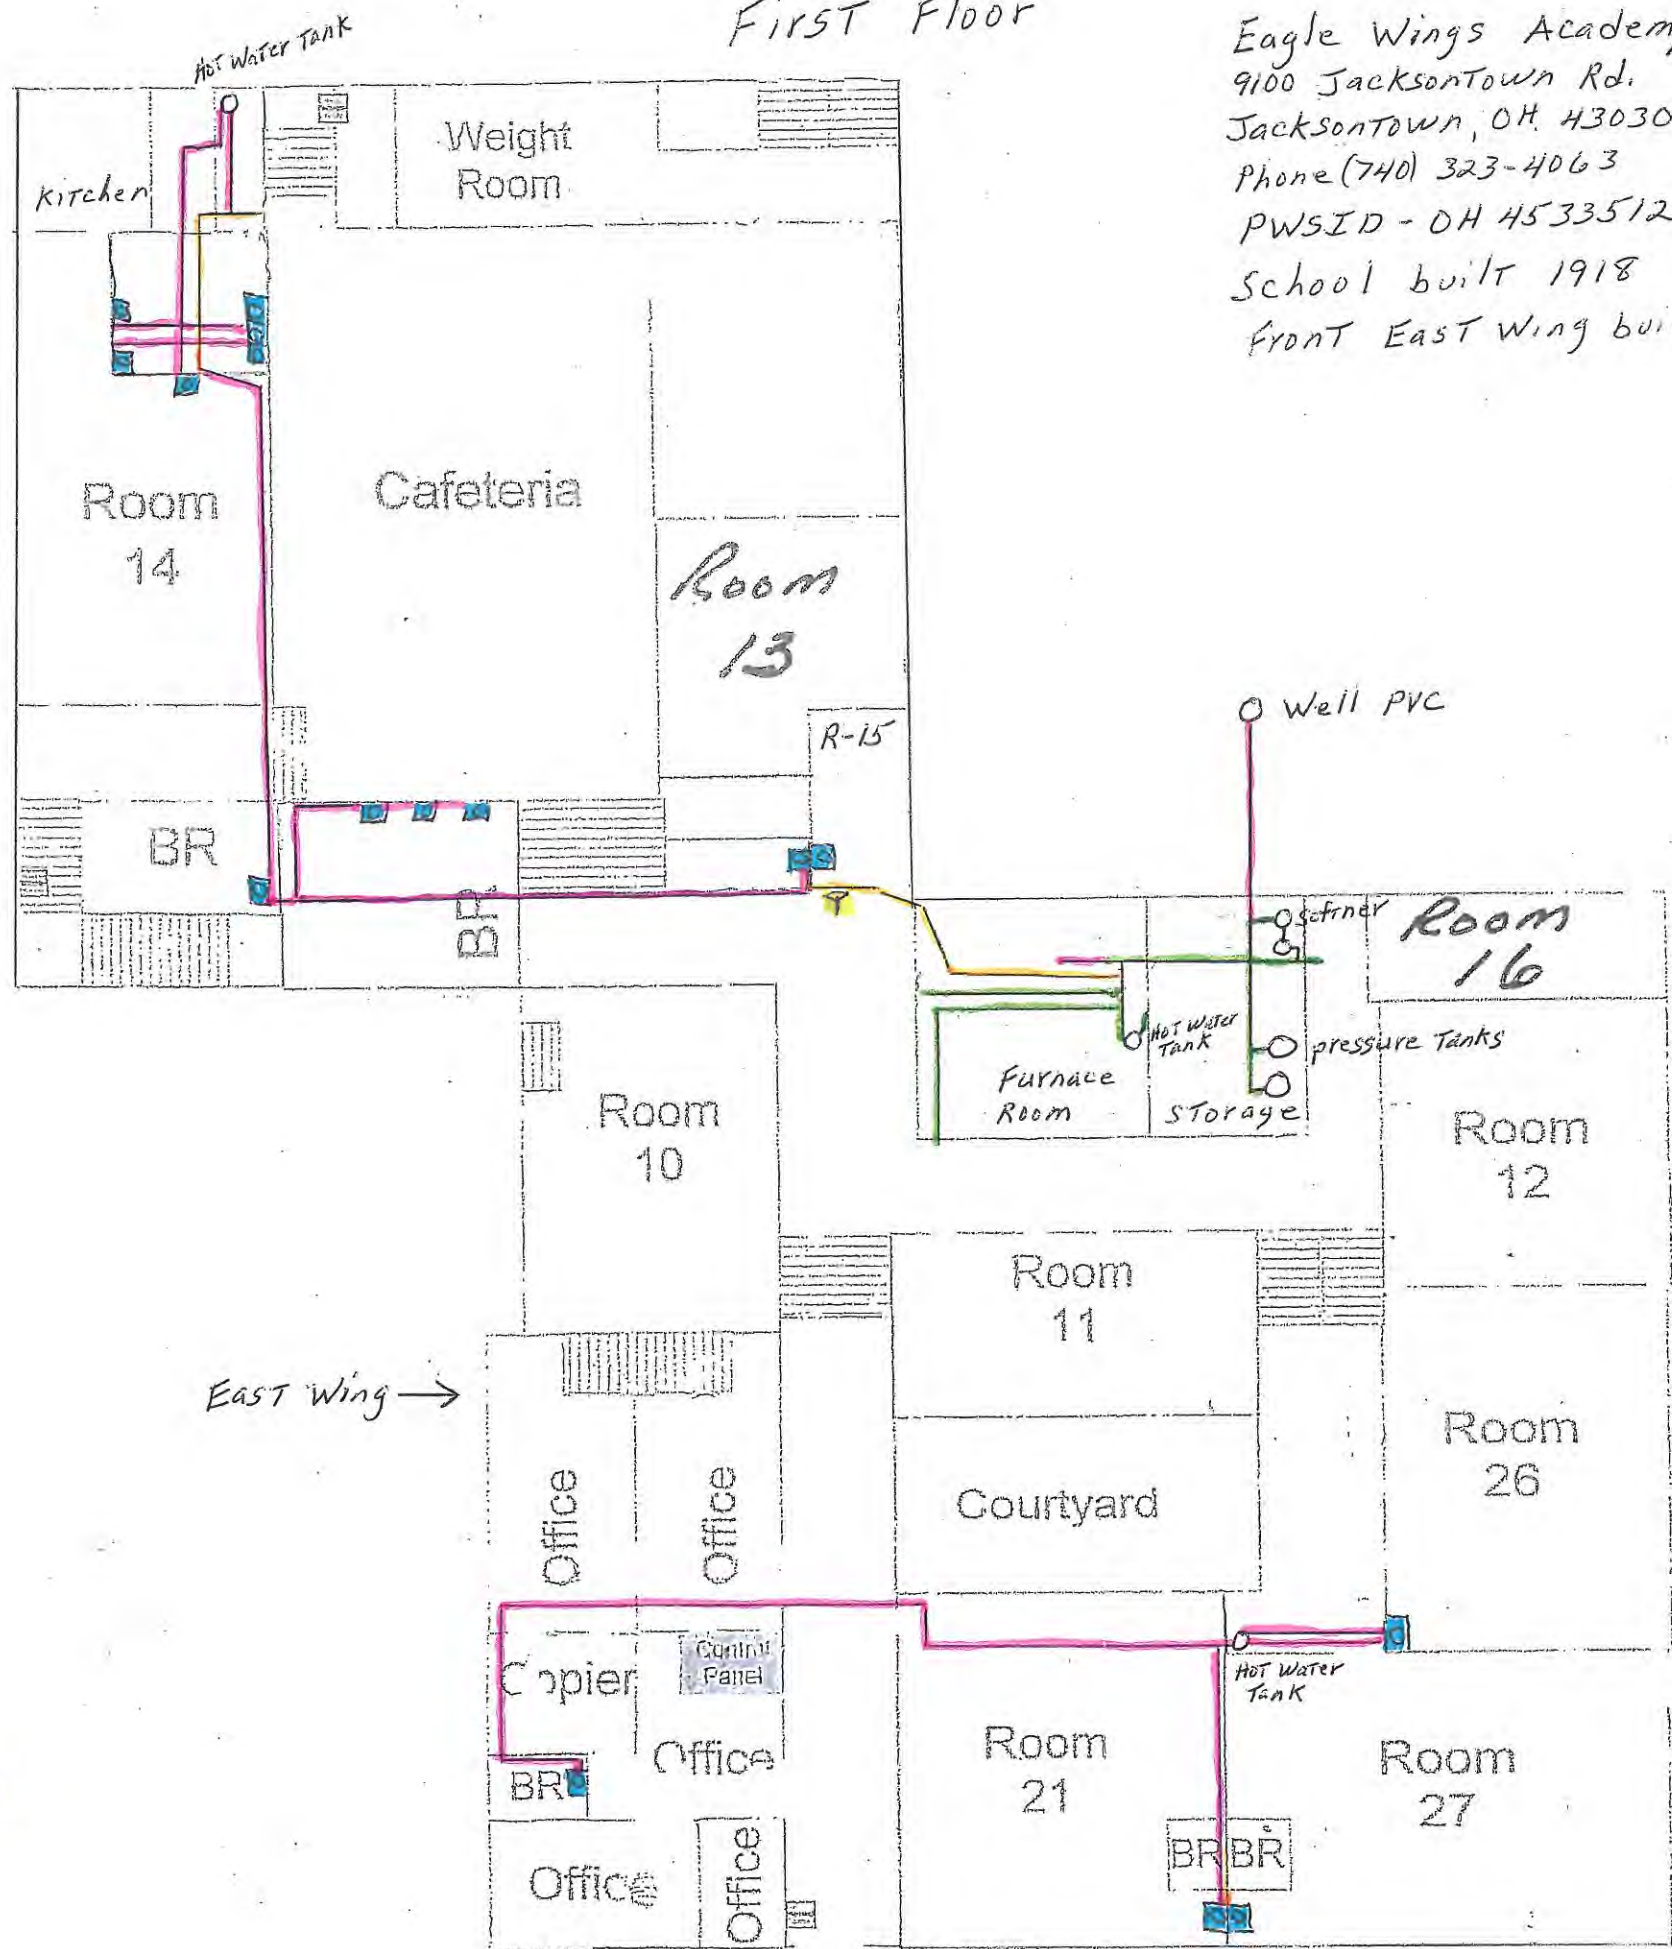

- Copper - ■
- Galvanized - ■
- Plastic - ■
- Unknown - ■
- Sink - ■
- Drinking Fountain - ▽
- Bath Room - BR



← East Wing

East Wing →

FRONT



Entity: Eagle Wings Academy  
 Doc Type: Report  
 Doc Subtype: \_\_\_\_\_  
 Program: Drinking Water  
 County: Licking County  
 Secondary ID: OH 4533512

Eagle Wings Academy

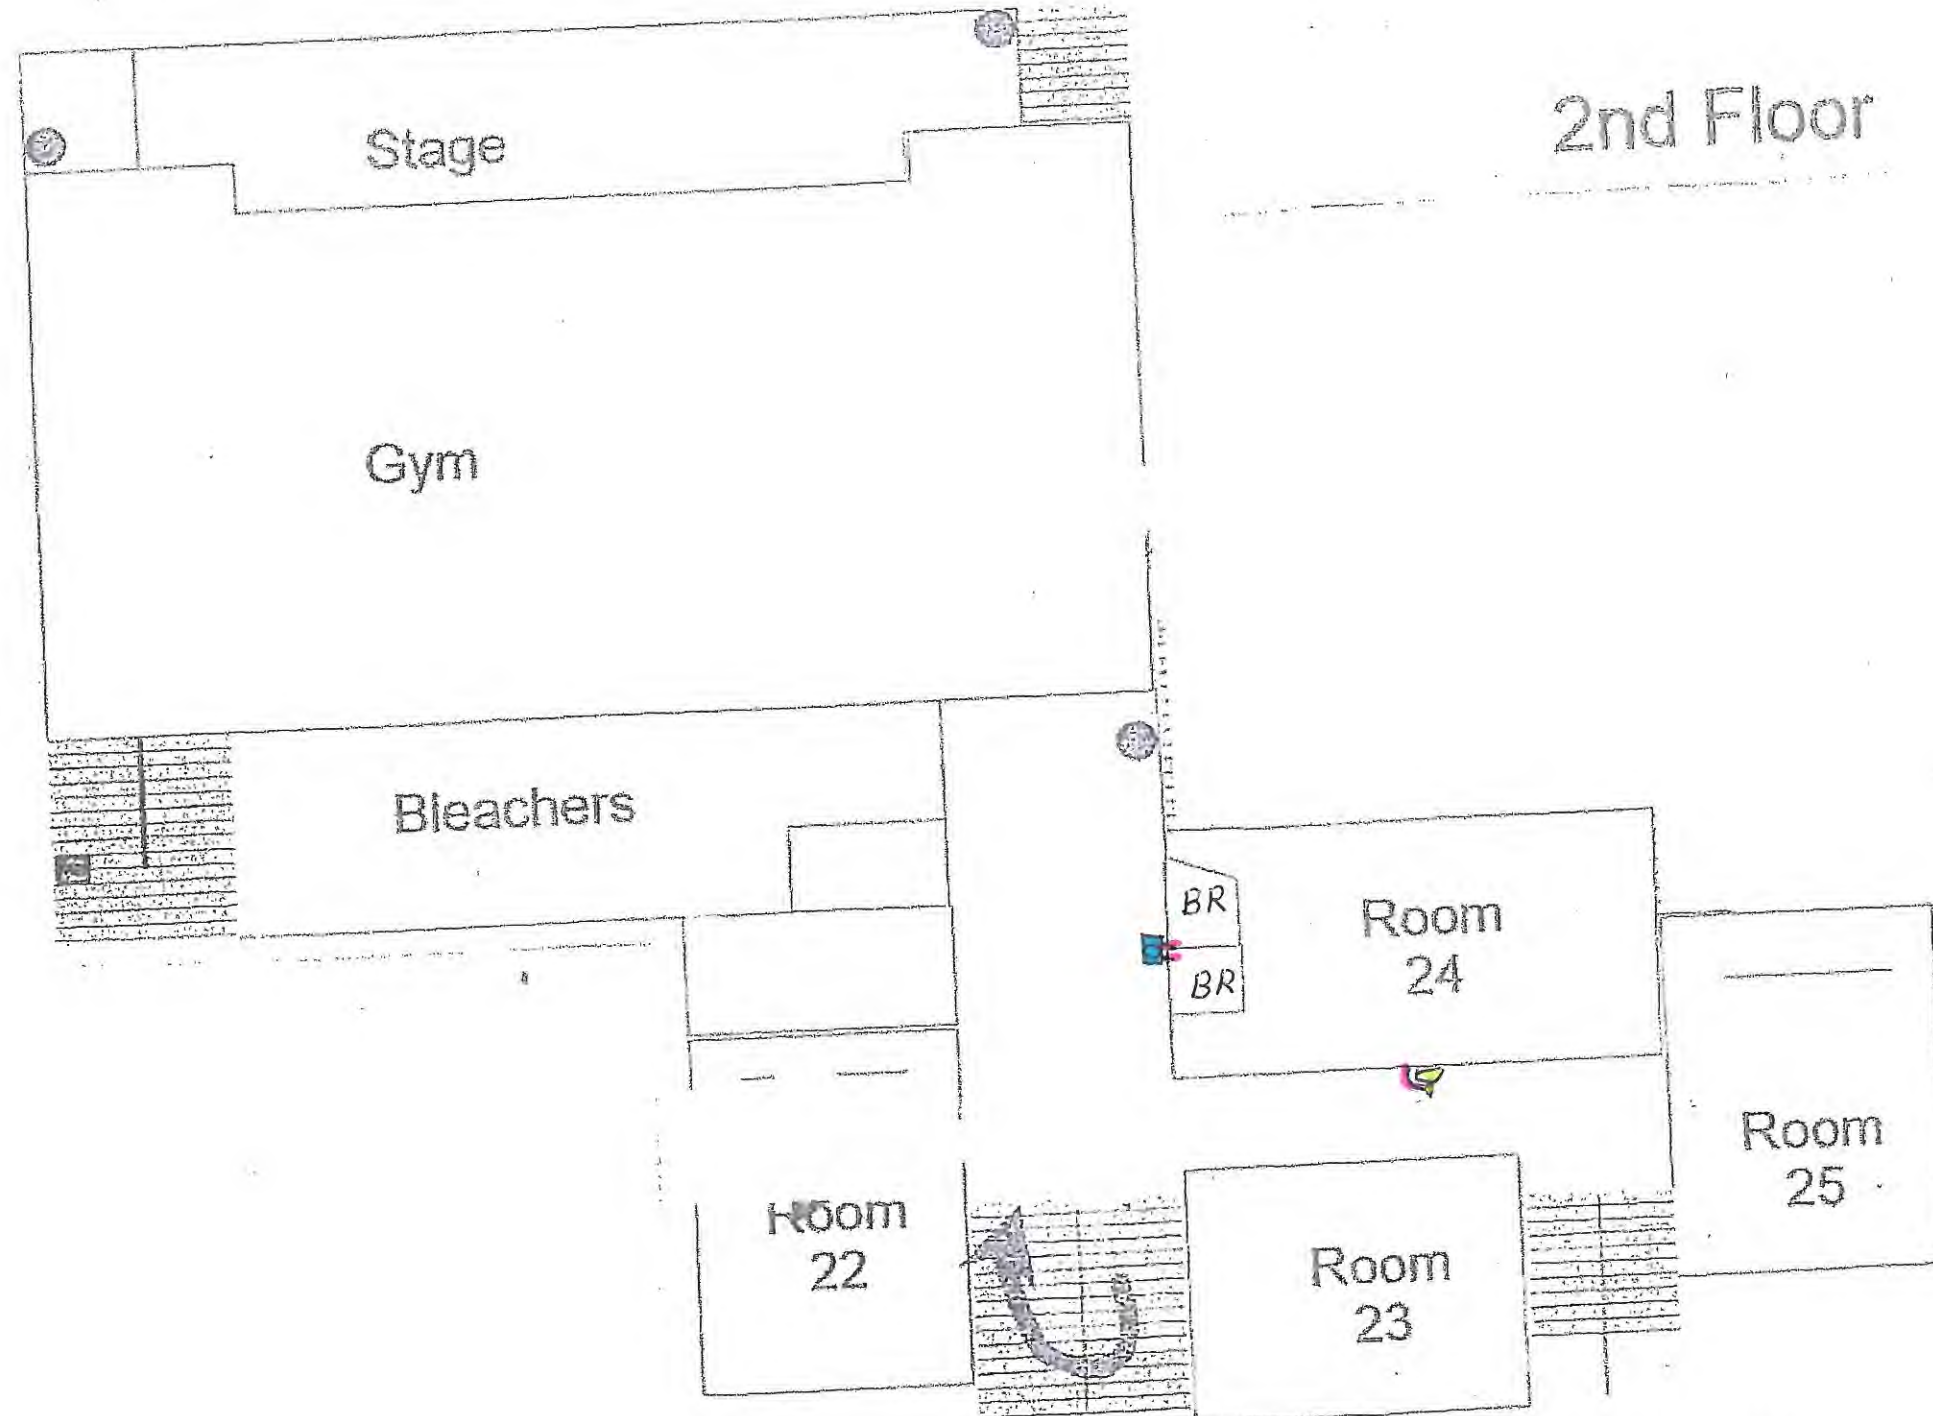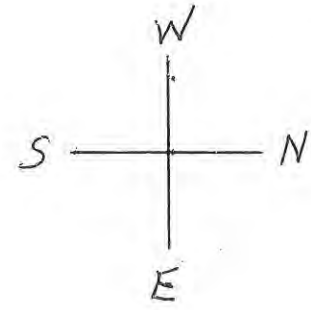



Eagle Wings Academy

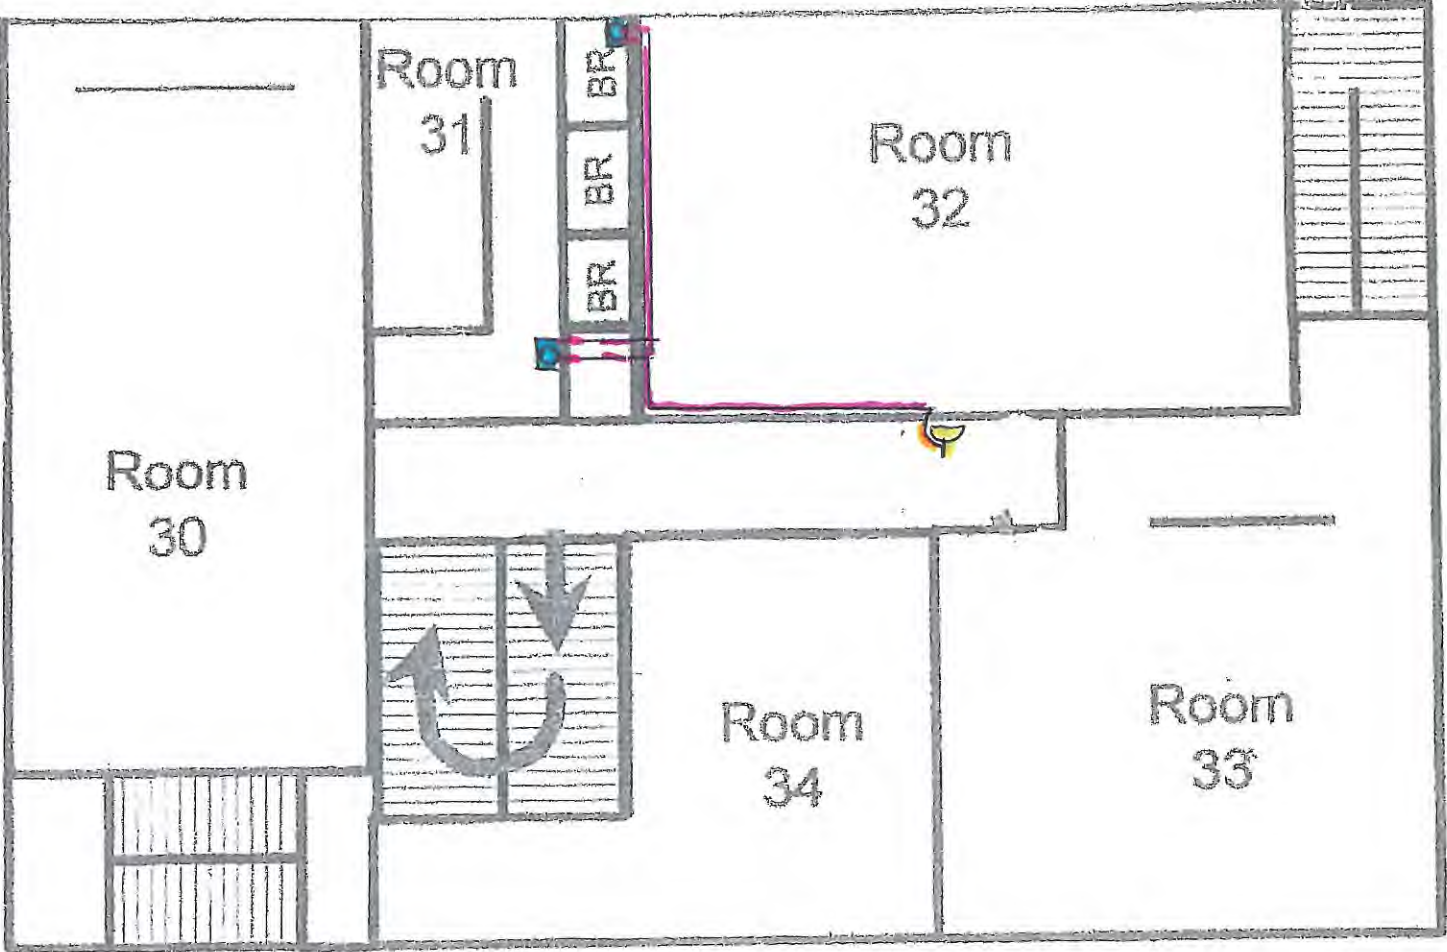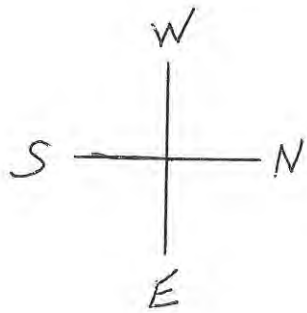

3rd Floor