

RE: Christ The Word Church
Report
Drinking Water Program
Lucas County
PWS ID: OH4846316


CHRIST THE WORD CHURCH

March 1, 2017

Mr. Tyson Turner
Assistant Pastor
Christ the Word Church
3100 Murd Road
Sylvania, OH 43560

To Whom It May Concern:

In response to the request for mapping of lead lines, Christ the Word Church (Lucas County, OH4846316), located at 3100 Murd Road, Sylvania, OH 43560, was constructed in 2012. Our only water service lines are from the well to the building. Our water lines are comprised of a mixture of copper and plastic piping materials. Our piping, solder, and fixtures were manufactured and installed after 1998 and do not contain lead. Please see the map below.

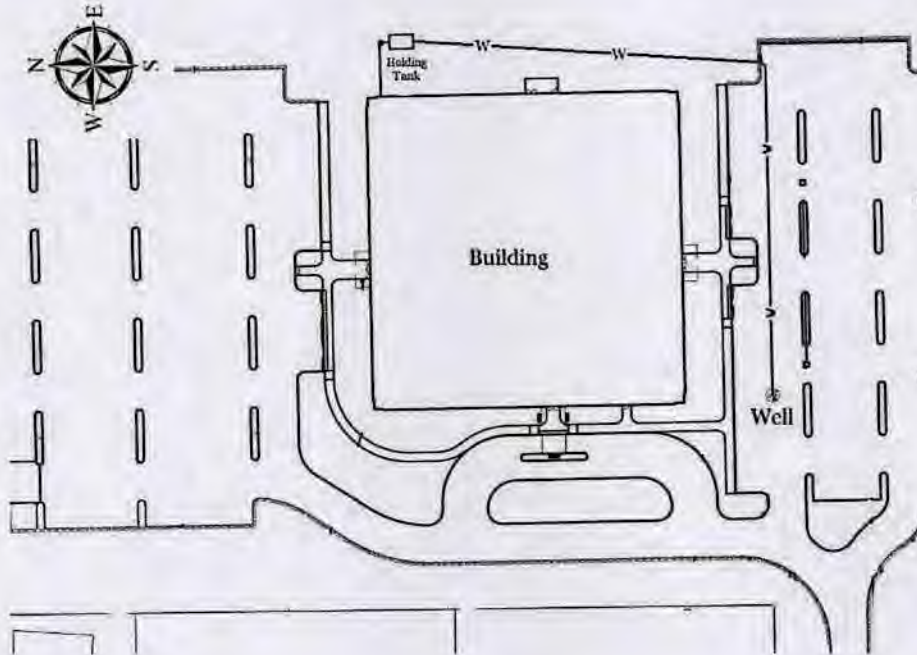

Best regards,

Tyson Turner
Assistant Pastor

RECEIVED

MAR 02 2017

DDAGW - NWDO

Revised