

RE: Ney Village Water
Report
Drinking Water Program
Defiance County
PWS ID: OH2000512



THE VILLAGE of NEY

P.O. BOX 237 • DEFIANCE COUNTY • NEY, OHIO 43549

RECEIVED

MAR 06 2017

OHIO E.P.A.
N.W.D.O.

March 2, 2017

Ohio EPA,

All service lines in the Village of Ney are PVC, originally built in 1974. The Fairview School water line was built in 1998, also PVC pipe. The pipe from the service lines to the meters inside the homes is mostly one inch plastic. The plumbing inside the private homes is not known. A not to scale map of the service lines is included.

Sincerely,

A handwritten signature in cursive script that reads "Tom Vance".

Mayor, Tom Vance

RECEIVED

MAR 06 2017

OHIO E.P.A.
N.W.D.O.

VERIFICATION FORM FOR COMMUNITY PUBLIC WATER SYSTEMS CLAIMING NO LEAD SERVICE LINES

The owner or operator of all community public water systems must identify and map areas of their distribution system that are known or are likely to contain lead service lines. Systems must submit a copy of the applicable map to the Ohio Department of Health and the Ohio Department of Job and Family Services. Systems must also submit a report to the director containing at least both of the following: (1) The applicable map with narrative, and (2) A list of sampling locations used to collect samples as required by Ohio Revised Code (ORC) Section 6109.121 and any rules adopted thereunder, including contact information for the owner and occupant of each sampling site.

Should a water system determine no lead service lines exist in their distribution system, they must provide information stating they reviewed, at the minimum, historical permit records and local ordinances, distribution maintenance records and information pertaining to installation dates or materials for all services lines. This information must be verified below.

I HEREBY CERTIFY THAT THE FOLLOWING METHOD(S) WERE USED TO DETERMINE NO LEAD SERVICE LINES EXIST IN THIS WATER SYSTEM'S DISTRIBUTION SYSTEM, AS REQUIRED BY ORC 6109.121(F):

LEAD SERVICE LINE VERIFICATION	
This PWS states they have no lead service lines and has reviewed the following information (select one or more of the following):	
<input checked="" type="checkbox"/>	Historical permit records and/or local ordinances
<input type="checkbox"/>	Distribution maintenance records (i.e. meter replacement, waterline break repairs)
<input checked="" type="checkbox"/>	Information pertaining to installation dates for all service lines (i.e. after 1986 when lead services lines were banned)
<input checked="" type="checkbox"/>	Service line material of all service lines is known (i.e. all service lines are known to be PVC)



3-2-17

Signature of Responsible Person

Date

PWS NAME: Ney Village Water Sys.

PWS ID: OH 2000512

COUNTY: DeLancey

Tom R Vance Mayor

Printed Name and Title of Responsible Person

For Ohio EPA use only:

Date Verification Rec'd: _____

May water system service line S

Wells

Coyle Rd

Traver

Fairview High School
1998
line built


Buildings in Ohio built prior to 1998 or that use plumbing material or solder manufactured before 1998 may have materials with greater than 8% lead and are at a higher risk of contributing lead to the drinking water than materials manufactured after 1998. In addition, buildings built and plumbing materials manufactured after 2014 were required to have less than 0.25% lead by weight and have the lowest risk for contributing lead to the drinking water. It should be noted however that, although prohibited, some use of leaded solder or leaded components may have occurred after the prohibitions became effective.

VILLAGE OF N PROPERTY NUMBE

DENNIS M. BELL, P.E., P.S. COUNTY

REVISIONS			
FEB	3	1970	
JUNE	11	1970	
DEC	1	1971	
JUNE	3	1973	
DEC	6	1977	

SCALE 1" = 200'

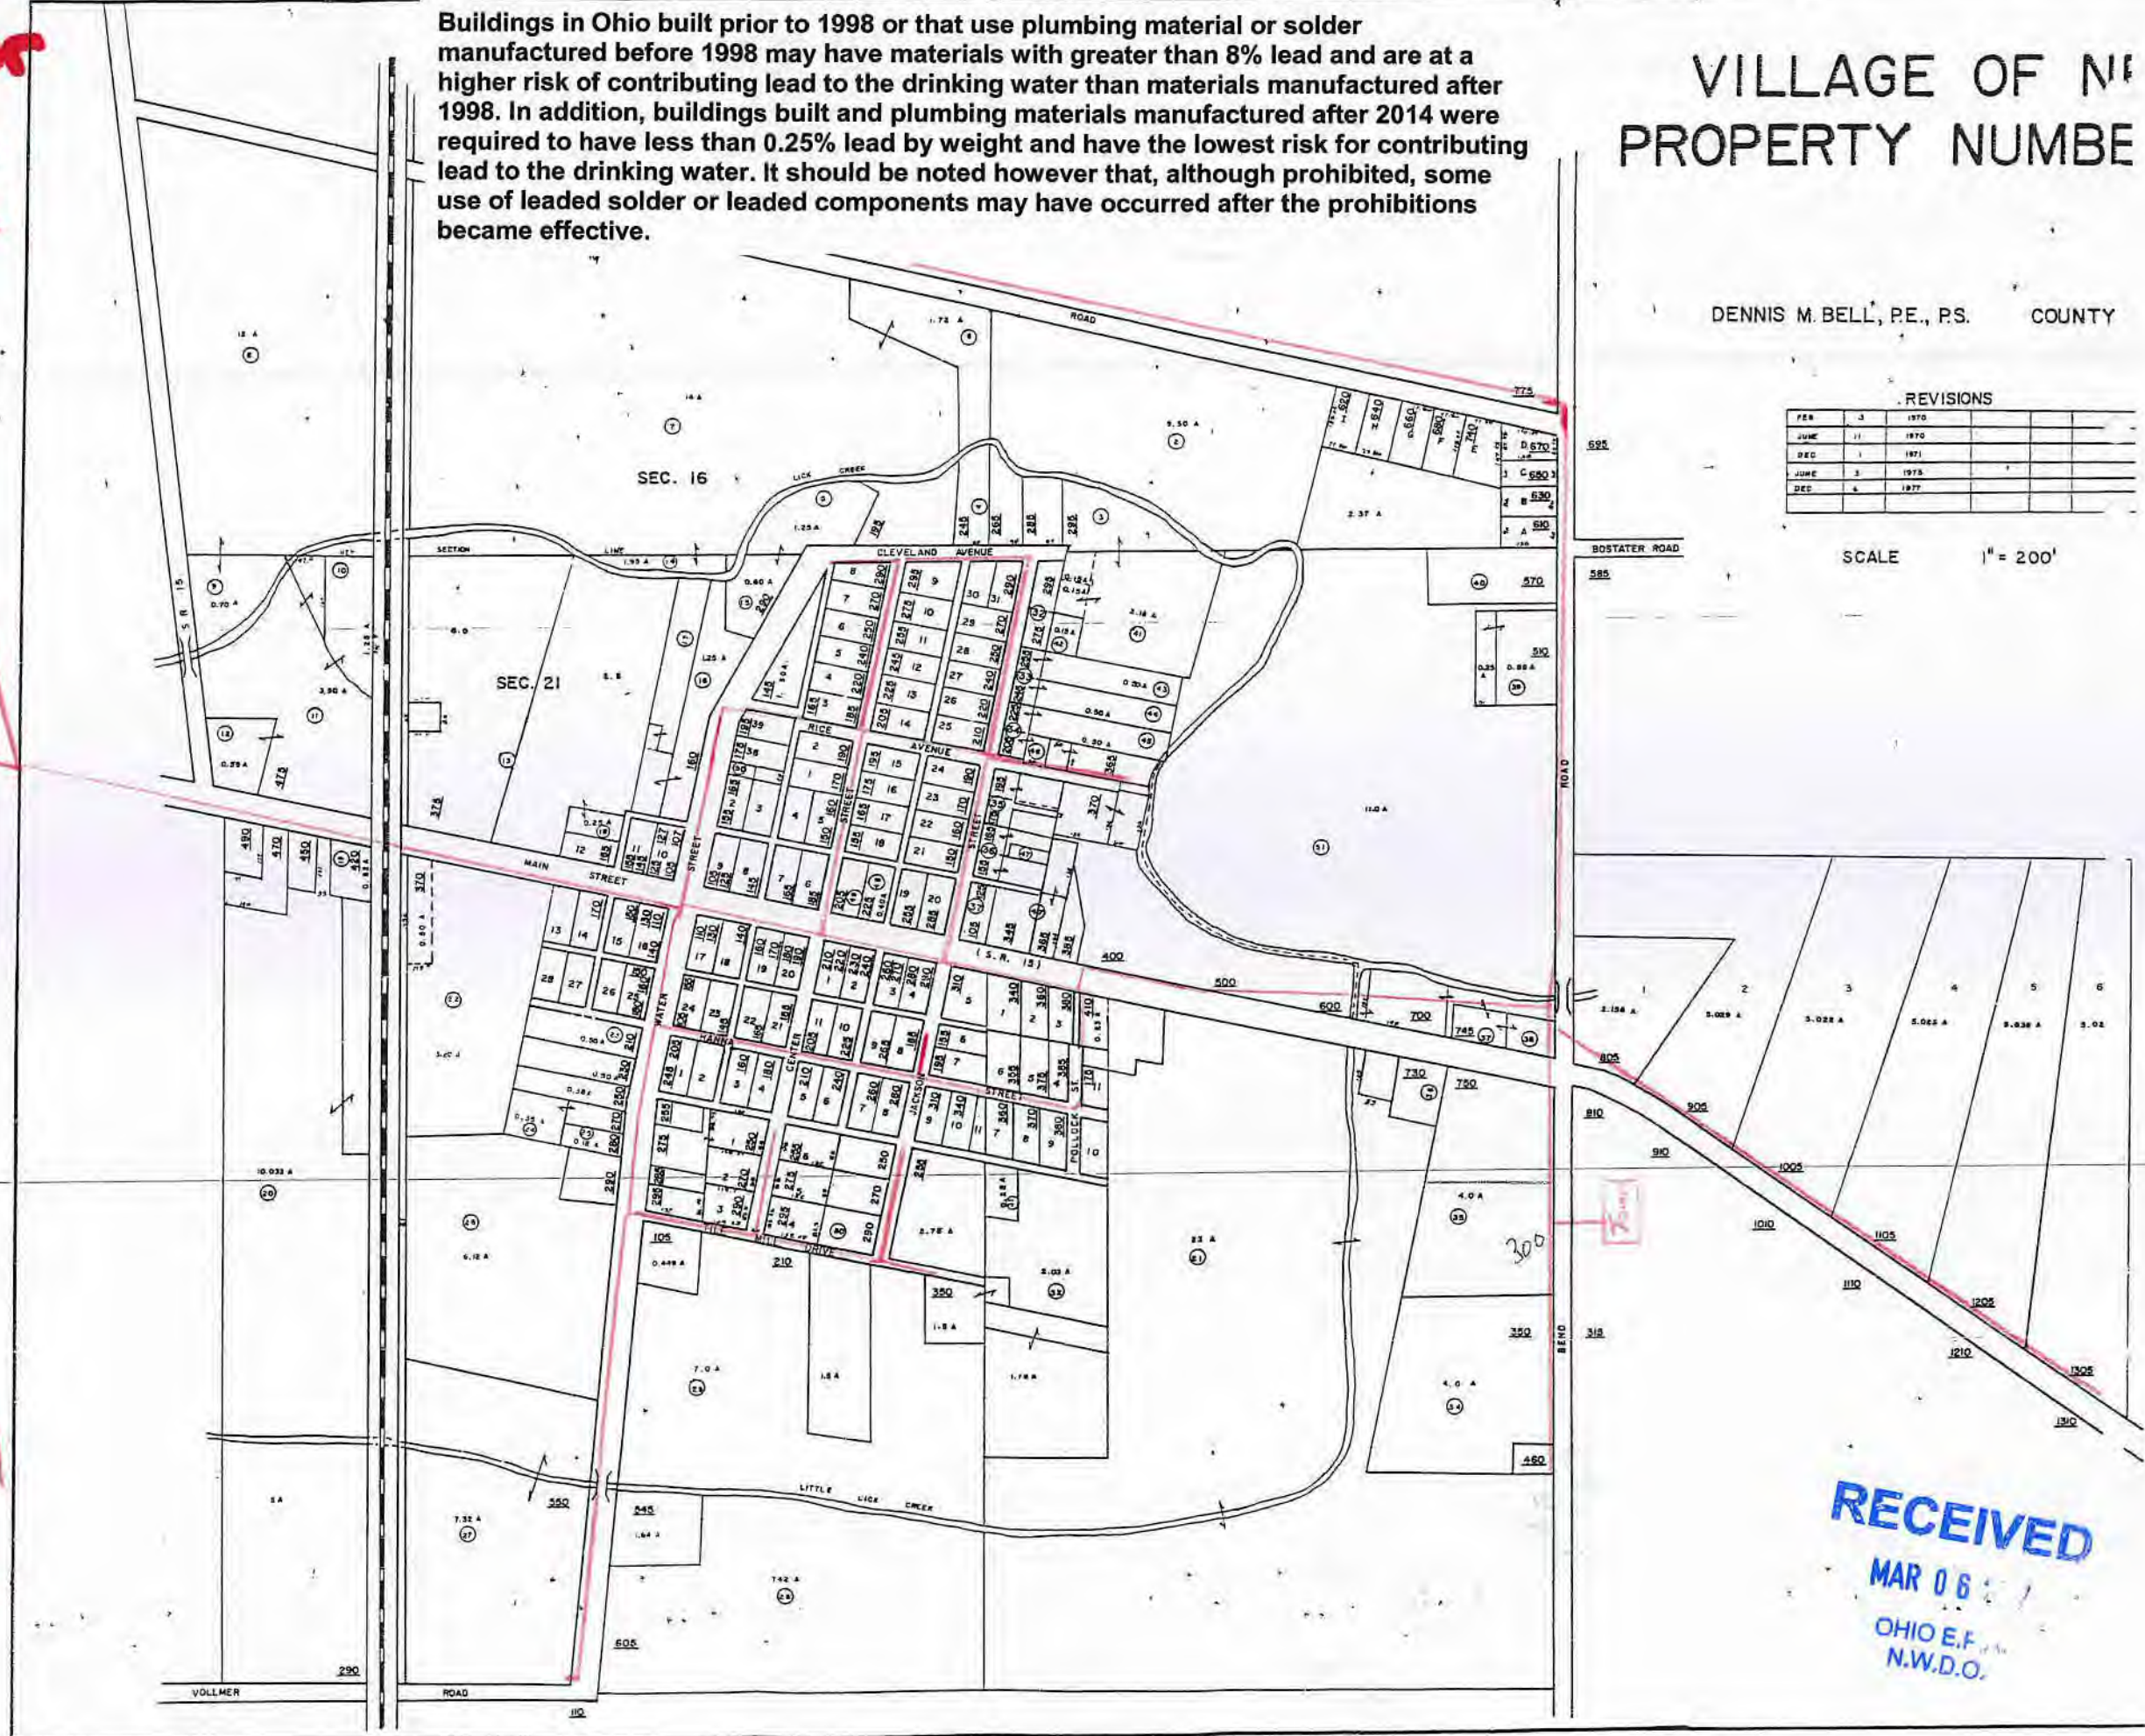

RECEIVED
MAR 06
OHIO E.F.
N.W.D.O.